


NARRATIVE: This survey was performed at the request of the Grant County Court. The purpose of this survey was to mark the corners of the two tracts of land which Merle Weissenfluh intends to lease to the county, as shown hereon. A search was made of the available records pertaining to this survey. Field measurements were made to locate existing monuments. New monuments were set at locations approved by Mr. Weissenfluh and the County Court, as shown hereon. This survey is tied to the remonumented Initial Point of the LCI Addition, which point is identical with the west 1/4 corner of Sec. 10, T.10 S., R.30 E., as said corner is described on the recorded plat of said LCI Addition, dated August 3, 1892.

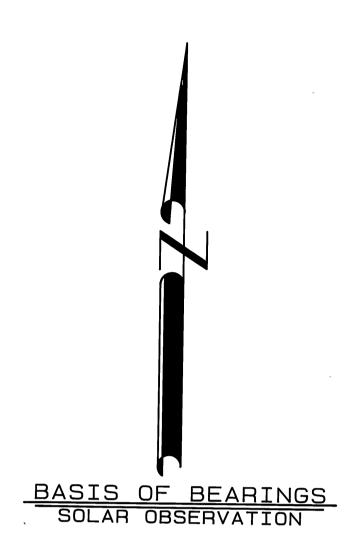

LEGEND

- Found 5/8" iron pin, from Record Survey No.1143.
- O Set 5/8"x 30" iron pin with attached aluminum cap marked BGA SURVEY MARKER.

x----xFence line.

() Record bearing and distance.

REFERENCES

Record Map of Survey No.1143

Deed Records Book 99 Page 520-521

Instrument No. 900773 Deeds 900774 Deeds 900775 Deeds

Scale: 1"=50'

NOTE: We drove 6 ft. long galvanized steel fence posts alongside each set pin.

PECEIVED AND
FILED
Oct 3,990

OFFICE OF COUNTY SURVEYOR

Short D. Bagette

ATTEST: Carel Lagt, Co. Clerk

REGISTERED
PROFESSIONAL
LAND SURVEYOR

OREGON
JULY 12, 1963
ROBERT D. BAGETT
598

BAGETT - GRIFFITH & ASSOCIATES

John Day , Oregon

MAP OF SURVEY

OF TRACTS OF LAND SITUATED IN THE SE1/4NW1/4 SECTION 10. T10S. R30E, WM TOWN OF LONG CREEK FOR LEASE PURPOSES

GRANT COUNTY, OREGON

SURVEYED FOR GRANT CO. ROAD DEPARTMENT

SURVEYED BY R.D.B. & J.L.W. & G.J.R. 10/1/1990

Drawn by: J.L.W.