

SEE RECORDS OF CORNER MONUMENTATION FILED IN THE OFFICE OF THE GRANT COUNTY SURVEYOR FOR MORE DETAILS ON THE CORNERS I SET AND THEIR ACCESSORIES.

(●) FOUND $1\frac{1}{2}$ " GALV. IRON PIPE WITH ATTACHED
 GRANT COUNTY SURVEYOR BRASS CAP

 ● FOUND 5/8" IRON PIN WITH ATTACHED YELLOW
 PLASTIC CAP MARKED "LS2527" FROM SURVEY NO. 1924

 (●) FOUND RECORD SURVEY MONUMENT AS SHOWN

 (○) SET 5/8"x30" IRON PIN WITH ATTACHED $3\frac{1}{2}$ " ALUMINUM
 CAP MARKED "BENCHMARK LAND SURVEYING" AND WITH
 APPROPRIATE CORNER DESIGNATIONS

 ○ SET 5/8"x30" IRON PIN WITH ATTACHED $1\frac{1}{2}$ " ALUMINUM
 CAP MARKED "BENCHMARK LAND SURVEYING" AND WITH
 APPROPRIATE CORNER DESIGNATIONS

 () DEED RECORD BEARING AND DISTANCE

 G() GLO RECORD BEARING AND DISTANCE

 W() RECORD BEARING AND DISTANCE FROM SURVEY NO. 25W

 [] RECORD BEARING AND DISTANCE FROM SURVEY NO. 673
 1[] RECORD BEARING AND DISTANCE FROM SURVEY NO. 774
 2[] RECORD BEARING AND DISTANCE FROM SURVEY NO. 1322
 3[] RECORD BEARING AND DISTANCE FROM SURVEY NO. 1544
 4[] RECORD BEARING AND DISTANCE FROM SURVEY NO. 1860
 5[] RECORD BEARING AND DISTANCE FROM SURVEY NO. 1869
 6[] RECORD BEARING AND DISTANCE FROM SURVEY NO. 1924
 7[] RECORD BEARING AND DISTANCE FROM PARTITION PLAT NO. 99-15
 8[] RECORD BEARING AND DISTANCE FROM SURVEY NO. 304

 □ FOUND MONUMENT FROM RECORDED SURVEY NO.

 X—X FENCE LINE

RECORD MAP OF SURVEY NO.'S 25W, 53W, 304, 673, 774, 1322, 1544, 1660,
1869 & 1924

LAND PARTITION PLAT NO. 99-15


OREGON STATE HIGHWAY DEPT. MAP NO. 7B-16-21

GENERAL LAND OFFICE (GLO) FIELD NOTES

GRANT COUNTY RECORDS OF CORNER MONUMENTATION

DEED RECORD BOOK 43 PAGE 142
BOOK 68 PAGE 368


DEED RECORD INSTRUMENT NO.'S 951196, 972469, 221142 & 20131142

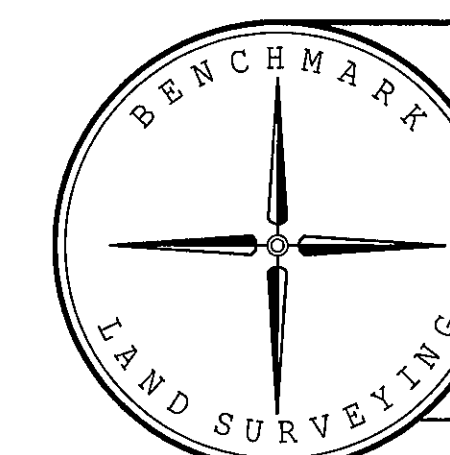

BENCHMARK LAND SURVEYING
217 N. CANYON EVD. JOHN DAY, OREGON
2101 MAIN STREET, SUITE 223 BAKER CITY, OREGON
541-575-1251 - 800-699-0516

MAP OF SURVEY
DEPENDANT RESERVE AND SUBDIVISION OF SECTIONS 19 & 30,
T.15S., R.31E., W.4
GRANT COUNTY, OREGON

SURVEYED FOR	JOHN MORRIS		
SURVEYED BY	MCS & NNS		8/5/2015
SCALE: 1"=500'	DRAWN BY: MCS		

RECEIVED AND FILED
GRANT COUNTY SURVEYOR
AUG 7 2015
BY: 

REGISTERED
PROFESSIONAL
LAND SURVEYOR

[Signature]

OREGON
JULY 9, 2002
MICHAEL C. SPRINGER
#70918

EXPIRES: 6/30/2016

RECORD MAP OF SURVEY NO. 2037