NARRATIVE


THIS SURVEY WAS EXECUTED FOR THE PURPOSE OF REESTABLISHING THE OBLITERATED MONUMENT AT THE N1/4 CORNER OF SECTION 5, T 13S, R.27E., W.M. DURING THE COURSE OF A CORNER MAINTENANCE SURVEY, WE FOUND THIS IRON PIPE MONUMENT DISTURBED

THE N1/4 CORNER WAS ORIGINALLY SET BY JOHN B. DAVID, U.S. DEPUTY SURVEYOR FOR THE GENERAL LAND OFFICE UNDER CONTRACT NO 131, DATED JUNE 8, 1869. IN 1914, COUNTY SURVEYOR VERNON GLAZE PERPETUATED THIS CORNER POSITION BY SETTING AN IRON PIPE WITH ATTACHED BRASS CAP. AS WAS COMMON PRACTICE FOR BOTH SURVEYS, NO CORNER ACCESSORIES WERE SET FOR THIS CORNER

IN NOVEMBER 2005, JACK WATSON LOCATED THIS CORNER AS PART OF RECORD SURVEY NO. 1745 HIS MAP SHOWS THE RELATIONSHIPS BETWEEN THE SUBJECT CORNER AND THE FOUND MONUMENT AT THE NORTHEAST CORNER AND THE MONUMENT HE SET AT THE S1/4 CORNER OF SAID SECTION 5.

UPON OUR INITIAL VISIT TO THIS CORNER, WE FOUND IT BENT TO NEARLY 90 DEGREES AND LYING FLUSH WITH THE GROUND. TO REESTABLISH THIS CORNER IN ITS POSITION AS REPORTED ON RECORD MAP OF SURVEY NO. 1745, WE USED A DISTANCE-DISTANCE INTERSECTION UTILIZING THE RECORD DISTANCES FROM THE FOUND MONUMENTS AT THE NORTHEAST CORNER AND \$1/4 CORNER OF SECTION 5, AS SHOWN HEREON.

I HAVE FILED RECORDS OF LAND CORNER MONUMENTATION SHEETS FOR EACH OF THE CORNERS SHOWN HEREON. THE MONUMENTATION SHEETS DESCRIBE IN DETAIL THE CONDITION OF EACH MONUMENT AND ACCESSORIES FOUND OR SET AS PART OF THIS SURVEY

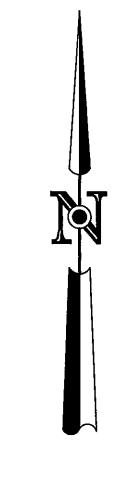

THIS CORNER WAS NOT RECOVERED DURING THE COURSE OF THIS SURVEY

G(WEST 2640)


[S89*01'22"W 2629.14]

BASIS OF BEARINGS

RECORD MAP OF SURVEY 1745 AS SHOWN

LEGEND

- SET 1½" GALV. IRON PIPE WITH ATTACHED 2" BRASS CAP MARKED GRANT COUNTY SURVEYOR
- FOUND 5/8" IRON PIN WITH ATTACHED 2" ALUMINUM CAP FROM SURVEY NO. 1745
- FOUND 3" ALUMINUM PIPE WITH ATTACHED 3½" ALUM. CAP FROM SURVEY NO. 1745
- FOUND 1" IRON PIPE WITH ATTACHED 2" BRASS CAP MARKED WITH TYPICAL GLAZE MARKINGS FROM SURVEY 7G
- G() GLO RECORD BEARING AND DISTANCE
- () RECORD BEARING AND DISTANCE FROM GLAZE SURVEY 7G
- [] RECORD BEARING AND DISTANCE FROM MAP OF SURVEY 1745

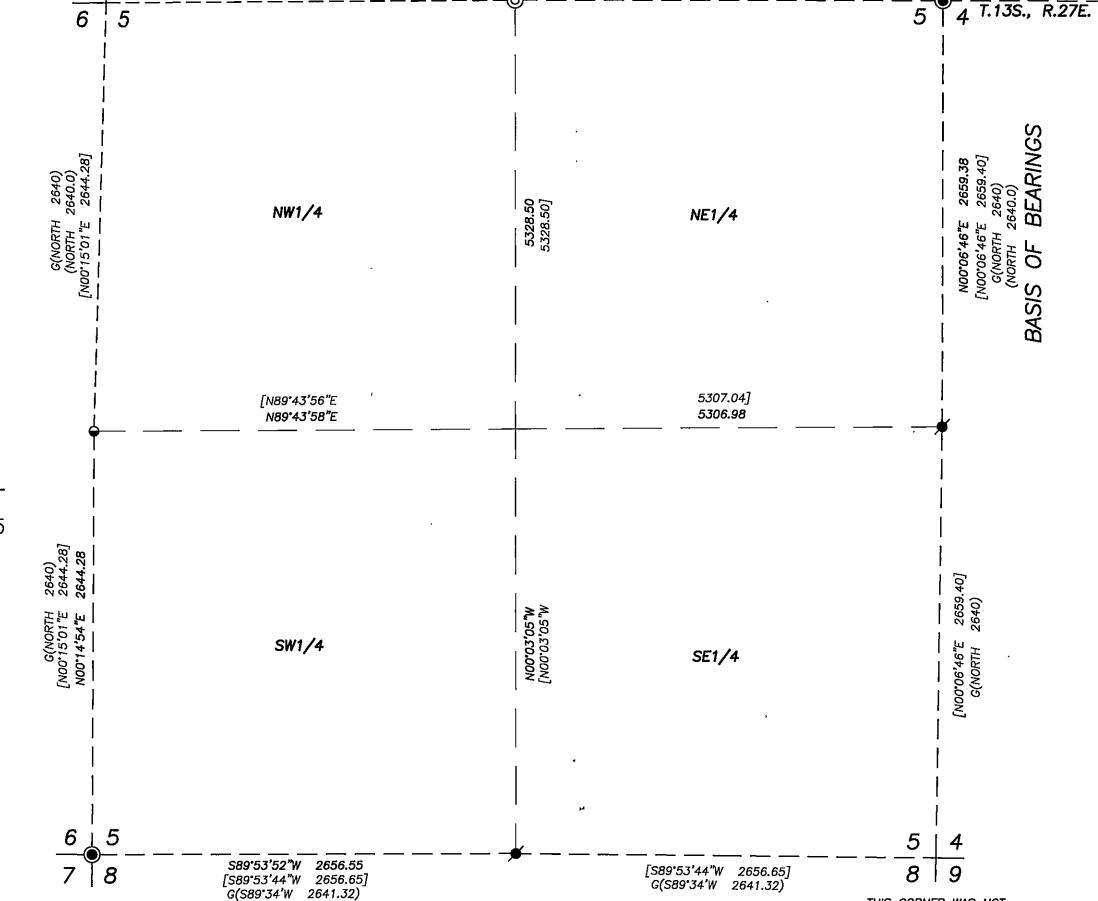

(WEST 2640.0)

[N89°53'43"W 2671.89]

N89'53'46"W 2671.89

REFERENCES

RECORD MAP OF SURVEY NO.'S: 7G, 152, 640, 1745 & 2017 GLO FIELD NOTES

REGISTERED
PROFESSIONAL
LAND SURVEYOR

OREGON
JULY 9, 2002
MICHAEL C. SPRINGER

#70918

EXPIRES: 6/30/2018

RECEIVED AND FILED GRANT COUNTY SURVEYOR

FEB 3 2017

BY:

GRANT COUNTY SURVEYOR
217 N. CANYON BLVD.
JOHN DAY, OREGON 97845

THIS CORNER WAS NOT RECOVERED DURING THE COURSE OF THIS SURVEY

MAP OF SURVEY
DEPENDENT RESURVEY OF SECTIONS 5 & 6
T.13.S., R.27E., W.M.
GRANT COUNTY, OR

SURVEYED FOR THE RECORD

SURVEYED BY MCS & MRT

SCALE: 1" = 600' DRAWN BY: MRT 1/25/2017