

CORNER MONUMENTATION AND CORNER ACCESSORIES


- T125 R34E**
C 1/4 S15
1981
L51026
SET MONUMENT 24" IN GROUND MARKED AS SHOWN. RAISED STONE MOUND 2 FT. BASE. MARKED BEARING TREES: 14" DOUGLAS FIR BEARS 551°30'E, 19.2 FT. SCRIBED "C114515 BT". 14" DOUGLAS FIR BEARS 554°W, 28.0 FT. SCRIBED "C114515 BT". B. 2 P. 39.
- T125 R34E**
N 1/4 S15
1981
L51026
SET MONUMENT 26" IN GROUND MARKED AS SHOWN. RAISED STONE MOUND 2 FT. BASE. MARKED BEARING TREES: 14" DOUGLAS FIR BEARS N11°E, 9.6 FT. SCRIBED "CN1165 15 BT". 8" WHITE FIR BEARS 566°E, 13.0 FT. SCRIBED "CN116515 BT". B. 2 P. 39.
- T125 R34E**
S16 S15
1981
L51026
SET MONUMENT 24" IN GROUND MARKED AS SHOWN. RAISED STONE MOUND 2 FT. BASE. MARKED BEARING TREES: 11" PONDEROSA PINE BEARS N12°W, 12.5 FT. SCRIBED "N116 516 BT". 15" PONDEROSA PINE BEARS S60°E, 11.7 FT. SCRIBED "N116515 BT". B. 2 P. 40.
- T125 R34E**
N 1/4 S21
1981
L51026
STONE MOUND WORKING CORNER BEARS N64°E, 19.4 FT. SET MONUMENT 26" IN GROUND MARKED AS SHOWN. RAISED STONE MOUND 2 FT. BASE AND MOVED WORKING CORNER STONES TO CAP. 12" PONDEROSA PINE BEARS S75°E, 26.9 FT. SCRIBED "N116 522 BT". 14" PONDEROSA PINE BEARS N64°E, 19.4 FT. SCRIBED "N116 521 BT". B. 3 P. 22.
- T125 R34E**
N 1/4 S21
1981
L51026
FOUND STONE MOUND WORKING CORNER BEARS 587°E, 34.3 FT. SET MONUMENT 24" IN GROUND. RAISED STONE MOUND 2 FT. BASE AND MOVED WORKING CORNER STONES TO CAP. MARKED BEARING TREES: 10" JUNIPER BEARS N64°W, 8.1 FT. SCRIBED "NE116 521 BT". 9" JUNIPER BEARS N71°E, 38.2 FT. SCRIBED "NE116 521 BT". B. 2 P. 78.
- T125 R34E**
E 1/4 S21
1981
L51026
FOUND STONE MOUND WORKING CORNER BEARS 584°E, 15.2 FT. SET MONUMENT 22" IN GROUND. RAISED STONE MOUND 2 1/2 FT. BASE AND MOVED WORKING CORNER STONES TO CAP. MARKED BEARING TREES: 8" JUNIPER BEARS N72°W, 24.9 FT. SCRIBED "E1116516 BT". 10" PONDEROSA PINE BEARS 56°W, 36.9 FT. SCRIBED "E1116521 BT". B. 2 P. 79.
- T125 R34E**
E 1/4 S16
1981
L51026
FOUND STONE MOUND WORKING CORNER BEARS 552°E, 18.3 FT. SET MONUMENT 15" IN GROUND. RAISED STONE MOUND 3 FT. BASE AND MOVED WORKING CORNER STONES TO CAP. MARKED BEARING TREES: 11" PONDEROSA PINE BEARS N54°W, 33.2 FT. SCRIBED "CN116516 BT". 10" PONDEROSA PINE BEARS N50°E, 13.0 FT. SCRIBED "CN116516 BT". B. 3 P. 15.
- T125 R34E**
S16 S15
1981
L51026
FOUND STONE MOUND WORKING CORNER BEARS 522°E, 34.8 FT. SET MONUMENT 26" IN GROUND. RAISED STONE MOUND 2 1/2 FT. BASE AND MOVED WORKING CORNER STONES TO CAP. MARKED BEARING TREES: 11" DOUGLAS FIR BEARS N88°W, 23.9 FT. SCRIBED "C114516 BT". 9" PONDEROSA PINE BEARS S15°E, 18.5 FT. SCRIBED "C114516 BT". B. 3 P. 14.
- T125 R34E**
S 1/4 S16
1981
L51026
SET MONUMENT 24" IN GROUND. RAISED STONE MOUND 2 FT. BASE. MARKED BEARING TREES: 13" PONDEROSA PINE BEARS N36°W, 48.9 FT. SCRIBED "C114521 BT". 8" JUNIPER BEARS 522°W, 41.2 FT. SCRIBED "C114521 BT". B. 3 P. 21.

CORNER NOTES

BOOK AND PAGE NUMBERS REFER TO THE FIELD BOOK AND PAGE. ALL CORNER MONUMENTS EXCEPT C5116516J ARE 2 1/2" O.D. ALUMINUM PIPE 30" LONG WITH 3 1/4" ALUM. CAP MARKED AS PER DIAGRAM. ALL BEARING TREES ARE SCRIBED AS PER B.L.M. MANUAL OF INSTRUCTIONS, 1973, WITH THE ADDITION OF A BRASS WASHER MARKED "L51026" NAILED IN LOWER BLAZE. BEARINGS TO BEARING TREES ARE BY COMPASS USING DECLINATION OF 18° EAST WITH DISTANCES MEASURED TO CENTER OF TREE.

SUMMARY OF CORNER SEARCH AND EVIDENCE FOUND

- T125 R34E**
S16 S15
1981
L51026
FOUND 2 1/2" O.D. GALV. IRON PIPE 6" ABOVE GROUND W/ 3 1/4" B.C. MARKED AS SHOWN. FOUND ORIGINAL BASALT STONE 16" X 10" X 8" SET NE OF CAP MARKED 3 NOTCHES NORTH EDGE AND 3 NOTCHES SOUTH EDGE. 1966 B.L.M. BT'S: 24" PONDEROSA PINE BEARS 568°12'W 13 LKS VISIBLE SCRIBING "2 SR33E524 BT". 27" PONDEROSA PINE BEARS 329° 30'E 17 LKS HEALED FACES: 18" PONDEROSA PINE BEARS N21°E 38 LKS VISIBLE SCRIBING "T125 R34E 518 BT". 16" PONDEROSA PINE BEARS N82° 30'W 202 1/2 LKS VISIBLE SCRIBING "T125R33E 518 BT". NOT OF RECORD - ACCEPT CORNER.
- T125 R34E**
S16 S15
1981
L51026
NONE FOUND - LOST. ALL STONES IN AREA HAVE BEEN PLACED IN ROCK JACKS IN E-W FENCE LINE. CORNER NOT MONUMENTED. B. 2 P. 68.
- T125 R34E**
S16 S15
1981
L51026
NONE FOUND - LOST. CORNER FALLS ON WEST SIDE OF SMALL STREAM SOUTH OF LOGS ROCK CULVERT ROAD CROSSING. OLD DOWN E-W FENCE LINE WITH ROCK JACKS PASSES THROUGH AREA - HEAVILY DISTURBED. CORNER NOT MONUMENTED.
- T125 R34E**
S16 S15
1981
L51026
NONE FOUND - LOST. CORNER FALLS IN CHAIN EAST OF DAD'S CREEK IN HEAVILY LOGGED AND DISTURBED CREEK BOTTOM. CORNER NOT MONUMENTED.
- T125 R34E**
S16 S15
1981
L51026
FOUND BASALT STONE 23" X 9" X 7" LYING IN STONE MOUND 3' X 4' BASE ON ROCKY RIDGE. MARKED WITH 2 NOTCHES AND 5 NOTCHES ADJACENT EDGES. FOUND 1/2" I.D. X 10" LONG GALV. IRON PIPE NOT OF RECORD SET BETWEEN STONE. CORNER NOT REMONUMENTED.
- T125 R34E**
S16 S15
1981
L51026
FOUND STONE 16" X 10" X 4" WITH SINGLE FAINT MARK "1" ON FACE. STONE IS CALL 512E AND HARMONIOUSLY LOCATED WITH REFERENCE TO SURROUNDING CORNERS. REMONUMENTED. B. 2 P. 61 & 62.
- T125 R34E**
S16 S15
1981
L51026
FOUND STONE 16" X 14" X 10" FIRMLY SET IN SUNKEN MOUND WITH STONES RECENTLY ADDED TO SURFACE. FOUND 17" PONDEROSA PINE SNAG DEAD & DOWN WITH VISIBLE SCRIBING "114 5 BT" FACING MOUND BEARS N19°2'E, 20.0 FT. TO CENTER ROOT HOLE. C REC-52°E, 28 LKS - 18.48 FT. J. CONCLUDE RECORD BEARING IN ERROR BECAUSE OF BT ORIENTATION AND ACCEPT STONE IN MOUND. REMONUMENTED.
- T125 R34E**
S16 S15
1981
L51026
FOUND STONE 21" X 13" X 12" C REC-16" X 11" X 6" LYING IN RECENT CAST ON TOP OF UNDECAYED DUFF. STONE MARKED WITH 4 NOTCHES TOP CENTER & 3 NOTCHES LOWER EDGE. FOUND LOCATION BEARS N 8°56'52"E, 13.89 FT. FROM CAP. CONSIDER LOST AND REESTABLISH BY PROPORTION. BURY FOUND STONE NORTH OF NEW MONUMENT.
- T125 R34E**
S16 S15
1981
L51026
NONE FOUND - LOST. CORNER FALLS ON EAST SIDE OF SKID ROAD ON HEAVILY LOGGED NORTH SLOPE. MONUMENTED. B. 2 P. 34 & 35 B. 2 P. 77.
- T125 R34E**
S16 S15
1981
L51026
NONE FOUND - LOST. CORNER FALLS ON SOUTH SLOPE WITH DOWN E-W FENCE LINE WITH ROCK JACKS. REESTABLISH BY PROPORTION. MONUMENTED. B. 2 P. 65 & 66.
- T125 R34E**
S16 S15
1981
L51026
FOUND BASALT STONE 17" X 11" X 8" C REC-15" X 10" X 4" IN STONE MOUND IN N-S DOWN FENCE LINE MARKED "4". STONE LOCATION BEARS 530°36'44"W, 120.03 FT. FROM CAP. FOUND LOCATION WAS NOT HARMONIOUSLY RELATED TO ANY OTHER CORNERS AND CONCLUDE IT WAS MOVED TO SUPPORT FENCE AND NOT IN ITS ORIGINAL LOCATION AND REJECT ITS POSITION. CONSIDER CORNER LOST AND PROPORTION TO REESTABLISH CORNER. BURY STONE FOUND NORTH OF NEW MONUMENT.
- T125 R34E**
S16 S15
1981
L51026
NONE FOUND - LOST. CORNER FALLS ON UNSTABLE SERPENTINE AND BASALT EAST SLOPE OF LOOSE STONEY RUBBLE. PROPORTION TO REESTABLISH CORNER. MONUMENTED. B. 2 P. 32 & 33 B. 3 P. 20.
- T125 R34E**
S16 S15
1981
L51026
FOUND STONE 17" X 11" X 7" IN CENTER OF SUNKEN MOUND. STONE VERY ROUGH WITH NO VISIBLE MARKS. REMONUMENTED. B. 1 P. 75 B. 2 P. 36 B. 3 P. 10.
- T125 R34E**
S16 S15
1981
L51026
FOUND BURNED SNAG WITH VISIBLE SCRIBING "BT" BEARS N41°E, 54.1 FT. FOUND DOWN & DEAD ROTTEN TAMMACK TREE, ROOT HOLE BEARS 557°E, 39.6 FT. CORN. SE BT J. 18" LONG ROTTEN 3" POST WITH SCRIBING "V" NEAR END. REMONUMENTED.
- T125 R34E**
S16 S15
1981
L51026
FOUND DEAD & DOWN ROTTEN 12" PONDEROSA PINE WITH VISIBLE SCRIBING "15" "ROOT HOLE BEARS N70°E, 17.2 FT. FOUND 14" DOUGLAS FIR WITH VISIBLE SCRIBING "BT" BEARS 568°E, 20.4 FT. 33" LONG ROTTEN 3" POST WITH SCRIBING "114-5" NEAR END. REMONUMENTED.

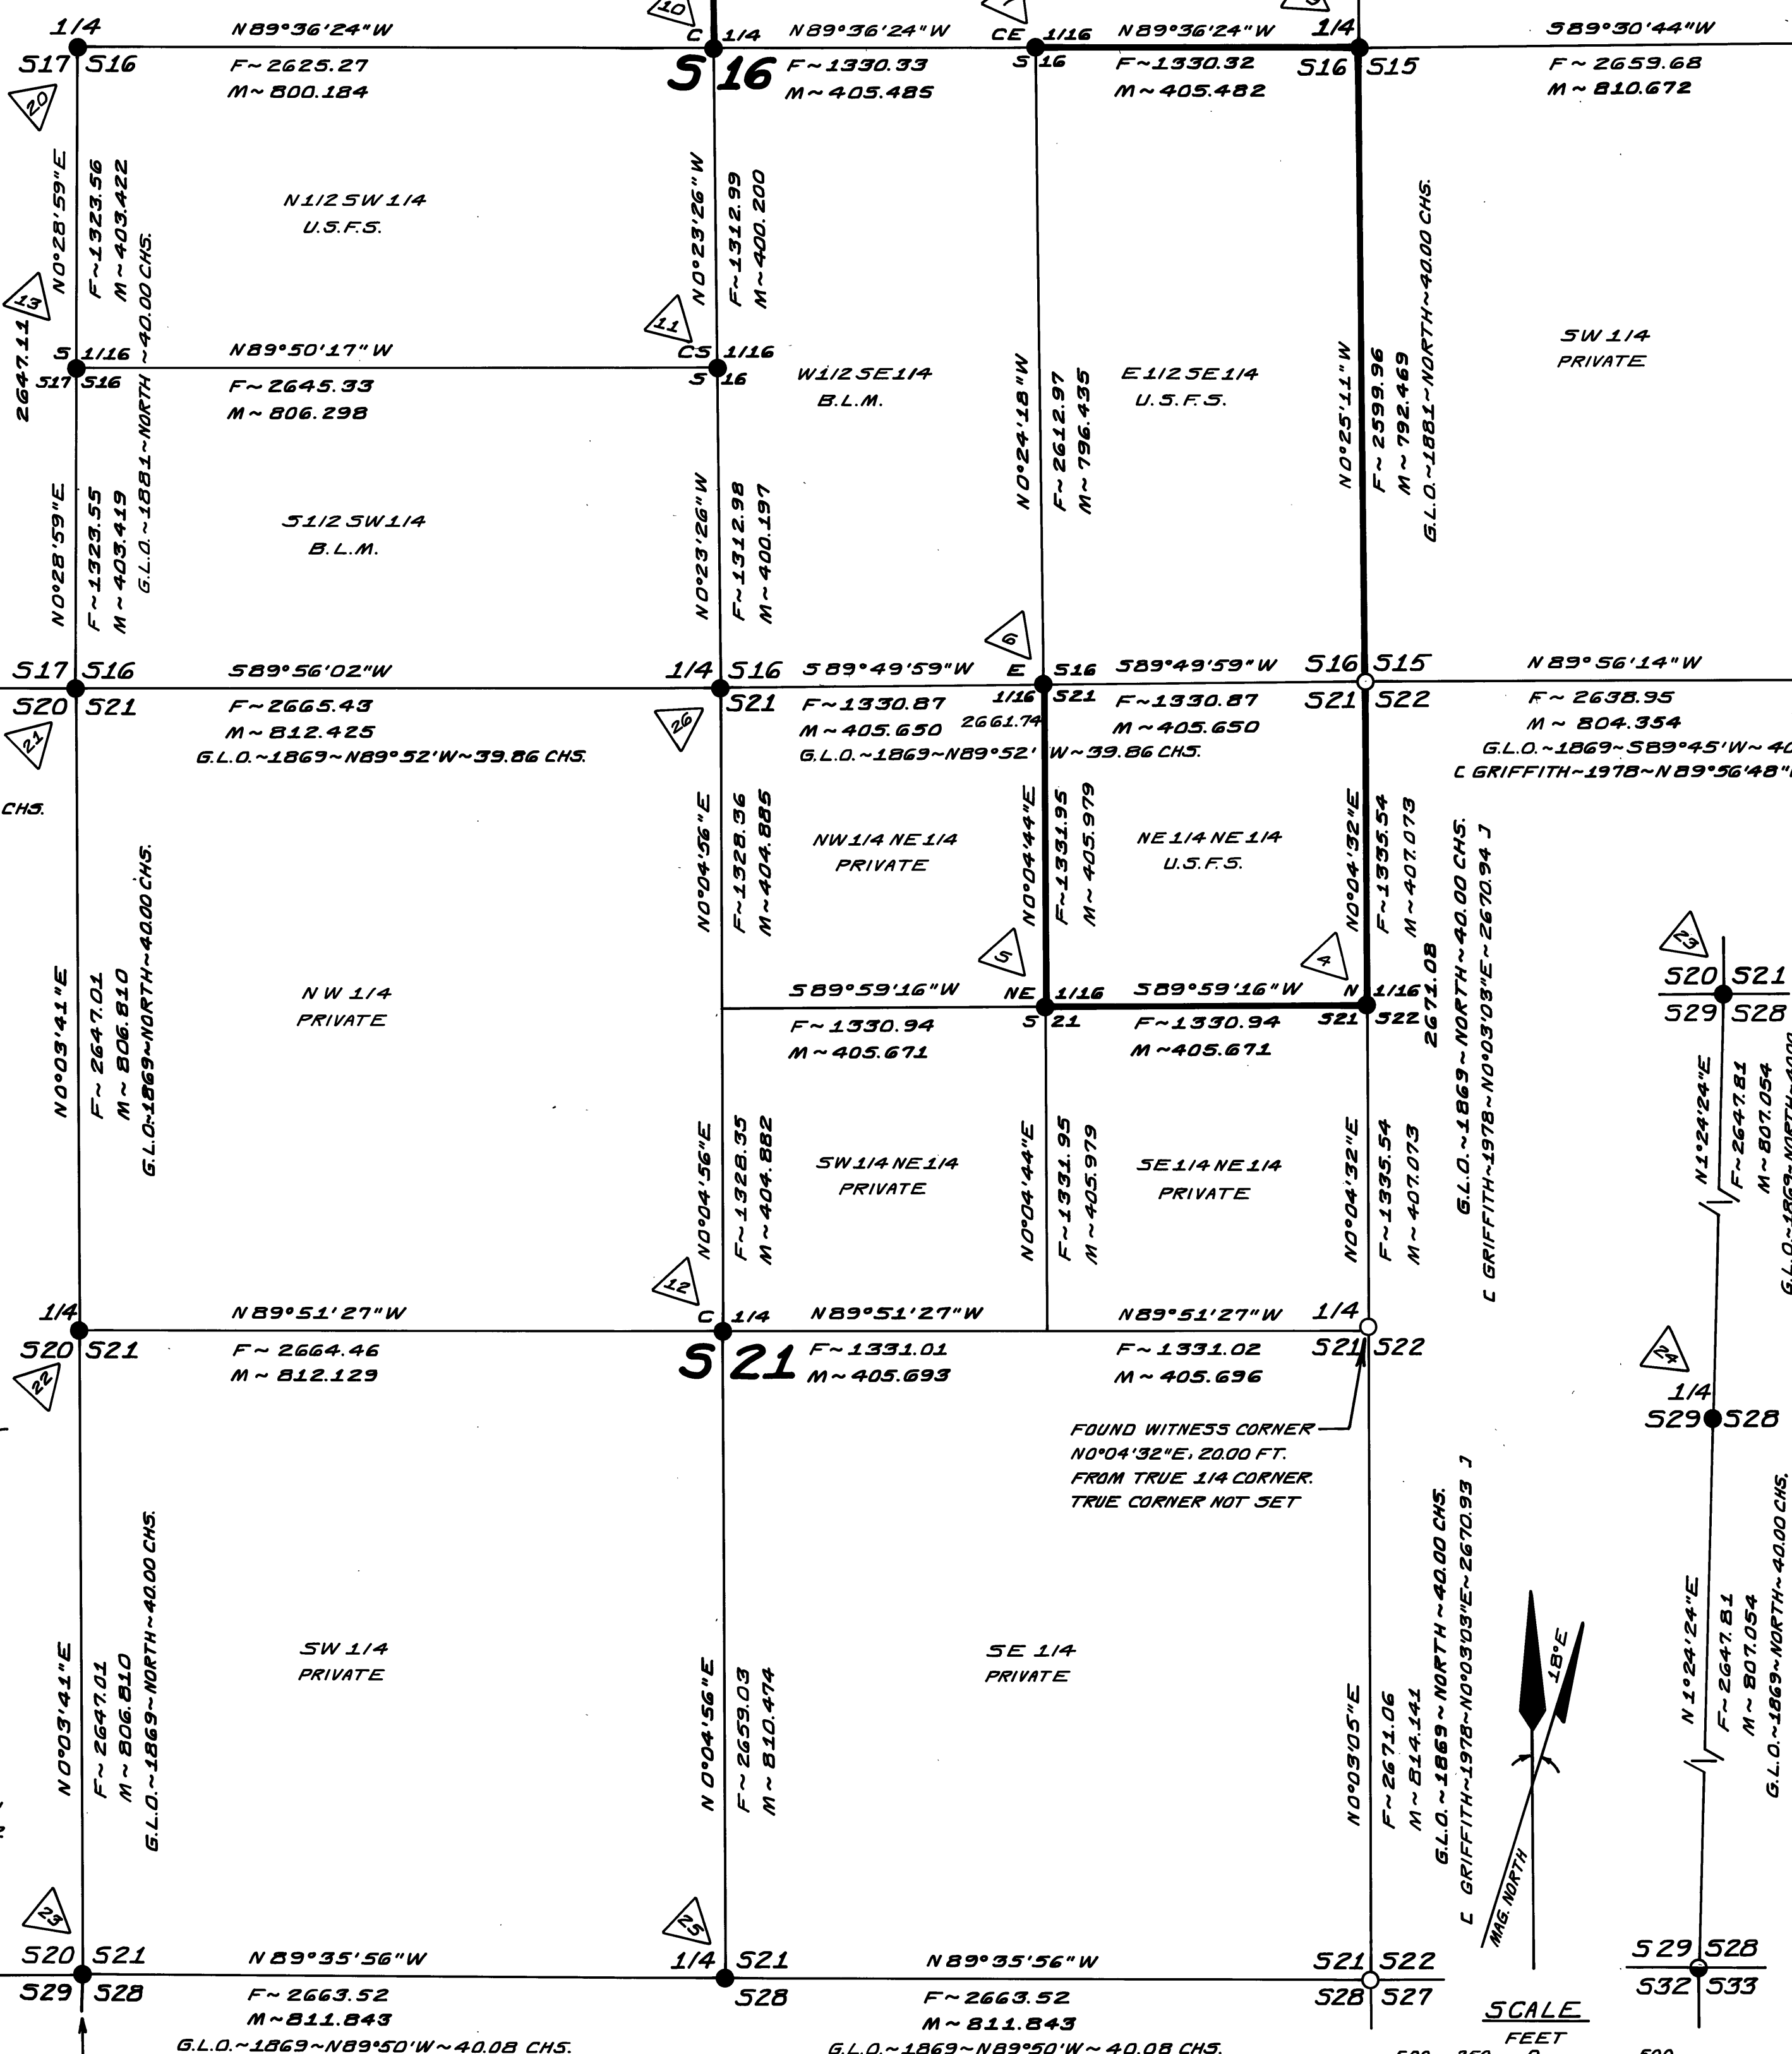

MALHEUR NATIONAL FOREST

TWO BIT CADASTRAL SURVEY
CONTRACT NO. 53-04H1-1-8441N
PRAIRIE CITY RANGER DISTRICT

SUBDIVISION OF SECTIONS 15,
16 & 21, TOWNSHIP 12 SOUTH,
RANGE 34 EAST, WILLAMETTE
MERIDIAN, GRANT COUNTY, OREGON
W.O. 81-328

LEGEND

- FOUND 1" I.D. GALVANIZED IRON PIPE WITH 2 1/2" BRASS CAP MARKED "GRANT COUNTY SURVEYOR", SET BY DUANE J. GRIFFITH, L5 644, AS PER CERTIFIED RECORD OF LAND CORNER MONUMENTATION, FILED WITH MAP OF SURVEY NO. 541 IN 1978.
- FOUND 1" I.D. GALVANIZED IRON PIPE WITH 2 1/2" BRASS CAP MARKED "GRANT COUNTY SURVEYOR", SET BY ROBERT D. BAGETT, L5 598, AS PER CERTIFIED RECORD OF LAND CORNER MONUMENTATION, FILED WITH MAP OF SURVEY NO. 514 IN 1978.
- FOUND 2" I.D. GALVANIZED IRON PIPE WITH 3 1/4" BRASS CAP MARKED "U.S. DEPT. OF INTERIOR - BUREAU OF LAND MANAGEMENT", 1966, UNRECORDED.
- SET CORNER MONUMENT REMONUMENTED OR MONUMENTED DURING THIS SURVEY BEING A 2 1/2" O.D. ALUMINUM PIPE 30" LONG WITH 3 1/4" ALUMINUM CAP WITH MAGNETIC BOTTOM. A CERTIFIED RECORD OF LAND CORNER MONUMENTATION FOR ALL ORIGINAL 1/4 AND SECTION CORNERS TO BE FILED CONCURRENTLY WITH THIS MAP. ALL OTHER CORNERS NOT PREVIOUSLY ESTABLISHED IN RECORDS OF GRANT COUNTY SURVEYOR, CANYON CITY, OREGON.
- INDICATES U.S.F.S. PROPERTY BOUNDARY POSTED UNDER THIS CONTRACT WITH 5 1/2" FOOT STEEL FENCE POSTS WITH U.S.F.S. PROPERTY BOUNDARY SIGNS ATTACHED.
- J INDICATES RECORD SURVEY INFORMATION.
- G.L.O. GENERAL LAND OFFICE RECORD INFORMATION.
- 1 CORNER MONUMENT NUMBER.

GENERAL SURVEY NOTES

- EQUIVALENT DISTANCE IN METERS FOR SURVEYED LINES OBTAINED BY MULTIPLYING DISTANCE IN FEET BY CONVERSION FACTOR OF 1200 ÷ 3937 OR ONE SURVEY FOOT EQUALS 0.3048006096 METERS.
- SURVEY FIELD NOTES ARE ON FILE IN THE OFFICE OF ARMSTRONG SURVEYING & ENGINEERING, INC., 378 EAST SECOND STREET, PRINEVILLE, OREGON - THREE BOOKS.
- BEARINGS FOR THIS SURVEY BASED ON SOLAR OBSERVATION TAKEN NEAR W. 1/4 CORNER SECTION 21.
- GENERAL LAND OFFICE RECORD FOR SUBDIVISIONAL LINES SOUTH HALF OF TOWNSHIP FROM OFFICIAL NOTES AND PLAT BY JOHN B. DAVID UNDER G.L.O. CONTRACT NO. 131, DATED JUNE 8, 1869.
- GENERAL LAND OFFICE RECORD FOR SUBDIVISIONAL LINES NORTH HALF OF TOWNSHIP FROM OFFICIAL NOTES AND PLAT BY BARNFORD ROSS AND WILLIAM GRADON UNDER G.L.O. CONTRACT NO. 383, DATED MARCH 26, 1881.
- RECORD SURVEY INFORMATION FOR EAST LINE OF SECTION 22 AND SOUTH LINE SECTION 15 FROM SURVEY BY DUANE J. GRIFFITH, L5 644, ENTITLED "PRIVATE PROPERTY IN SECTIONS 22 AND 23, T125, R34E, W.M. 1, GRANT COUNTY, OREGON", SURVEY NO. 541 OF GRANT COUNTY SURVEYOR'S OFFICE.

SURVEYOR'S CERTIFICATION

I, DAVID B. ARMSTRONG, REGISTERED PROFESSIONAL LAND SURVEYOR NO. 1026 IN THE STATE OF OREGON, DO HEREBY CERTIFY THAT THIS PLAT AND THE NOTES HEREON AND/OR ATTACHED ARE A CORRECT REPRESENTATION OF A SURVEY I PERFORMED DURING MAY-JUNE, 1981, FOR THE UNITED STATES FOREST SERVICE, IN ACCORDANCE WITH THE STATUTES OF THE STATE OF OREGON AND THE ARTICLES OF CONTRACT NO. 53-04H1-1-8441N WITH ARMSTRONG SURVEYING & ENGINEERING, INC., AN OREGON CORPORATION, PRINEVILLE, OREGON.

RECORDATION

OFFICE OF COUNTY SURVEYOR, COUNTY OF GRANT,
STATE OF OREGON, I HEREBY CERTIFY THAT THE
WITHIN INSTRUMENT WAS FILED FOR RECORD ON THE
18 DAY OF July, 1981.
DAVID B. ARMSTRONG
GRANT COUNTY SURVEYOR