


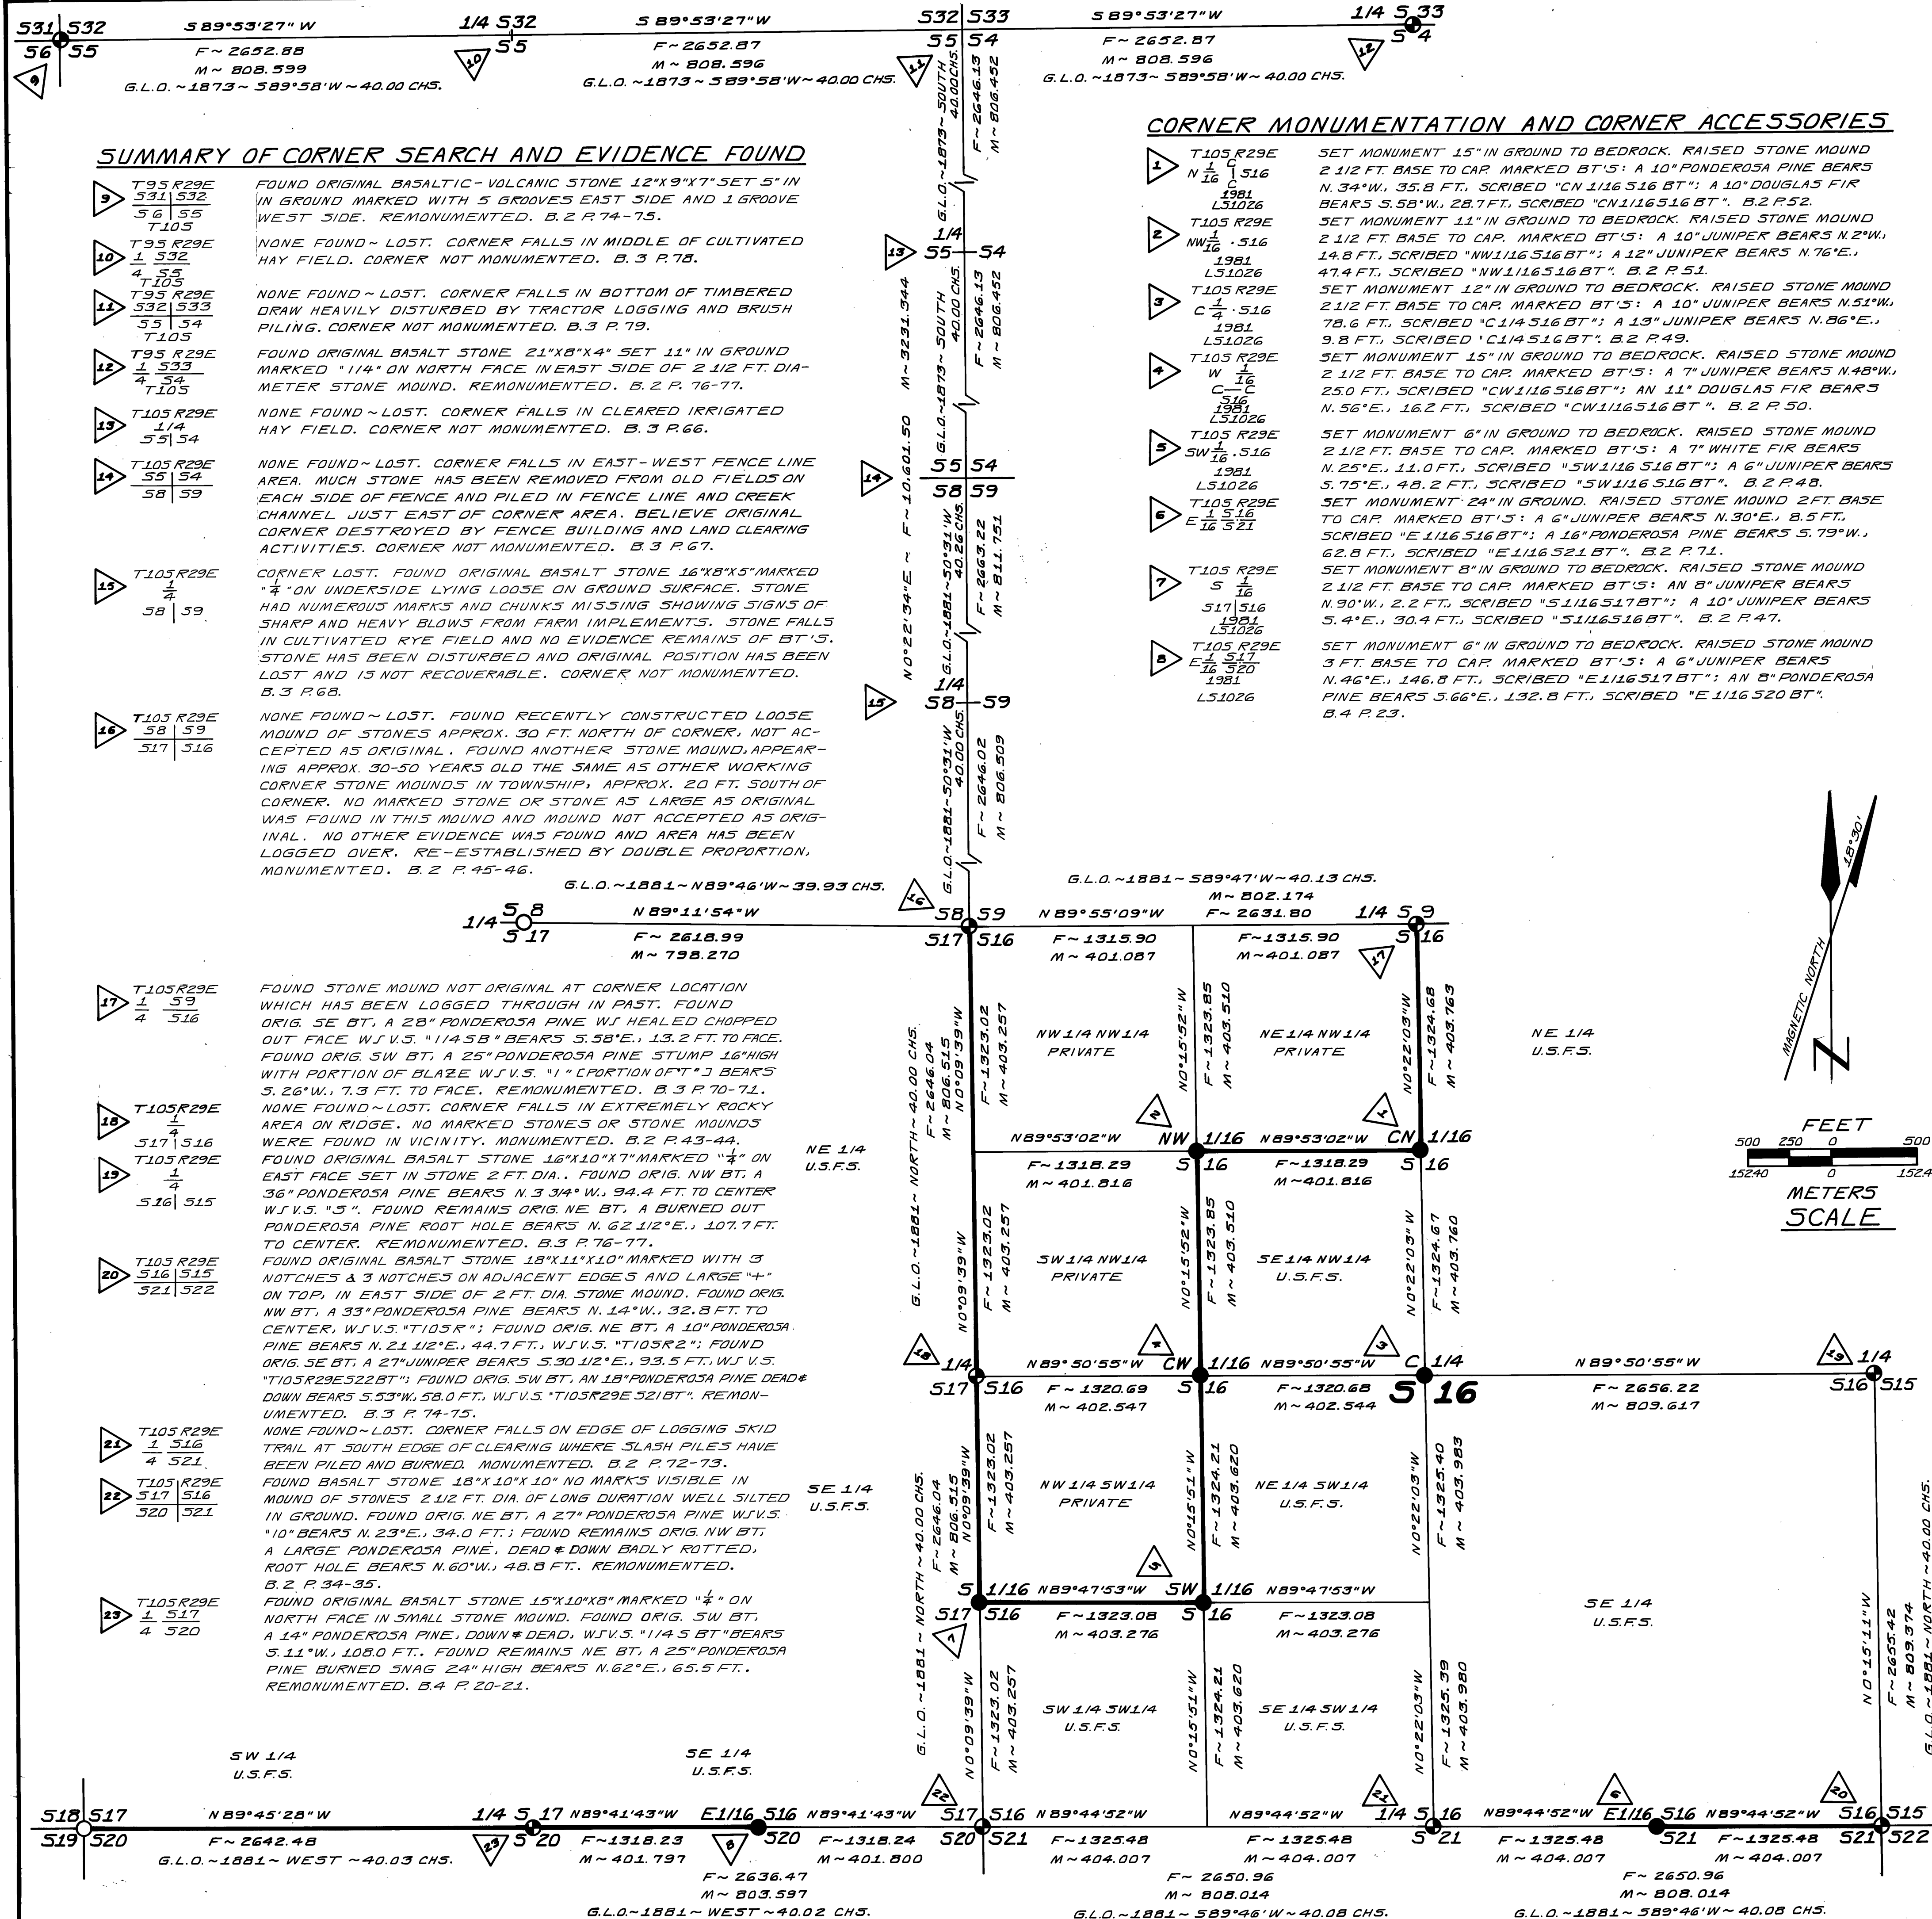

MALHEUR NATIONAL FOREST
DEER CADASTRAL SURVEY
CONTRACT NO 53-04H1-1-8449N
LONG CREEK RANGER DISTRICT

SUBDIVISION OF SECTION 16,
TOWNSHIP 10 SOUTH, RANGE 29 EAST,
WILLAMETTE MERIDIAN,
GRANT COUNTY, OREGON
W.O. 81-327B

LEGEND

- FOUND 2 1/2" O.D. GALVANIZED IRON PIPE WITH 2 1/2" BRASS CAP SET BY DOUGLAS M. FERGUSON, L.S. 848, AS PER CERTIFIED RECORD OF LAND CORNER MONUMENTATION FILED WITH GRANT COUNTY SURVEYOR IN 1979.
- SET CORNER MONUMENT, REMONUMENTED OR MONUMENTED DURING THIS SURVEY, BEING A 2 1/2" O.D. ALUMINUM PIPE 30" LONG WITH 3 1/4" ALUMINUM CAP WITH MAGNETIC BOTTOM. A CERTIFIED RECORD OF LAND CORNER MONUMENTATION FOR ALL G.L.O. 1/4 AND SECTION CORNERS TO BE FILED CONCURRENTLY WITH THIS MAP. NONE OF THESE CORNERS HAVE BEEN PREVIOUSLY RE-ESTABLISHED IN RECORDS OF GRANT COUNTY SURVEYOR.
- SET CORNER MONUMENT DURING THIS SURVEY BEING A 2 1/2" O.D. ALUMINUM PIPE 30" LONG WITH 3 1/4" ALUMINUM CAP WITH MAGNETIC BOTTOM. A COMPLETE DESCRIPTION OF CORNER ESTABLISHMENT APPEARS ON THIS MAP. NONE OF THESE CORNERS HAVE BEEN PREVIOUSLY ESTABLISHED IN RECORDS OF GRANT COUNTY SURVEYOR.
- INDICATES U.S.F.S. PROPERTY BOUNDARY POSTED UNDER THIS CONTRACT WITH 5 1/2 FOOT STEEL FENCE POSTS WITH U.S.F.S. PROPERTY BOUNDARY SIGNS ATTACHED.
- G.L.O. GENERAL LAND OFFICE RECORD SURVEY INFORMATION.
- △ CORNER MONUMENT NOTE NUMBER.
- BT BEARING TREE.
- W.J.V.S. WITH VISIBLE SCRIBING.

GENERAL SURVEY NOTES

1. EQUIVALENT DISTANCE IN METERS FOR SURVEYED LINES OBTAINED BY MULTIPLYING DISTANCE IN FEET BY CONVERSION FACTOR OF 1200+3937 OR ONE SURVEY FOOT EQUALS 0.3048006096 METER-5.
2. SURVEY FIELD NOTES ARE ON FILE IN THE OFFICE OF ARMSTRONG SURVEYING & ENGINEERING, INC., 378 EAST SECOND STREET, PRINEVILLE, OREGON ~ FOUR BOOKS.
3. BEARINGS FOR THIS SURVEY BASED ON SOLAR OBSERVATION TAKEN AT NORTH 1/4 CORNER SECTION 4.
4. GENERAL LAND OFFICE RECORD FOR NORTH TOWNSHIP LINE AND WEST LINE SECTION 4 FROM OFFICIAL NOTES AND PLAT BY W.H. BYARS UNDER G.L.O. CONTRACT NO. 197 BEARING DATE JULY 14, 1873.
5. GENERAL LAND OFFICE RECORD FOR SUBDIVISIONAL LINES FROM OFFICIAL NOTES AND PLAT BY BAMFORD ROBB UNDER JOINT G.L.O. CONTRACT NO. 383 WITH ROBB AND GRADON BEARING DATE MARCH 26, 1881.


CORNER NOTES ~ SIXTEENTH AND CENTER QUARTER

BOOK AND PAGE NUMBERS REFER TO THE FIELD BOOK AND PAGE. ALL CORNER MONUMENTS ARE 2 1/2" O.D. ALUMINUM PIPE WITH MAGNETIC BASE 30" LONG WITH 3 1/4" ALUMINUM CAP MARKED AS PER DIAGRAM. ALL BEARING TREES ARE SCRIBED AS PER B.L.M. MANUAL OF INSTRUCTIONS, 1973, WITH THE ADDITION OF A BRASS WASHED MARKED "LS1026" NAILED IN LOWER BLAZE. PAINTED 6" RED BAND AND FACES RED AND PLACED SIGNS 54-3 AND 54-9 ON BEARING TREES. BOLTED SIGN 54-9 ON STEEL POST. BEARINGS TO BEARING TREE FACE BY COMPASS USING DECLINATION 18°30' EAST WITH DISTANCES MEASURED TO CENTER OF TREE.

SURVEYOR'S CERTIFICATION

I, DAVID B. ARMSTRONG, REGISTERED PROFESSIONAL LAND SURVEYOR NO. 1026 IN THE STATE OF OREGON, DO HEREBY CERTIFY THAT THIS PLAT AND THE NOTES HEREON AND/OR ATTACHED ARE A CORRECT REPRESENTATION OF A SURVEY I PERFORMED DURING JULY-AUGUST, 1981, FOR THE UNITED STATES FOREST SERVICE, IN ACCORDANCE WITH THE STATUTES OF THE STATE OF OREGON AND THE ARTICLES OF CONTRACT NO. 53-04H1-1-8449N WITH ARMSTRONG SURVEYING & ENGINEERING, INC., AN OREGON CORPORATION, PRINEVILLE, OREGON. SEE ATTACHED SURVEY NARRATIVE.

SHEET 1 OF 13

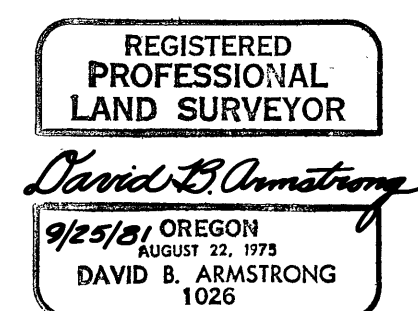

RECORDATION

OFFICE OF COUNTY SURVEYOR, COUNTY OF GRANT, STATE OF OREGON. I HEREBY CERTIFY THAT THE WITHIN INSTRUMENT WAS FILED FOR RECORD ON THE 17 DAY OF OCT, 1981.

Robert D. Burchett
GRANT COUNTY SURVEYOR