


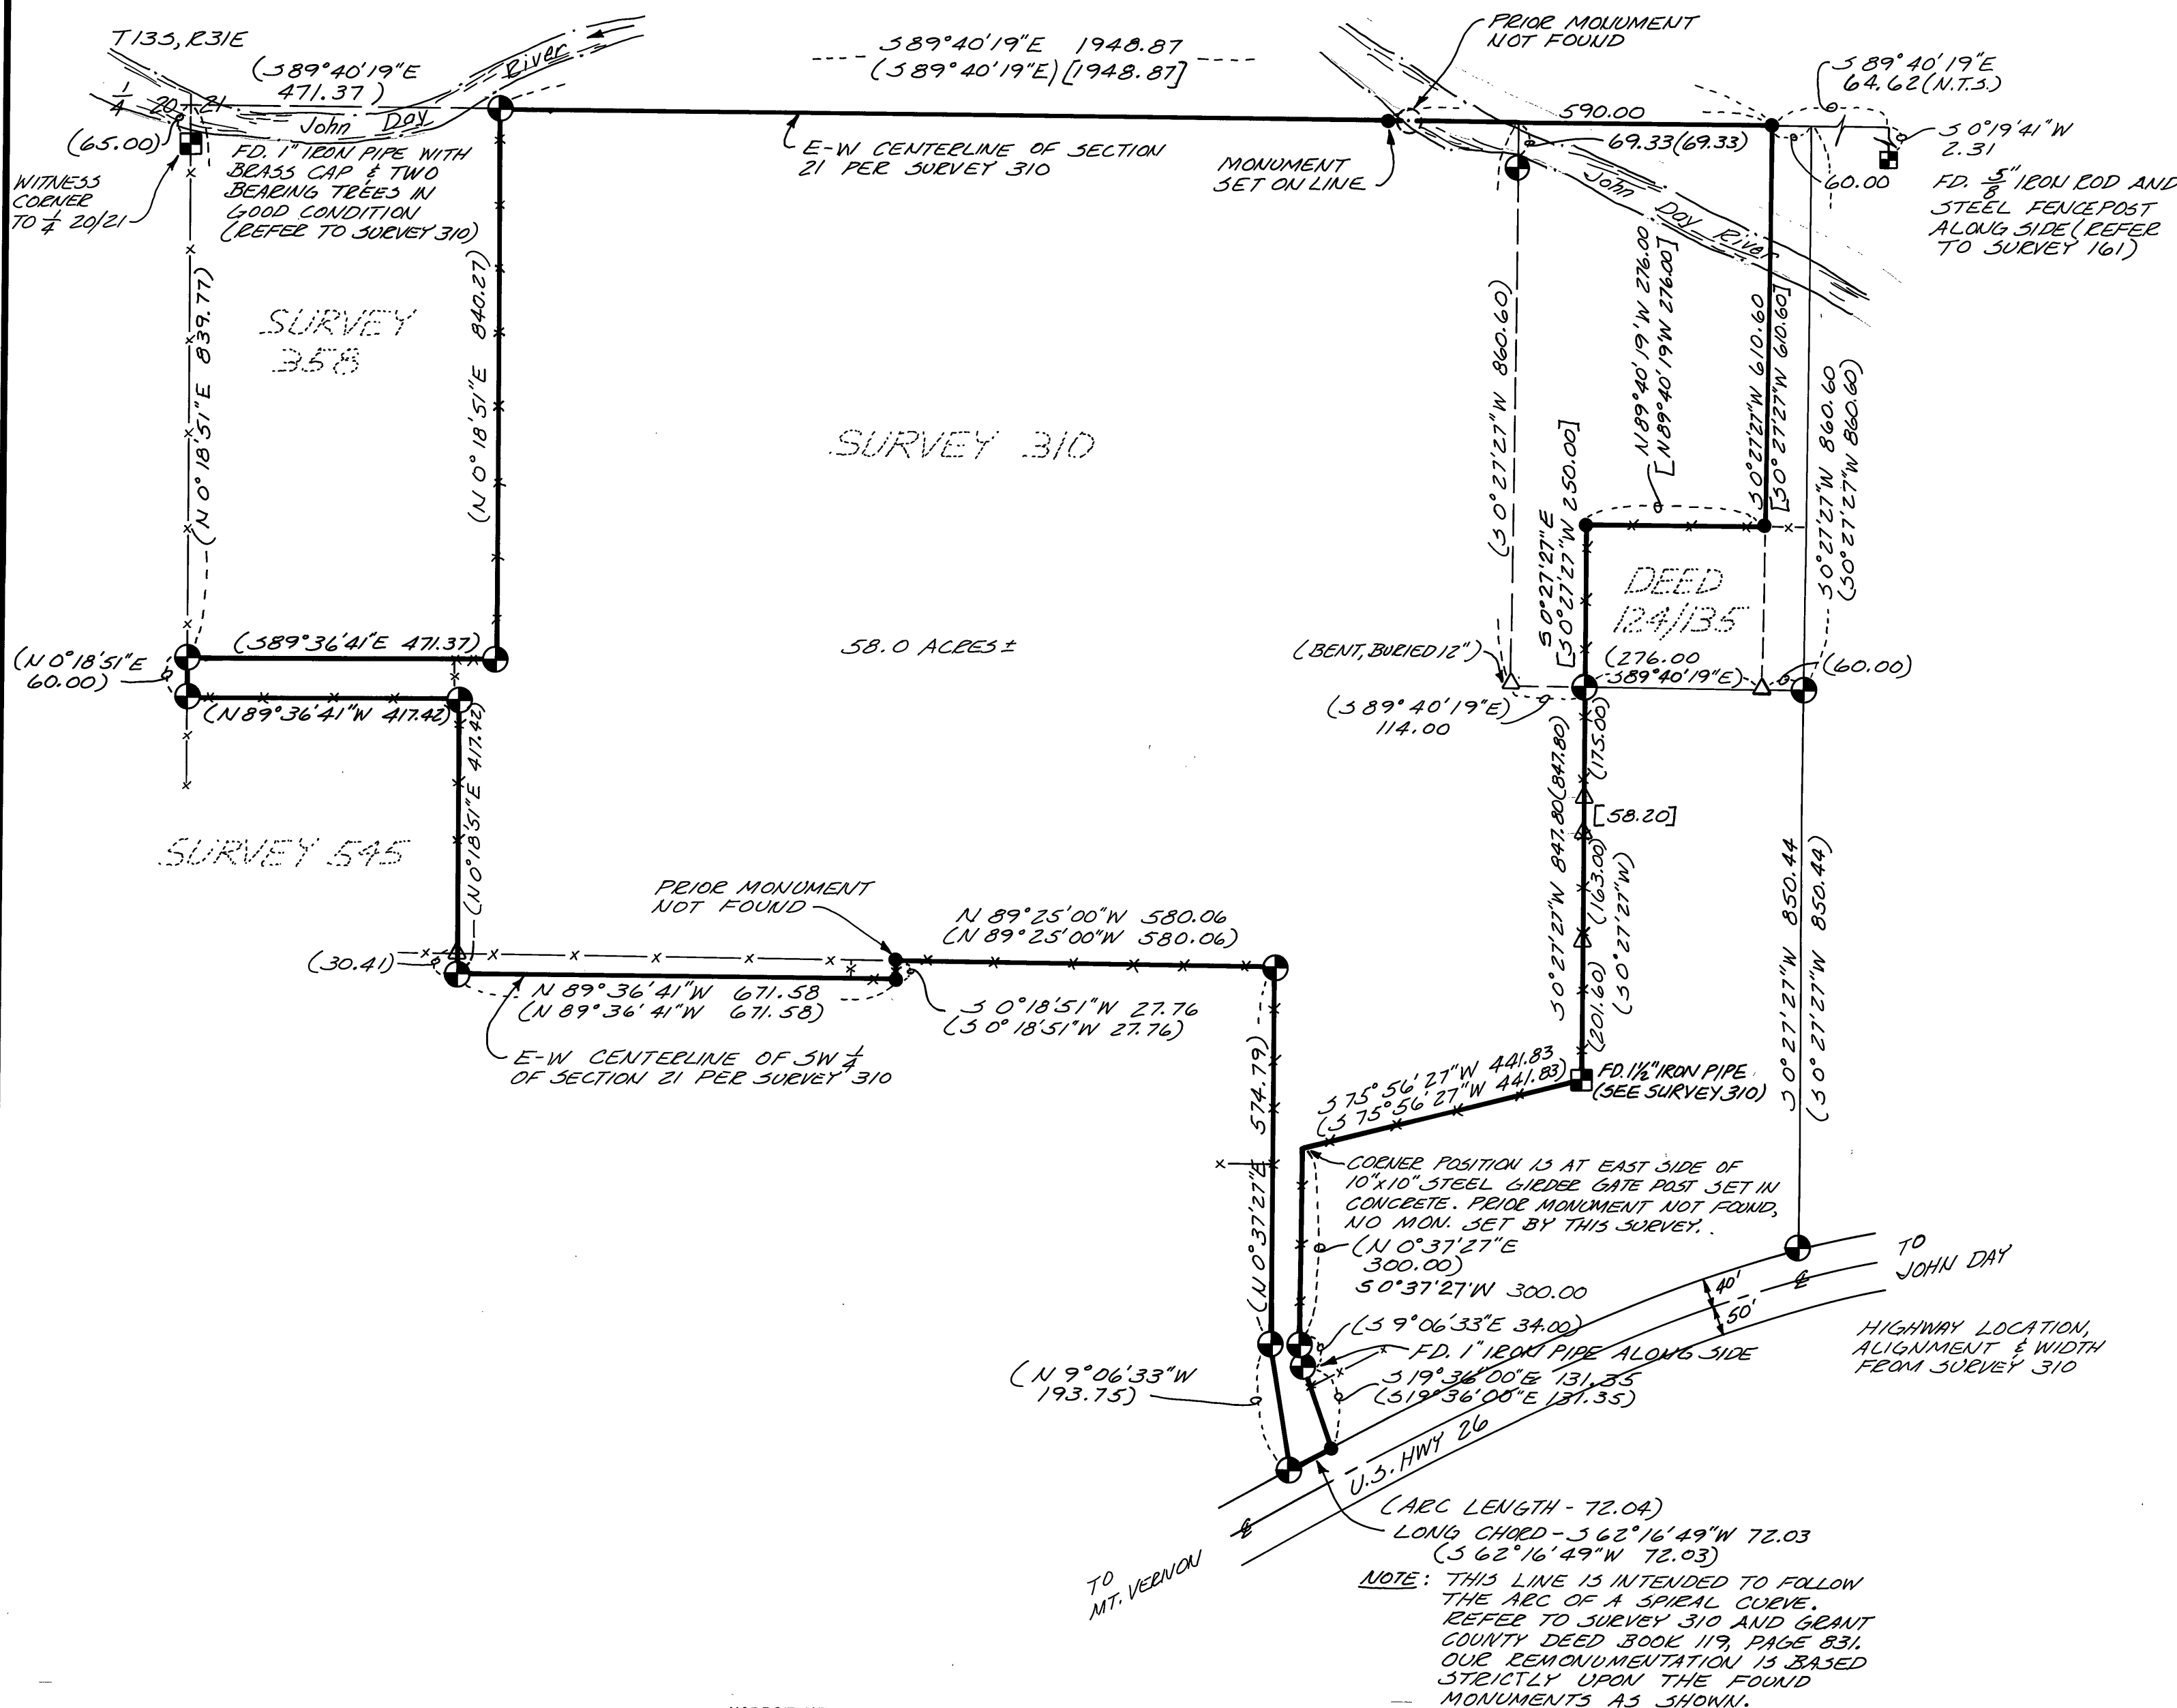

NARRATIVE

Ochoco Lumber Company of Prineville, Oregon, requested this survey in anticipation of developing the property for industrial purposes.

The legal description for this property is based on Grant County Survey No. 310. Therefore our survey efforts were directed toward the recovery of the monuments and the re-establishment of the lines of Survey No. 310. Field conditions were found to satisfactorily agree with the various Survey and Deed Records. The monuments established by this survey were positioned according to the dimensions and relationships set forth in the applicable recorded documents.

REGISTERED
PROFESSIONAL
LAND SURVEYOR

GARY L. LANGLITZ
1983

LOCATED IN THE S.W. 1/4 OF SECTION 21
TOWNSHIP 13 SOUTH, RANGE 31 EAST, W. M.
GRANT COUNTY, OREGON
FOR: OCHOCO LUMBER

SCALE:
1"=200'
DATE:
FEB, 1983
JOB NO.
2686-30

**anderson
perry**
& associates, inc.
engineering • surveying • materials testing
LA GRANDE, ORE. & WALLA WALLA, WASH.

SHEET NO.
1/1

BASIS OF BEARINGS

GRANT COUNTY RECORDED SURVEY
NO. 310

LEGEND

- Found 5/8" Iron Rod (Refer to Survey No. 310).
- Found Monument as Described.
- △ Found monuments described on various recorded surveys noted under "Reference Material". The position of these monuments was not verified, nor were they used for control on this survey.
- Set 5/8" x 30" Iron Reinforcing Rod, with yellow plastic cap attached, marked "AP & A".
- () Record survey dimension.
- [] Record deed dimension.
- Existing Fence.

REFERENCE MATERIAL

GRANT COUNTY DEED RECORDS:

Book 119 Page 831
Book 124 Page 135

GRANT COUNTY SURVEYOR'S RECORDS

Survey No. 161
310
358
545

**RECEIVED AND
FILED**

MAR 15 1983

OFFICE OF COUNTY SURVEYOR

Attest: *[Signature]*

**anderson
perry**
& associates, inc.
engineering • surveying • materials testing
LA GRANDE, ORE. & WALLA WALLA, WASH.