

OCHOCO NATIONAL FOREST  
SAWMILL CADASTRAL SURVEY  
CONTRACT NO. 53-04H1-3-9360N  
PAULINA RANGER DISTRICT

SURVEY OF LINE BETWEEN SECTIONS 34 AND 35,  
TOWNSHIP 13 SOUTH, RANGE 26 EAST, W.M.,  
GRANT COUNTY, OREGON  
W.O. 83-411E


LEGEND

- FOUND 2 1/2" O.D. GALVANIZED IRON PIPE WITH 2 1/2" BRASS CAP BY B.L.M..
- ⊙ FOUND 2 1/2" O.D. ALUMINUM PIPE WITH 3 1/4" ALUMINUM CAP BY DAVID B. ARMSTRONG, LS 1026.
- SET A 2 1/2" O.D. X 30" LONG ALUMINUM PIPE WITH 3 1/4" ALUMINUM CAP MARKED AS PER THE B.L.M. MANUAL OF INSTRUCTIONS 1973 DURING THIS SURVEY - CAP MARKINGS SHOWN ON CORNER SUMMARY.
- INDICATES U.S.F.S. PROPERTY BOUNDARY POSTED UNDER THIS CONTRACT WITH 6 FOOT LONG STEEL FENCE POSTS WITH U.S.F.S. PROPERTY BOUNDARY SIGNS ATTACHED (54-2).
- [ J RECORD SURVEY INFORMATION, ORIGINAL G.L.O. BY LEVI C. WALKER IN 1880.
- △ CORNER MONUMENT NUMBER - SEE SHEET 2 FOR ADDITIONAL INFORMATION.

GENERAL SURVEY NOTES

1. SURVEY FIELD NOTES ARE ON FILE IN THE OFFICE OF ARMSTRONG SURVEYING & ENGINEERING, INC., 378 EAST SECOND STREET, PRINEVILLE, OREGON - ONE BOOK.
2. BASIS OF BEARINGS - BEARINGS FOR THIS SURVEY ARE BASED ON SOLAR OBSERVATION TAKEN NEAR CORNER COMMON TO SECTIONS 26, 27, 34 AND 35 AT NORTH END OF THIS LINE AND VERIFIED BY SOLAR OBSERVATION TAKEN AT CORNER COMMON TO SECTIONS 34 AND 35 ONLY AT SOUTH END OF LINE.
3. GENERAL LAND OFFICE RECORD FOR COMPLETION SUBDIVISION OF T.13S., R.26E., W.M., FROM OFFICIAL NOTES AND PLAT BY LEVI C. WALKER, DEPUTY SURVEYOR, PERFORMED UNDER GENERAL LAND OFFICE CONTRACT NO. 374 DATED SEPTEMBER 27, 1880.
4. GENERAL LAND OFFICE RECORD FOR PARTIAL SUBDIVISION OF T.13S., R.26E., W.M., FROM OFFICIAL NOTES AND PLAT BY JASON OWEN, DEPUTY SURVEYOR, PERFORMED UNDER GENERAL LAND OFFICE CONTRACT NO. 194 DATED JULY 1, 1873.
5. THE CORNER COMMON TO SECTIONS 26, 27, 34 AND 35 WAS REMONUMENTED BY C. ALBERT WHITE, CADASTRAL SURVEYOR, UNDER SURVEY GROUP 483, DATED SEPTEMBER 10, 1962.

(CONTINUED ON PAGE 2)

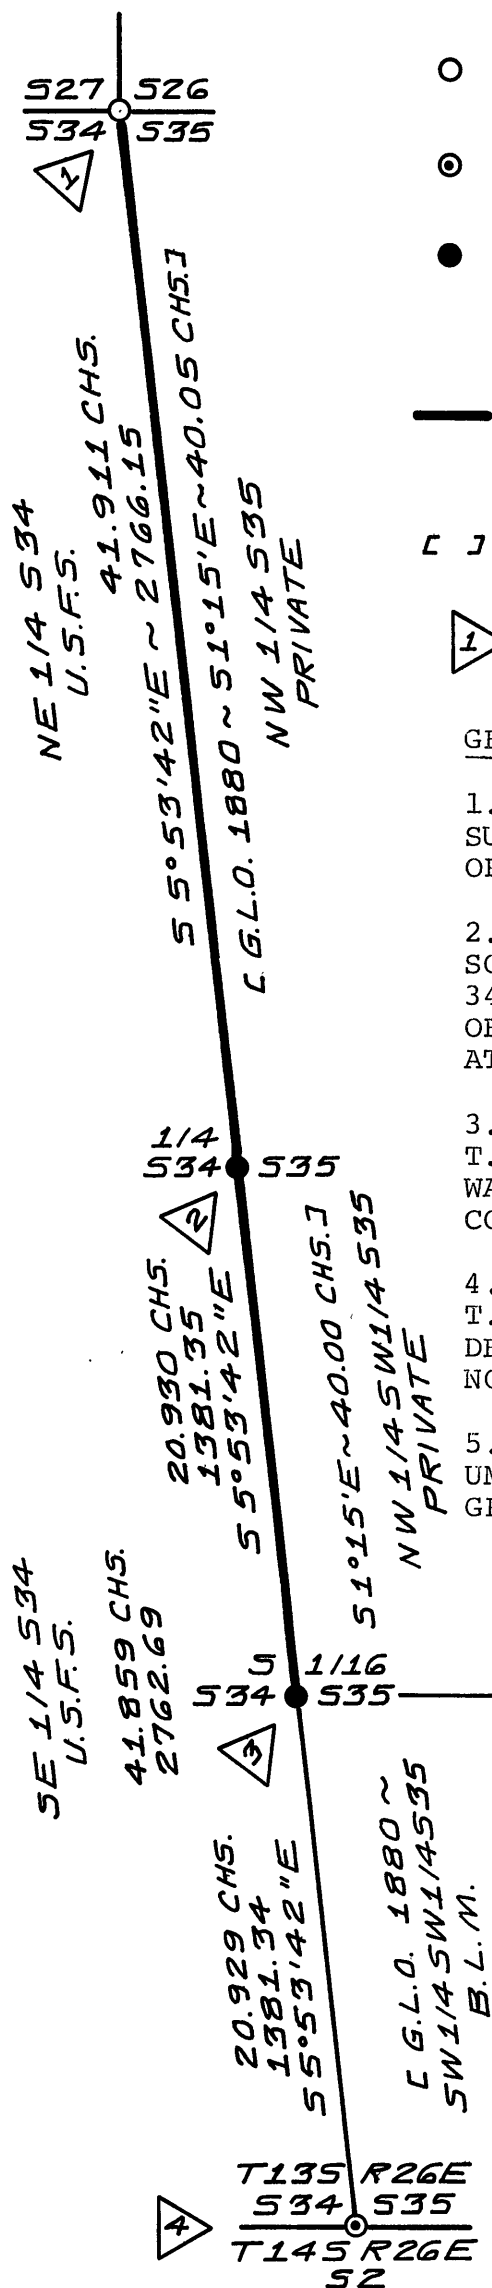

SURVEYOR'S CERTIFICATION

I, DAVID B. ARMSTRONG, A REGISTERED PROFESSIONAL LAND SURVEYOR IN THE STATE OF OREGON, ON THE BASIS OF MY KNOWLEDGE, INFORMATION, AND BELIEF, CERTIFY THAT THIS PLAT, SURVEY NARRATIVE AND CERTIFIED CORNER RECORDS AND/OR NOTES ARE A CORRECT REPRESENTATION OF A SURVEY PERFORMED DURING SEPTEMBER, 1984, AT THE REQUEST OF THE U.S.D.A., FOREST SERVICE, IN ACCORDANCE WITH STATUTES OF THE STATE OF OREGON AND ARTICLES OF CONTRACT NO. 53-04H1-3-9360N WITH ARMSTRONG SURVEYING & ENGINEERING, INC..

RECORDATION

OFFICE OF COUNTY SURVEYOR, COUNTY OF GRANT, STATE OF OREGON. I HEREBY CERTIFY THAT THE WITHIN INSTRUMENT WAS FILED FOR RECORD ON THE 23 DAY OF Nov, 1984.

*Robert D. Bayless*  
GRANT COUNTY SURVEYOR

ARMSTRONG SURVEYING & ENGINEERING, INC.  
378 EAST SECOND STREET  
PRINEVILLE, OREGON 97754  
PHONE (503) 447-7791

SHEET 1 OF 2

REGISTERED  
PROFESSIONAL  
LAND SURVEYOR

*David B. Armstrong*  
11/7/84 OREGON  
AUGUST 22, 1973  
DAVID B. ARMSTRONG  
1026

W.O. 83-411E

MAP OF SURVEY NO. 846