
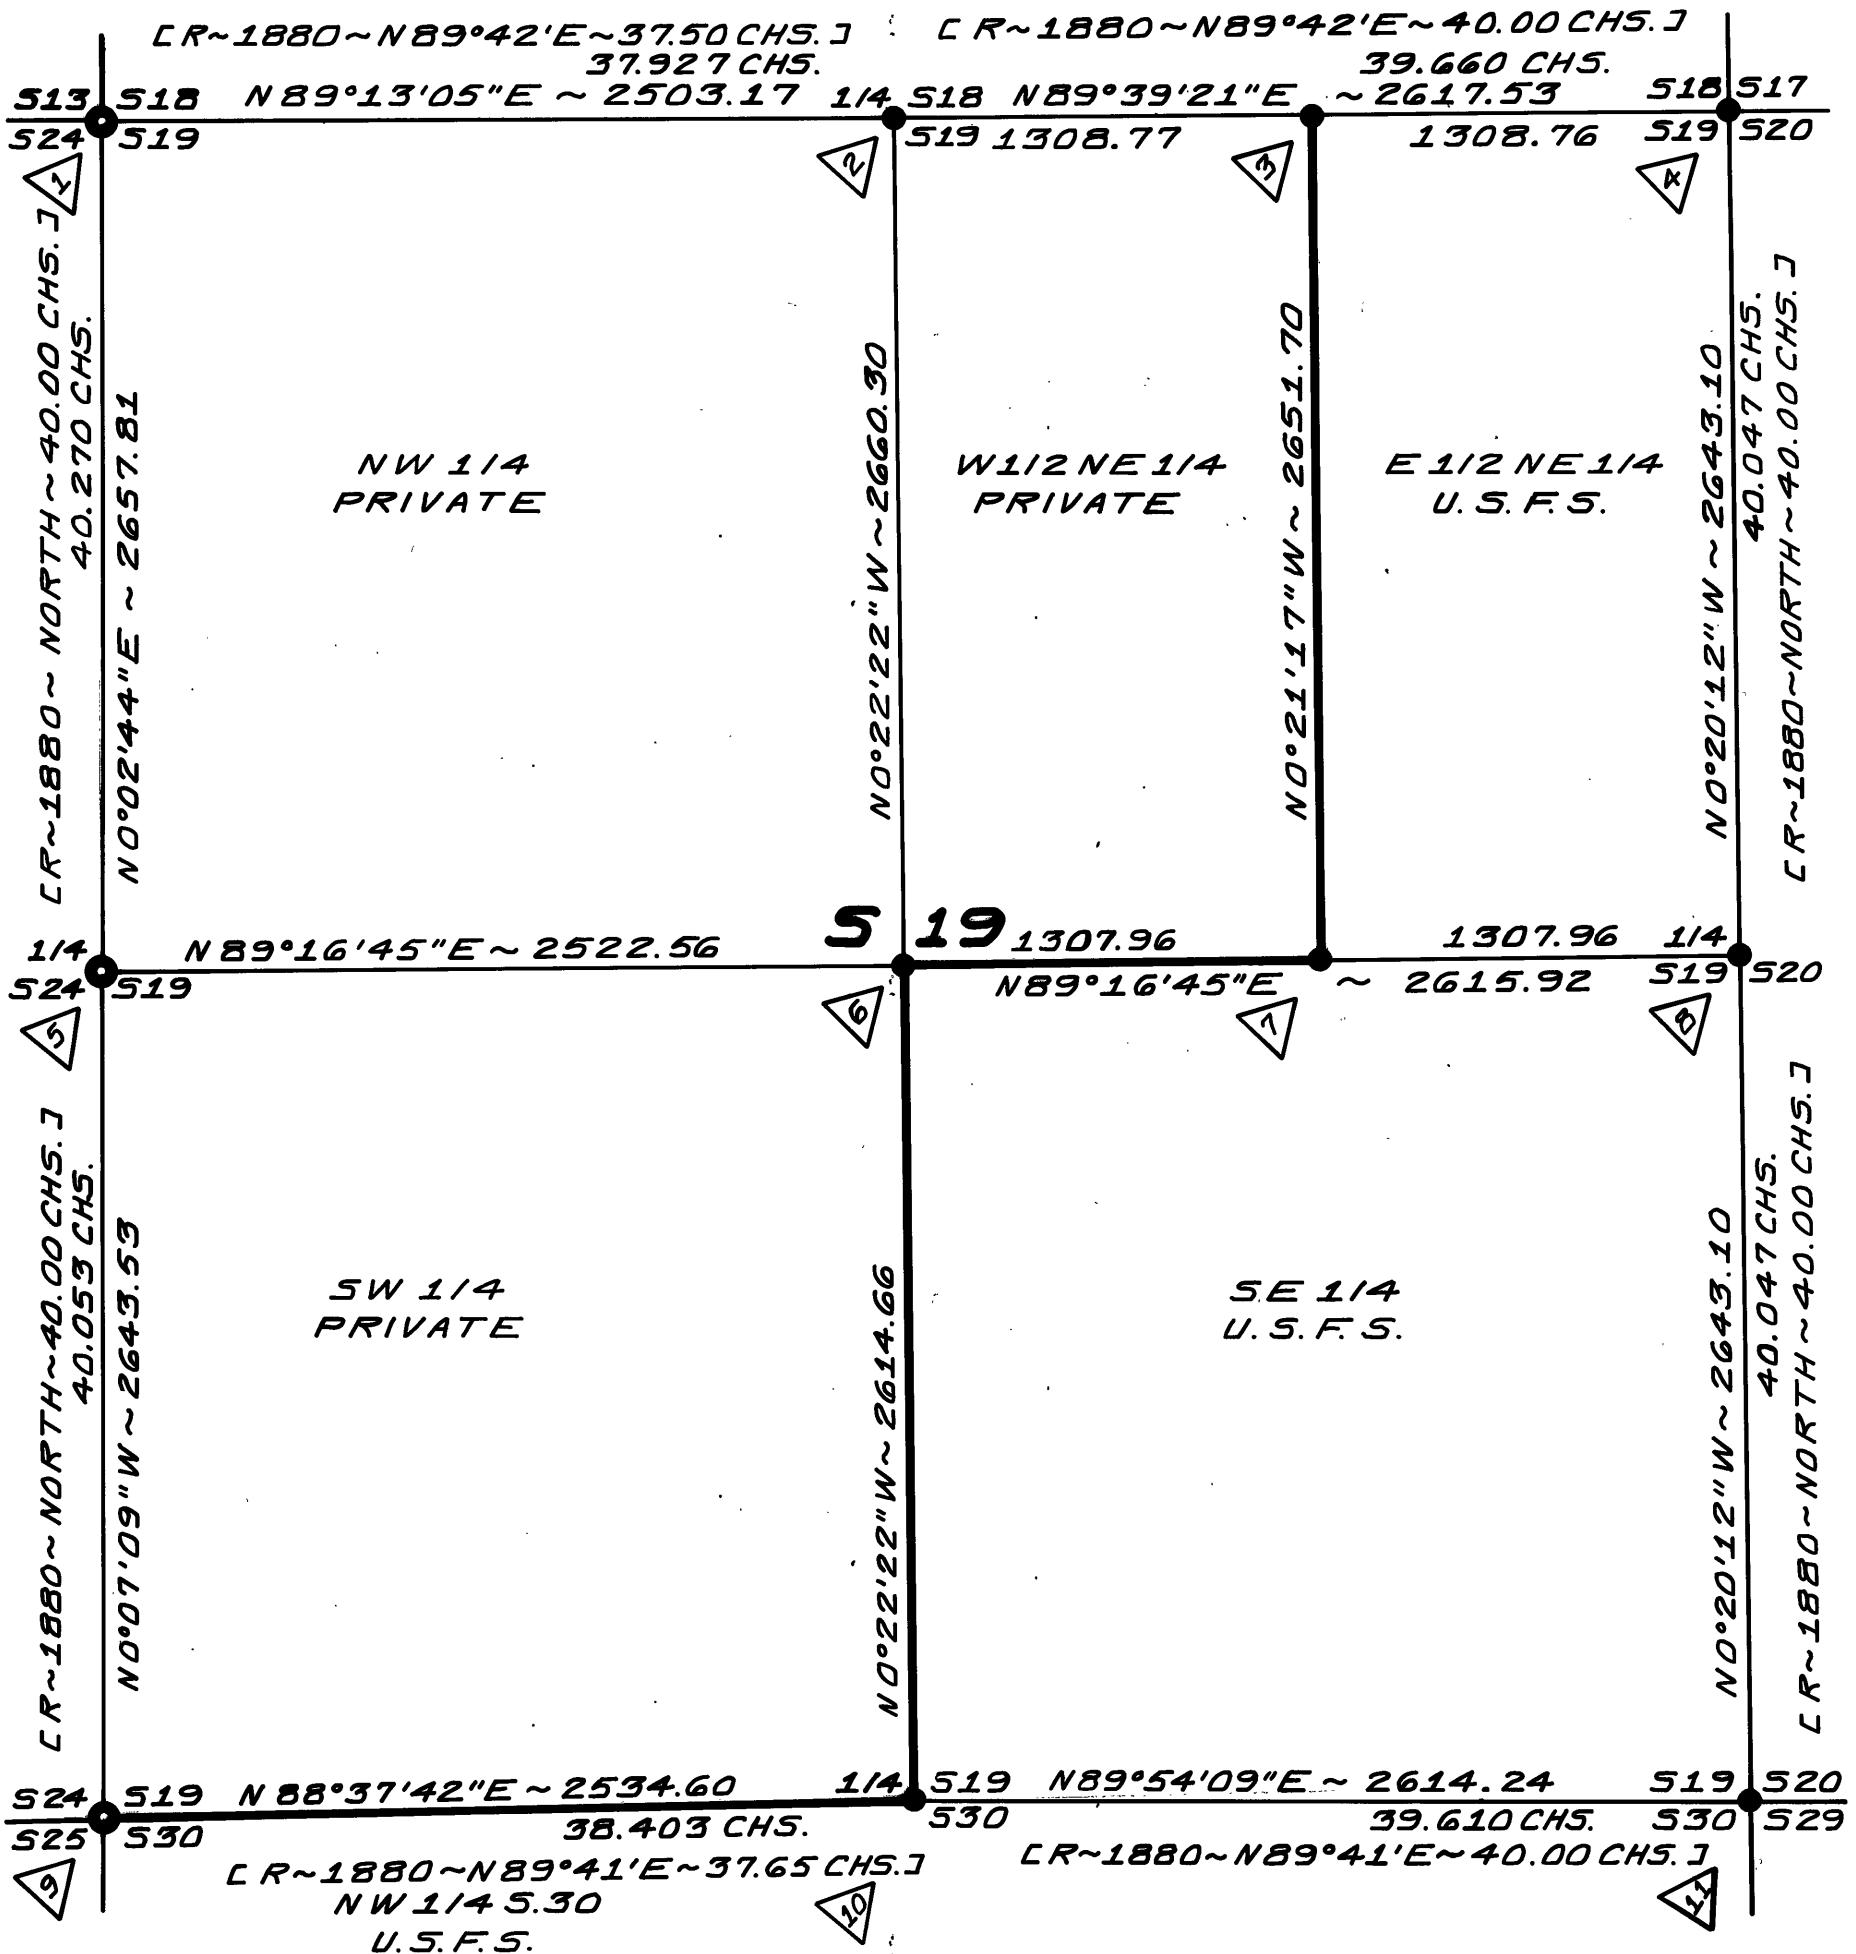


LEGEND

- SET A 2 1/2" O.D. X 30" LONG ALUMINUM PIPE WITH 3 1/4" ALUMINUM CAP MARKED AS PER CORNER DIAGRAM SHOWN ON CORNER SUMMARY.
- FOUND BRASS CAP MONUMENT BY ROBERT D. BAGETT, LS 598, GRANT COUNTY SURVEYOR, AS RECORDED APRIL 24, 1980, WITH MAP OF SURVEY NO. 611, GRANT COUNTY.
- INDICATES U.S.F.S. PROPERTY BOUNDARY POSTED UNDER THIS CONTRACT WITH 6 FOOT LONG STEEL FENCE POSTS WITH U.S.F.S. PROPERTY BOUNDARY SIGNS [54-2] ATTACHED.
- [] RECORD SURVEY INFORMATION BY BAMFORD ROBB, DEPUTY SURVEYOR, UNDER GENERAL LAND OFFICE CONTRACT NO. 366 DATED AUGUST 18, 1880.
- △ CORNER MONUMENT NUMBER ~ SEE CORNER SUMMARY FOR ADDITIONAL INFORMATION.

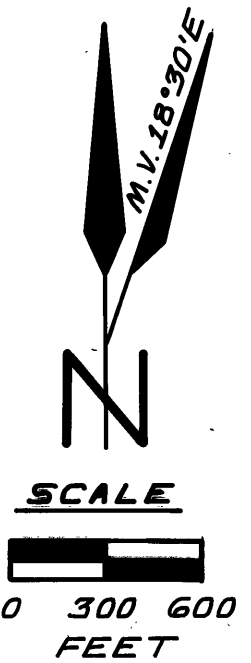

RECORDATION

OFFICE OF GRANT COUNTY SURVEYOR, STATE OF OREGON. I HEREBY CERTIFY THAT THE WITHIN INSTRUMENT WAS FILED FOR RECORD ON THE 15 DAY OF July, 1985, C.S. 877. Robert D. Bagett, GRANT COUNTY SURVEYOR

SURVEY FOR SUBDIVISION OF SECTION 19, TOWNSHIP 18 SOUTH, RANGE 29 EAST, W.M., GRANT COUNTY, OREGON. MALHEUR NATIONAL FOREST. DON CADASTRAL SURVEY ~ BURNS R.D. CONTRACT NO. 53-04H1-3-9357N. ARMSTRONG SURVEYING & ENGINEERING, INC. 378 EAST SECOND STREET PRINEVILLE, OREGON 97754 503 447-7791 SHEET 1 OF 4

REGISTERED PROFESSIONAL LAND SURVEYOR

David B. Armstrong
7/9/85 OREGON
AUGUST 22, 1975
DAVID B. ARMSTRONG
1026

W.O. 83-414E