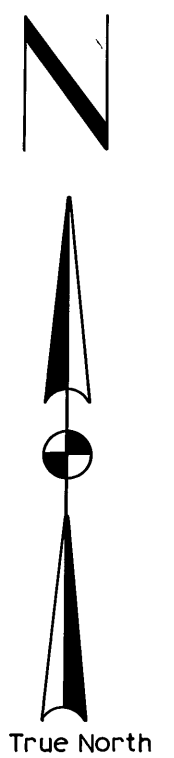


Legend

- - Monuments set this survey
- - Monuments found this survey
- AP - 2 1/2" x 30" aluminum pipe with 3 1/4" aluminum cap
- () - Original bearing and/or distance
- (()) - Bearing and/or distance as per record survey #452
- ONF - Ochoco National Forest
- PVT - Private
- Fd - Found
- Bt - Bearing tree
- MM - Mountain mahogany
- PP - Ponderosa pine
- Ch - Chains
- mos - Mound of stone
- ===== - Property line posted
- *** - Fence

T18S
R26E R27E
S13 | S18
S24 | S19
1986
RLS 166A

Fd: 20"x16"x8" stone with
3 notches south
Set: AP 8" in ground in mos
Buried original stone in
mound
Bt's: 5" Juniper N71°W-84.6'
scribed XBT
9" Juniper N71°E-170.4'
scribed XBT
17" PP S49°E-84.4'
scribed T18SR27ES19BT
16" PP S07 1/2°W-119.5'
scribed T18SR26ES24BT

NE 1/4
PVTNW 1/4
ONF

T18S
R26E R27E
S24 | S19
1986
RLS 166A

Fd: No evidence of original stone.
Set by single proportion.
Set: AP 24" in ground in mos
Bt's: 4" Juniper N09°W-115.5'
scribed 1/4S24BT
8" MM N84 1/2°E-145.0'
scribed 1/4S19BT

SE 1/4
PVTSW 1/4
ONF

T18S
R26E R27E
S24 | S19
S25 | S30
1975
PLS 598


Fd: 2 1/2" iron pipe with
brass cap in mos
Bt's: 28" PP N13°E-30.0'
partly healed face
11" PP S83°E-57.5'
dead snag
15" PP S65°W-24.0'
partly healed face
11" PP N44°W-58.6'
partly healed face
New Bt: 11" PP S55°E-101.6'
scribed T18SR27ES30BT

T18SR26E
S23 | S24
S26 | S25
1986
RLS 166A

Fd: 16"x14"x6" stone in mos with
1 notch east and 2 possible
notches south
Set: AP 6" in ground in mos. Buried
original stone in mound.
Bt's: 20" PP N61 1/2°E-15.4'
scribed T18SR26ES24BT
9" PP S70 1/2°E-49.4'
scribed T18SR26ES25BT
16" PP N03 1/2°W-39.0'
scribed T18SR26ES23BT
17" PP S35 1/2°W-36.1'
scribed T18SR26ES26BT

NW 1/4
PVTNE 1/4
PVT**Scale**

1" = 500'

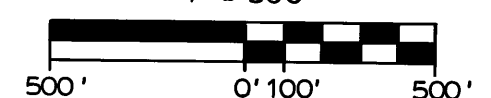

"I, Carl E. Sundet, a registered land surveyor in the State of Oregon, hereby certify that this plat and the notes hereon, or attached, are a correct representation of a survey I performed in 1986 at the request of the USDA Forest Service, in accordance with the statutes of the State of Oregon and the articles of my contract."

Carl E. Sundet Carl E. Sundet *4/13/87* Date
Registered Land Surveyor
Oregon License 1664

RECEIVED AND
FILED

JAN 16 1987

OFFICE OF COUNTY SURVEYOR
John A. Brown
Attest: *John A. Brown*REGISTERED
PROFESSIONAL
LAND SURVEYOR

Carl E. Sundet
OREGON
JULY 14, 1978
CARL E. SUNDET
1664

Map of Survey in
Sections 24 and 25, T18S. R.26 E., W.M.
Grant County, Oregon

Joel Cadastral Survey Contract # 53-04H1-5-0104N

Surveyed for : U. S. Forest Service
OCHOCO NATIONAL FOREST

Surveyed by : SUNDET AND ASSOCIATES
P.O. Box 1228
Lakeview, Oregon 97630
(503) 947-3293

Date : October - November 1986

Drawing # 395 Field book 3 Sheet 1 of 1