

Retracement of The Boundaries of
Sec. 16, T.18S R. 29E W.M.
Grant County Oregon.
May & June 1987

FOR: USDA Forest Service
BY: Douglas M. Ferguson, Ken Delano, & D. Mitchell Ferguson
DRAWN BY: Mollee Ferguson Wood


PORTION OF JOHNNIE CADASTRAL SURVEY

Ferguson Surveying
Engineering

Mt. Vernon Oregon
(phone) 932-4520

LEGEND

- Set 2 1/2" x 30" Aluminum Pipe, With 3 1/2" Aluminum Cap Stamped as Shown on the map below.
- () Record Bearing or Distance as Reported by Bamford Robb, The Original G.L.O. Surveyor.
- |||| Property Line Posted With Metal Post & Boundary Signs at Max. Intervals of 250.
- X—X Fence Line.
- X---X Down Fence Line.

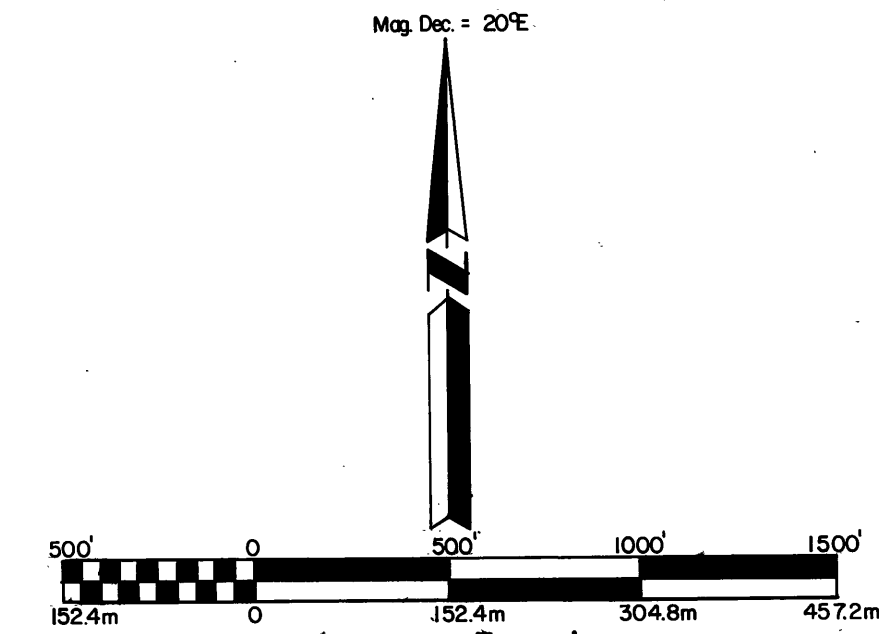

SCALE: 1"=500'

BASIS OF BEARINGS
SOLAR OBSERVATION WITH TRUE MERIDIAN
THROUGH CENTER LINE OF SECTION.

HISTORY

The Subdivision of T.18S., R.29E., was originally surveyed by Bamford Robb, in 1880, under General Land Office Contract No. 366. There is no other survey work shown of record in the Grant County Surveyors Office.

NARRATIVE

This Survey is performed under contract for the Malheur National Forest, the purpose of which is the establishment and marking of the Forest Boundary, as shown on this Map.

The Boundaries of Sections 16 are retraced and all the corners are found except the North and South 1/4 corners. Those corners are reestablished at proportionate measure between the section corners as found 1/2 mi. East and West thus establishing the boundaries of the section, which are also the property boundaries required in this survey.

The "CERTIFIED RECORD OF LAND CORNER MONUMENTATION" forms as referenced to this Map and the notes shown on the Map should be considered a substantial part of this "NARRATIVE", as they contain the detailed information as to the evaluation of evidence found and monumentation work performed.

Positional control for this survey is provided by a closed traverse network. LIETZ SDM 3E, Electronic tachometer is used to obtain the measurements and HP-86B computer system is used to perform the computations. Field Notes and computations are on file in the office of "FERGUSON SURVEYING & ENGINEERING", Mt. Vernon Oregon.

I, Douglas M. Ferguson, Registered Professional Land Surveyor, in the State of Oregon, hereby certify that this plat, notes and records hereon or referenced are a correct representation of the survey I performed during, May & June of 1987 for the U.S. Forest Service, in accordance with the statutes of the State of Oregon and the articles of my contract, No. 53-04H1-6-0123N.

Douglas M. Ferguson, Or. PLS 848.

NOTE: Monuments as shown in the LEGEND are stamped as shown on the map, new Bearing Trees are taken & scribed as shown. Bearing Tree signs nailed above blaze, Warning signs nailed on back, brass washers stamped RLS 848 nailed on blaze above the BT scribing & painted a 6" red band around each tree.

REGISTERED
PROFESSIONAL
LAND SURVEYOR

OREGON
JULY 18, 1988
DOUGLAS M. FERGUSON
848

RECEIVED AND
FILED

OCT 2 1987

OFFICE OF COUNTY SURVEYOR
Grant County, Oregon
Michael W. Pyle

