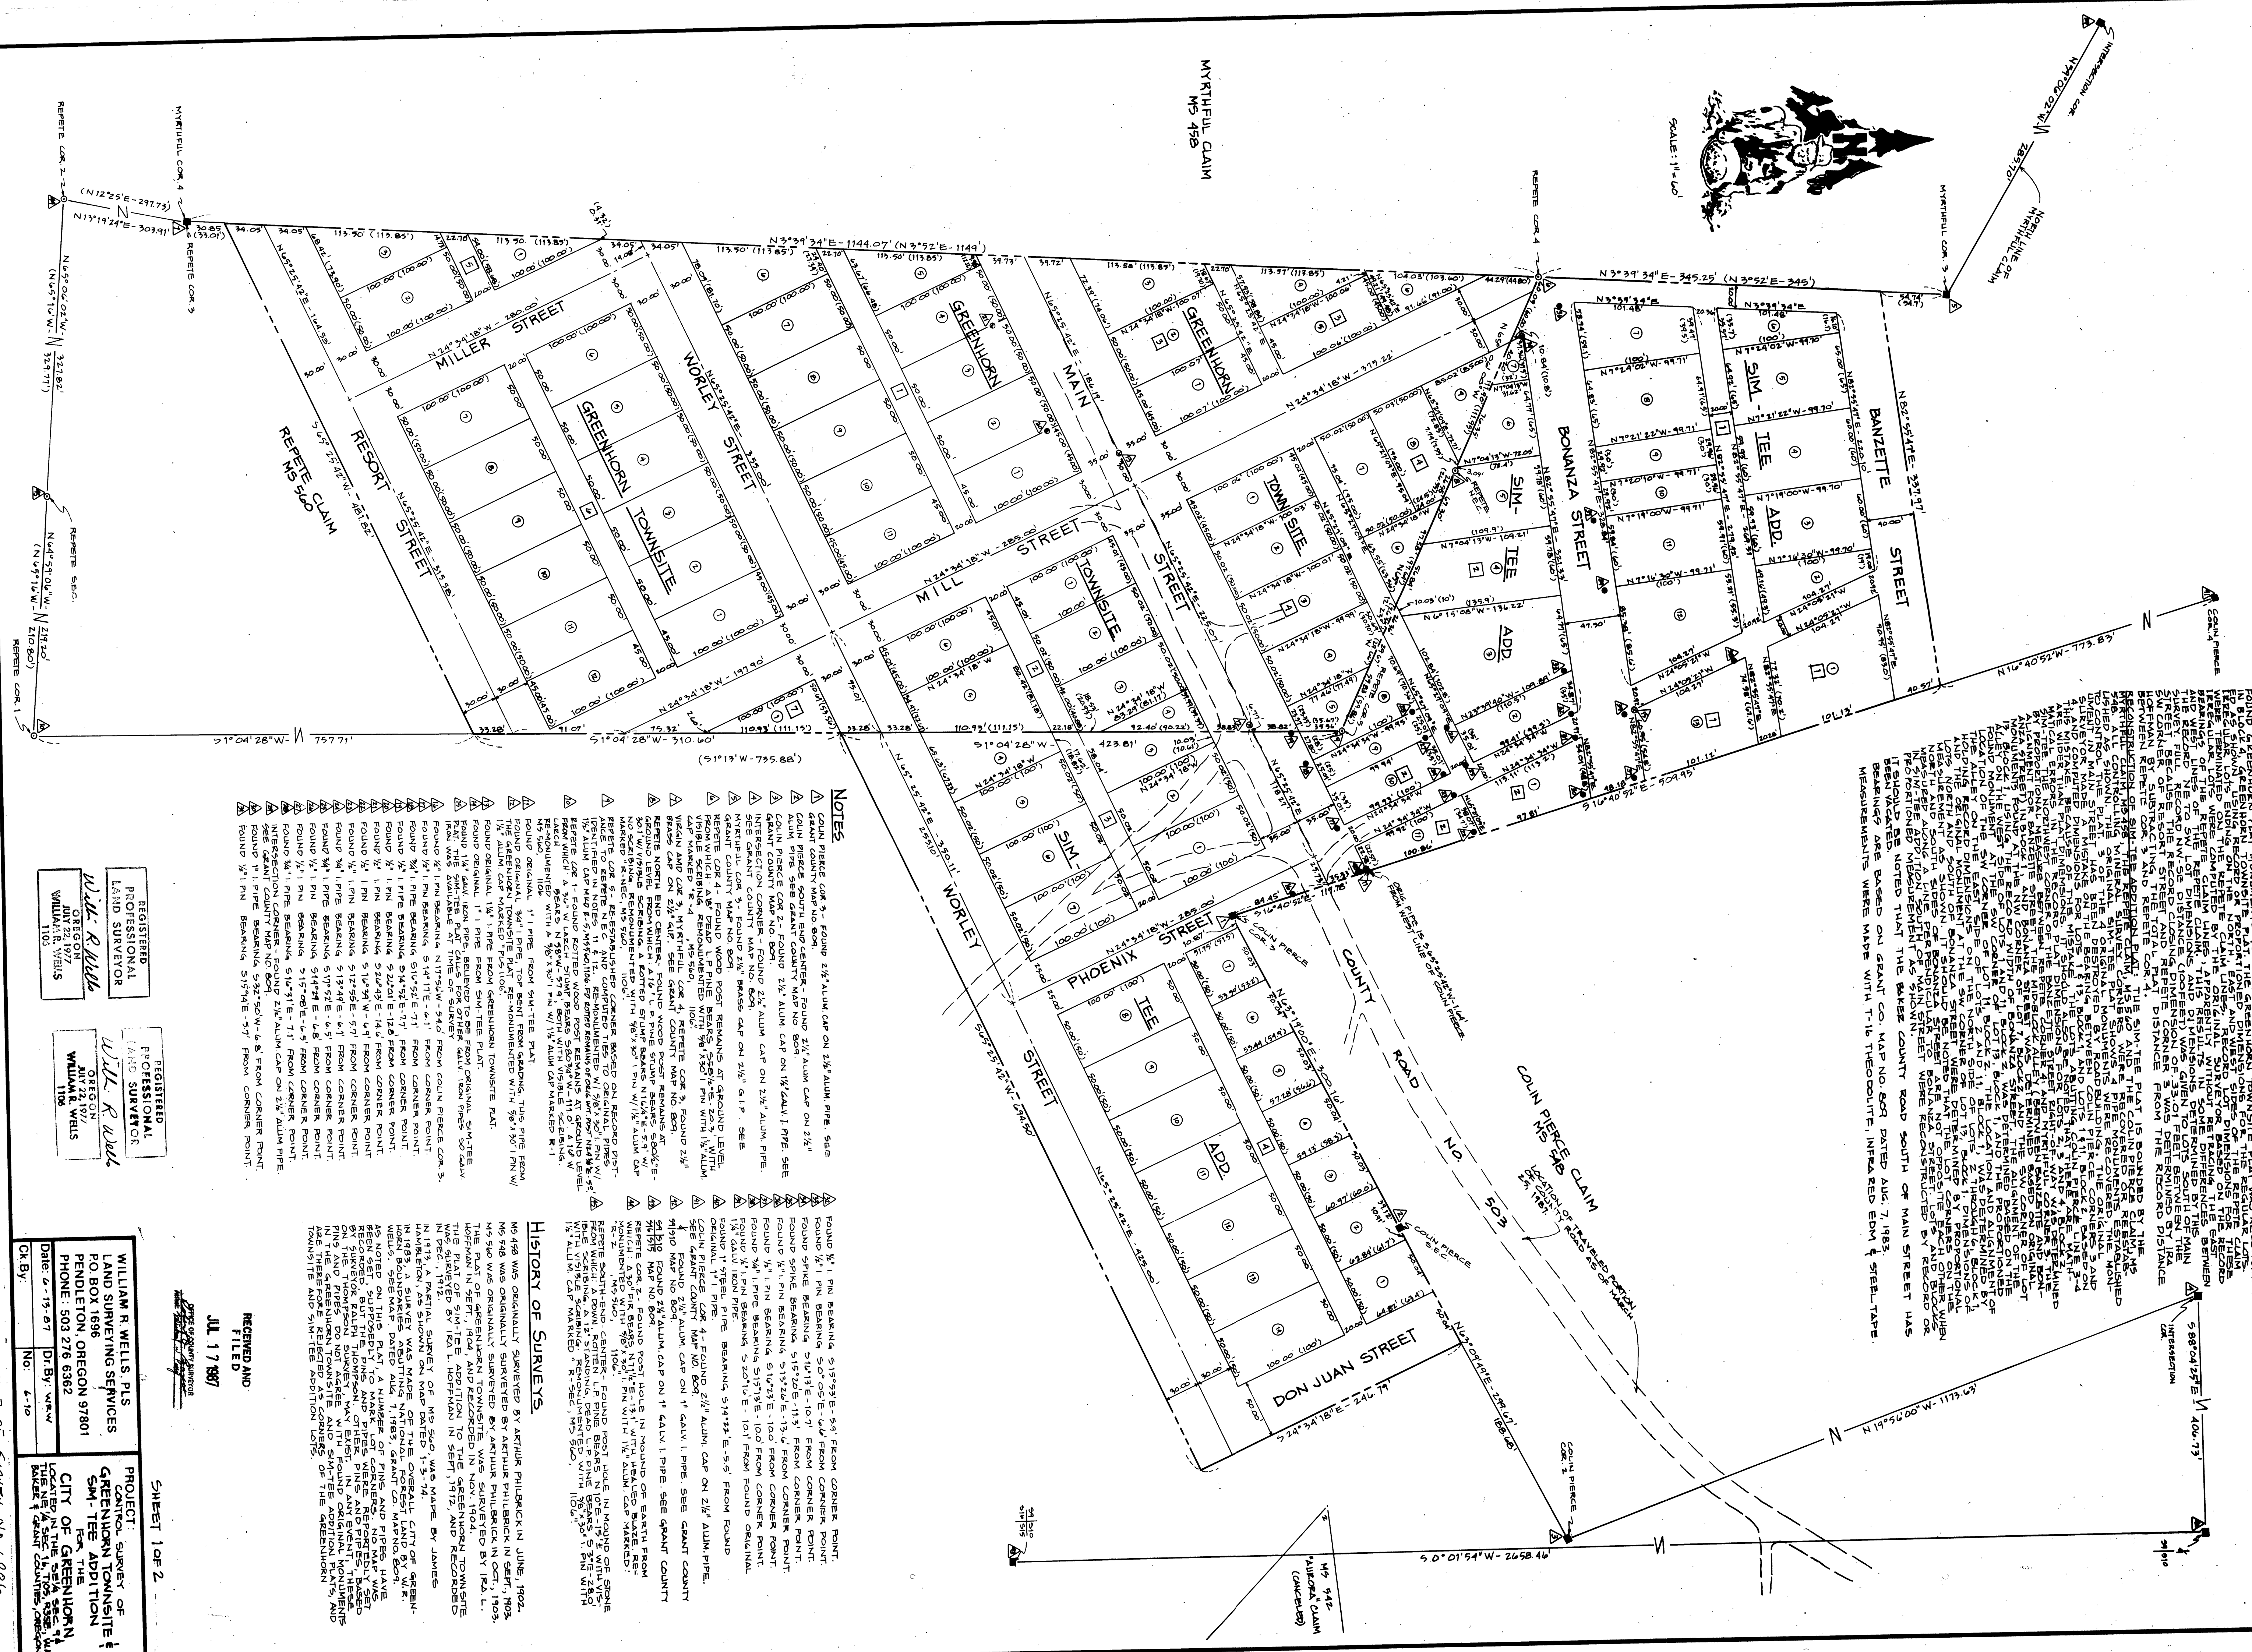


- - FOUND CORNER AS NOTED - SEE NOTES.
- - FOUND CORNER AS NOTED - SEE NOTES.
- - FOUND ORIGINAL CORNER FROM GREENHORN TOWNSITE OR SIXTH PLAT - SEE NOTES.
- ◉ - FOUND OR RE-ESTABLISHED REFERENCE MEASUREMENT CORNER - SEE NOTES.
- ◊ - FOUND OUT-OF-POSITION AND UNRECORDED TIE, PIPE OR STRIKE - SEE NOTES.
- - LOT NUMBERS
- ⊖ - BLOCK NUMBERS
- △ - SEE NOTE INDEXED BY NUMBER.
- (x,y) - RECORD BEARINGS AND DISTANCES.

LEGEND

■ - FOUND

● - FOUND

[illegible]

FINALLY SURVEY





RECEIVED AND
FILED

JUL 17 1987

SHEET 1 OF 2

MAP OF SURVEY NO. 1006

MAP OF SURVEY NO. 1006