


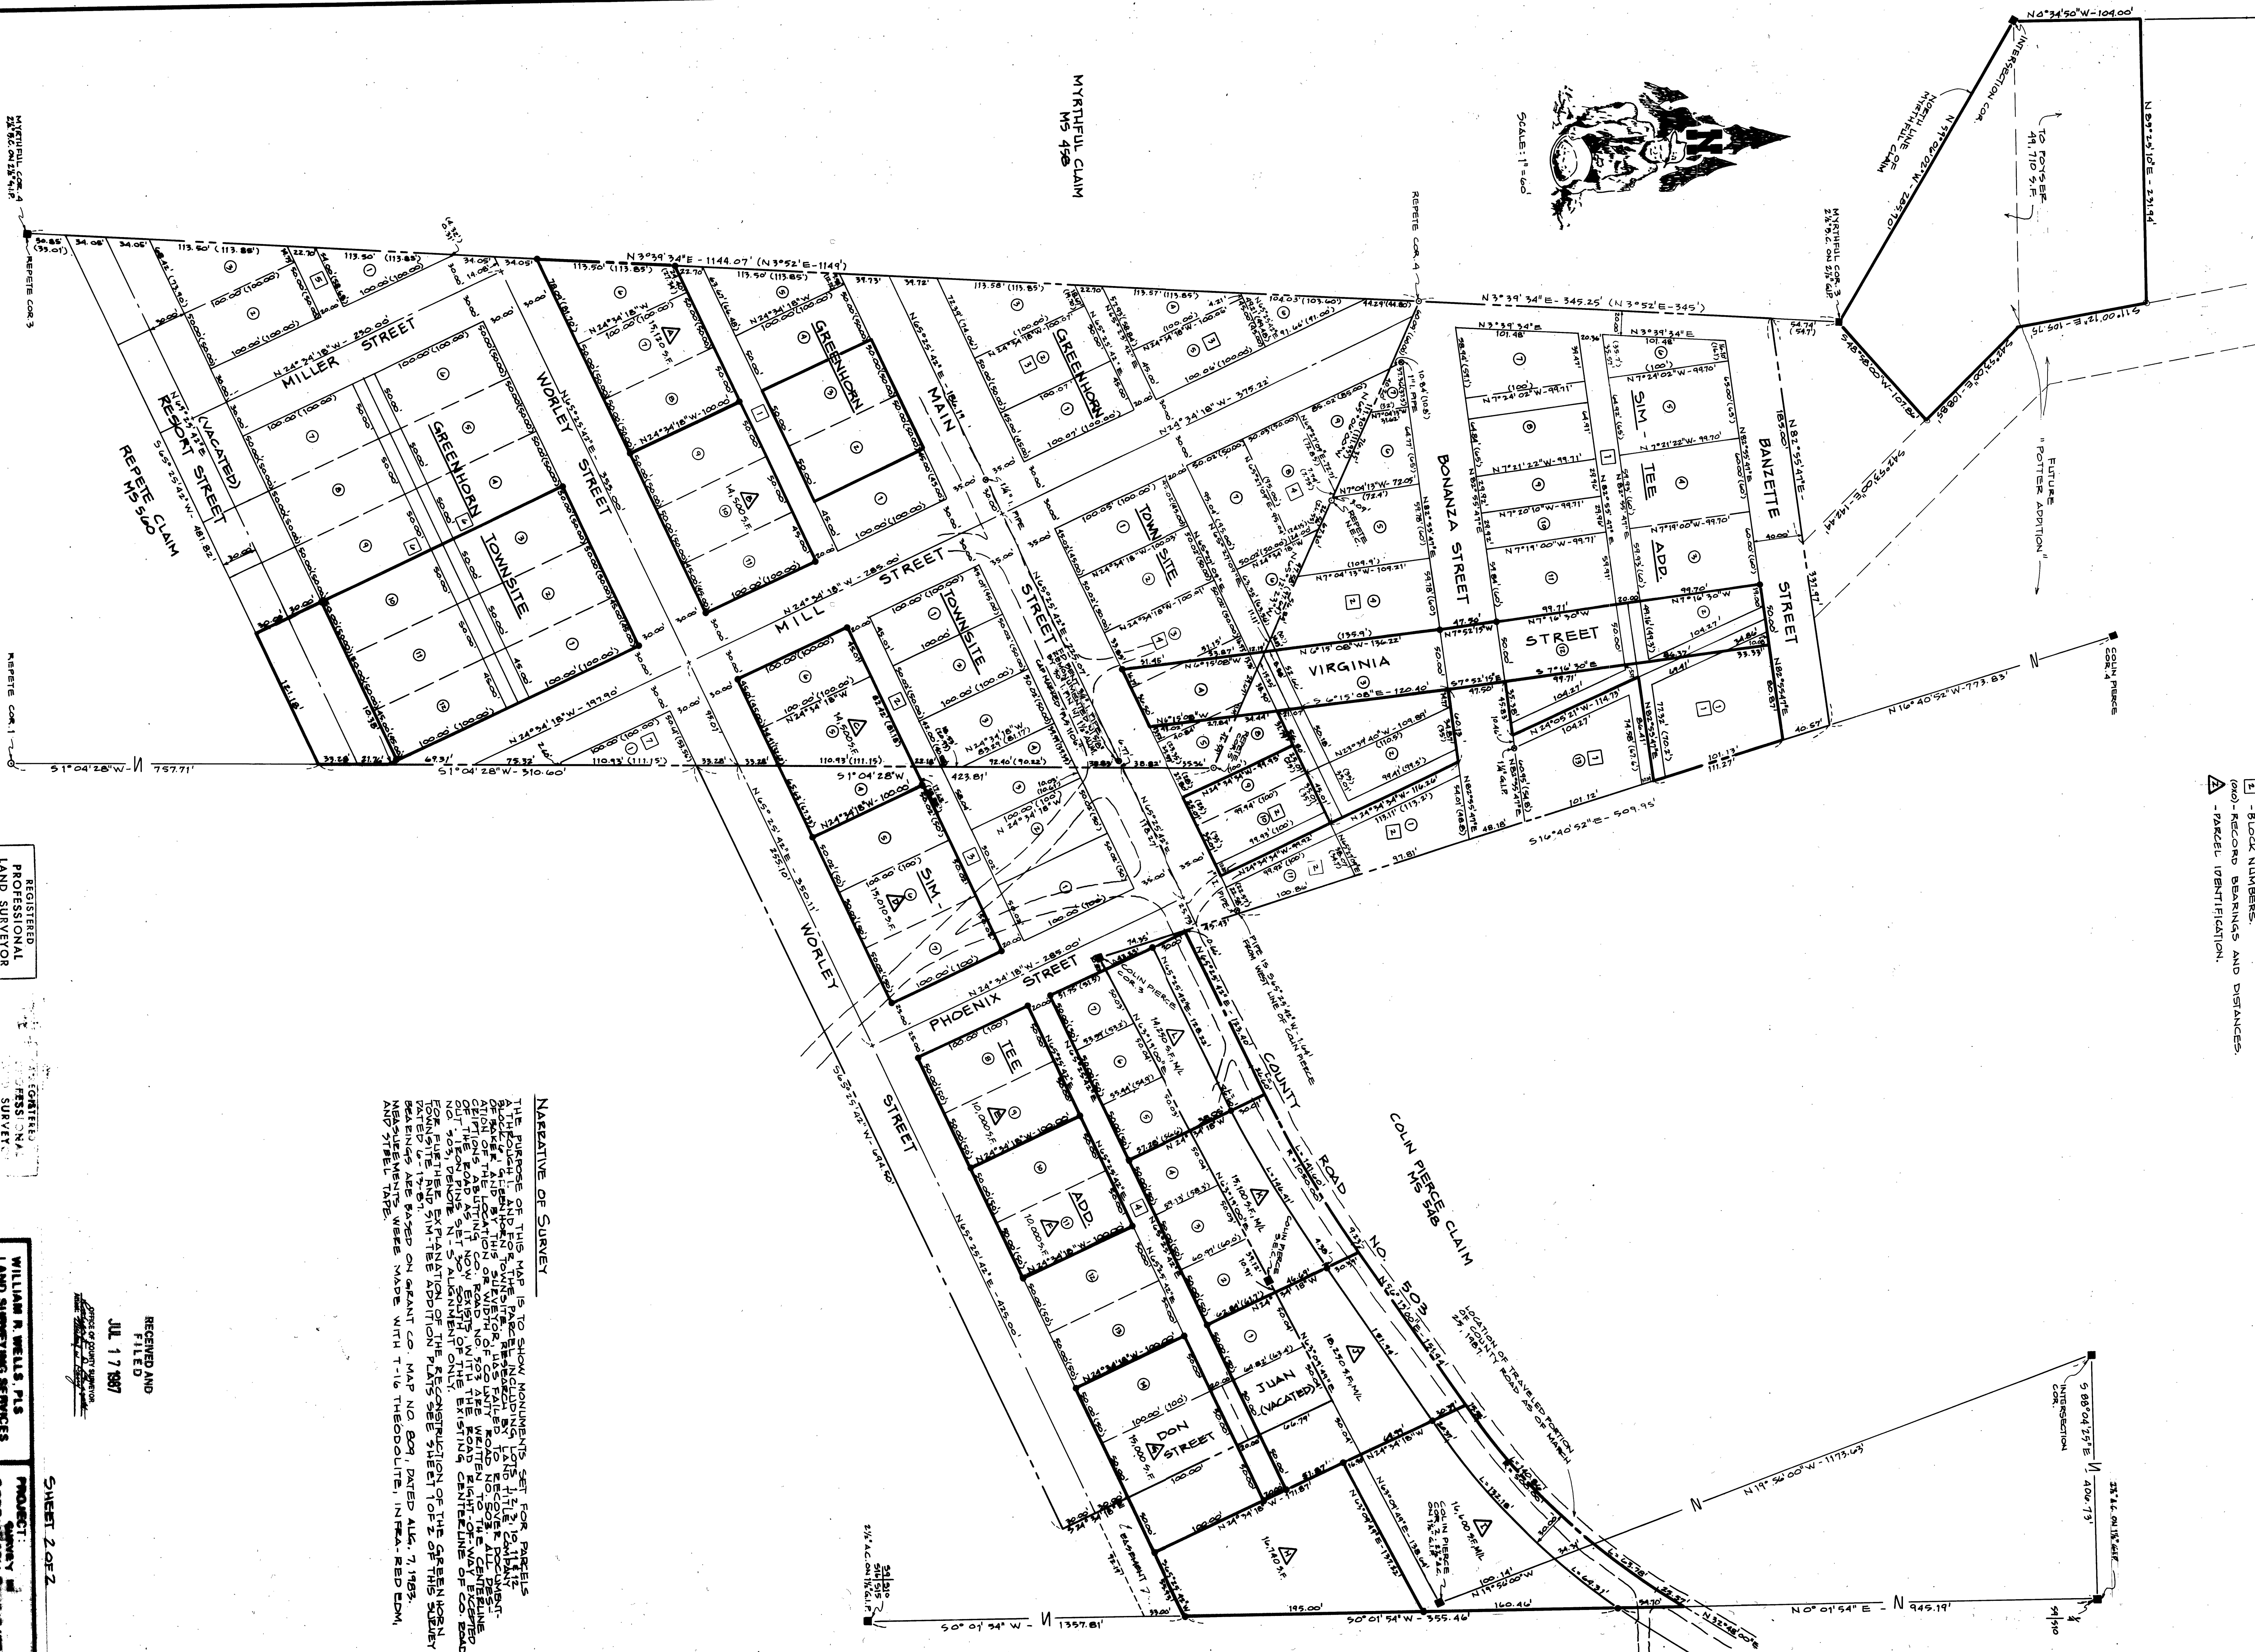

LEGEND

- - POUND CAPS - 2 1/2" ALUM CAP ON 2 1/2" ALUM PIPE. UNLESS OTHERWISE NOTED.
- - POUND ORIGINAL CORNER FROM GREENHOUSE TOWNSITE OR SIX-TEE PLAT.
- - POUND ORIGINAL CORNER FROM GREENHOUSE TOWNSITE OR SIX-TEE PLAT.
- - 1/2" DIA. DISTINGUISHED SQUARE, MS SMO CORNER - REMOVED/UNIDENTIFIED WITH CORNER. MS5000 & REG. NO. 1106
- - 1/2" DIA. 1" PIN WITH 1/2" ALUM CAP MARKED WITH CORNER.
- - 1/2" 3/8"x3.0" PIN WITH YELLOW PLASTIC CAP MARKED "W.R. WELLS - 175-1106".
- ① - BLOCK NUMBERS.
- ② - BLOCK NUMBERS.
- ③ - RECORD BEARINGS AND DISTANCES.
- ④ - PARCEL IDENTIFICATION.

NARRATIVE OF SURVEY

THE PURPOSE OF THIS MAP IS TO SHOW MONUMENTS SET FOR PARCELS BLOCKED BY GREENWICH TOWNSHIP PARK INCLUDING LOTS 1123, 1016, 1127 AND 1128. THE MONUMENTS WERE PLACED IN ACCORDANCE WITH THE RESEARCH BY TAD BROWN, AGRICULTURAL ENGINEER, GREENWICH TOWNSHIP, ON THE BASIS OF AN ANALYSIS OF THE LOCATION OR WIDTH OF COUNTRY ROAD NO. 503. ALL DEPT. OF HIGHWAYS RECORDS HAVE BEEN CHECKED AND IT WAS DETERMINED THAT SECTIONS ALLETTING CO. ROAD NO. 503 ARE WRITTEN ON THE QUARTERLY MAPS OF THE TOWNSHIPS SET SOUTH OF THE EXISTING CENTERLINE OF CO. ROAD NO. 503, THEREIN IS ALIGNMENT ONLY.

FOR FURTHER EXPLANATION OF THE RECONSTRUCTION OF THE GREENWICH TOWNSHIP PARK MAP THE ADDITION OF THE SHEET 1 OF THIS SURVEY BEING A-17-B-1.

DATED DEC. 1983.

BEARING ARE BASED ON GRANT CO. MAP NO. 804, DATED AUG. 7, 1983.

ALL DISTANCES WERE MEASURED BY THEO. J. HARRIS.

MONUMENTS WERE MADE WITH T-16, THEODOLITE, INFRA-RED EDM,
AND STREEL TAPE.

RECEIVED AND
FILED

JUL 17 1987

OFFICE OF COUNTY SUPERVISOR.
 APPROVED: William W. Barry

**REGISTERED
PROFESSIONAL
LAND SURVEYOR**

Willi R. Wells

REGISTERED
PROFESSIONAL
LAND SURVEYOR

Wills: R. Wells

WILLIAM R. WELLS, PLS
LAND SURVEYING SERVICES
PO. BOX 1696
PENDLETON, OREGON 97801
PHONE: 503 276 6362

Date: 6-19-87 Dr. By: wvw

WILLIAM R. WELLS, PLS
LAND SURVEYING SERVICES
PO. BOX 1696
PENDLETON, OREGON 97801
PHONE: 503 276 6362

Date: 6-19-87 Dr. By: wvw

PROJECT:

SHEET 2 OF 2