


Point being 415.24 feet North and 1184.59 feet West of the SE corner of Sec. 24, T16S, R30E, W.M., monumented with an aluminum pipe and cap, as set in Survey No. 940.

NARRATIVE: This survey was performed for and under contract to RCA, Camden, New Jersey. The purpose of this survey was to delineate the 700 foot by 700 foot tract of land from the Crown Ranch as shown hereon. A search was made of the available records pertaining to this survey. Field measurements were made to locate existing monuments and County Road No. 64. New monuments were set at the locations shown hereon as specified by RCA and the landowner, Jerry Carter. My research disclosed that the County Court declared County Road No. 64 a public highway in 1899, as recorded in Commissioners Journal Book E, page 152. This road has a standard 60 foot right of way. This survey is tied to the Southeast corner of Section 24, T16S, R30E as established by L.L. Myers, OPLS No. 699. See Record Map of Survey No. 940. I found no unusual conditions with this survey.

BASIS OF BEARING
SOLAR OBSERVATION
MAGNETIC DECLINATION 20° EAST

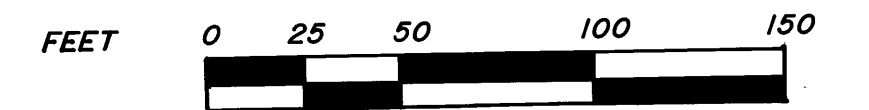

LEGEND

- Set 5/8"x30" Iron pin with plastic cap marked BGA SURVEY MARKER
- Existing Fence

REFERENCES

Commissioners Journal Book E, Page 152.
Deeds Book 131 Page 139
Map of Survey No. 940

REGISTERED
PROFESSIONAL
LAND SURVEYOR

Robert D. Baggett

OREGON
JULY 12, 1983
ROBERT D. BAGGETT
598

RECEIVED AND
FILED
AUG 26 1987
OFFICE OF COUNTY SURVEYOR
Robert D. Baggett

BAGETT - GRIFFITH & ASSOCIATES
John Day, Oregon
MAP OF SURVEY
PROPOSED GWEN RELAY NODE SITE NO. 898
SENECA, OREGON
SITUATED IN THE SE1/4SE1/4 SEC. 24, & THE
NE1/4NE1/4 SEC. 25, T16S, R30E, W.M.
GRANT COUNTY, OREGON

SURVEYED FOR	RCA, CAMDEN, NEW JERSEY	
SURVEYED BY	RDB, MWP, & WGH	7/14/87
Scale: 1"=50'	Drawn by: MWP	7/20/87