


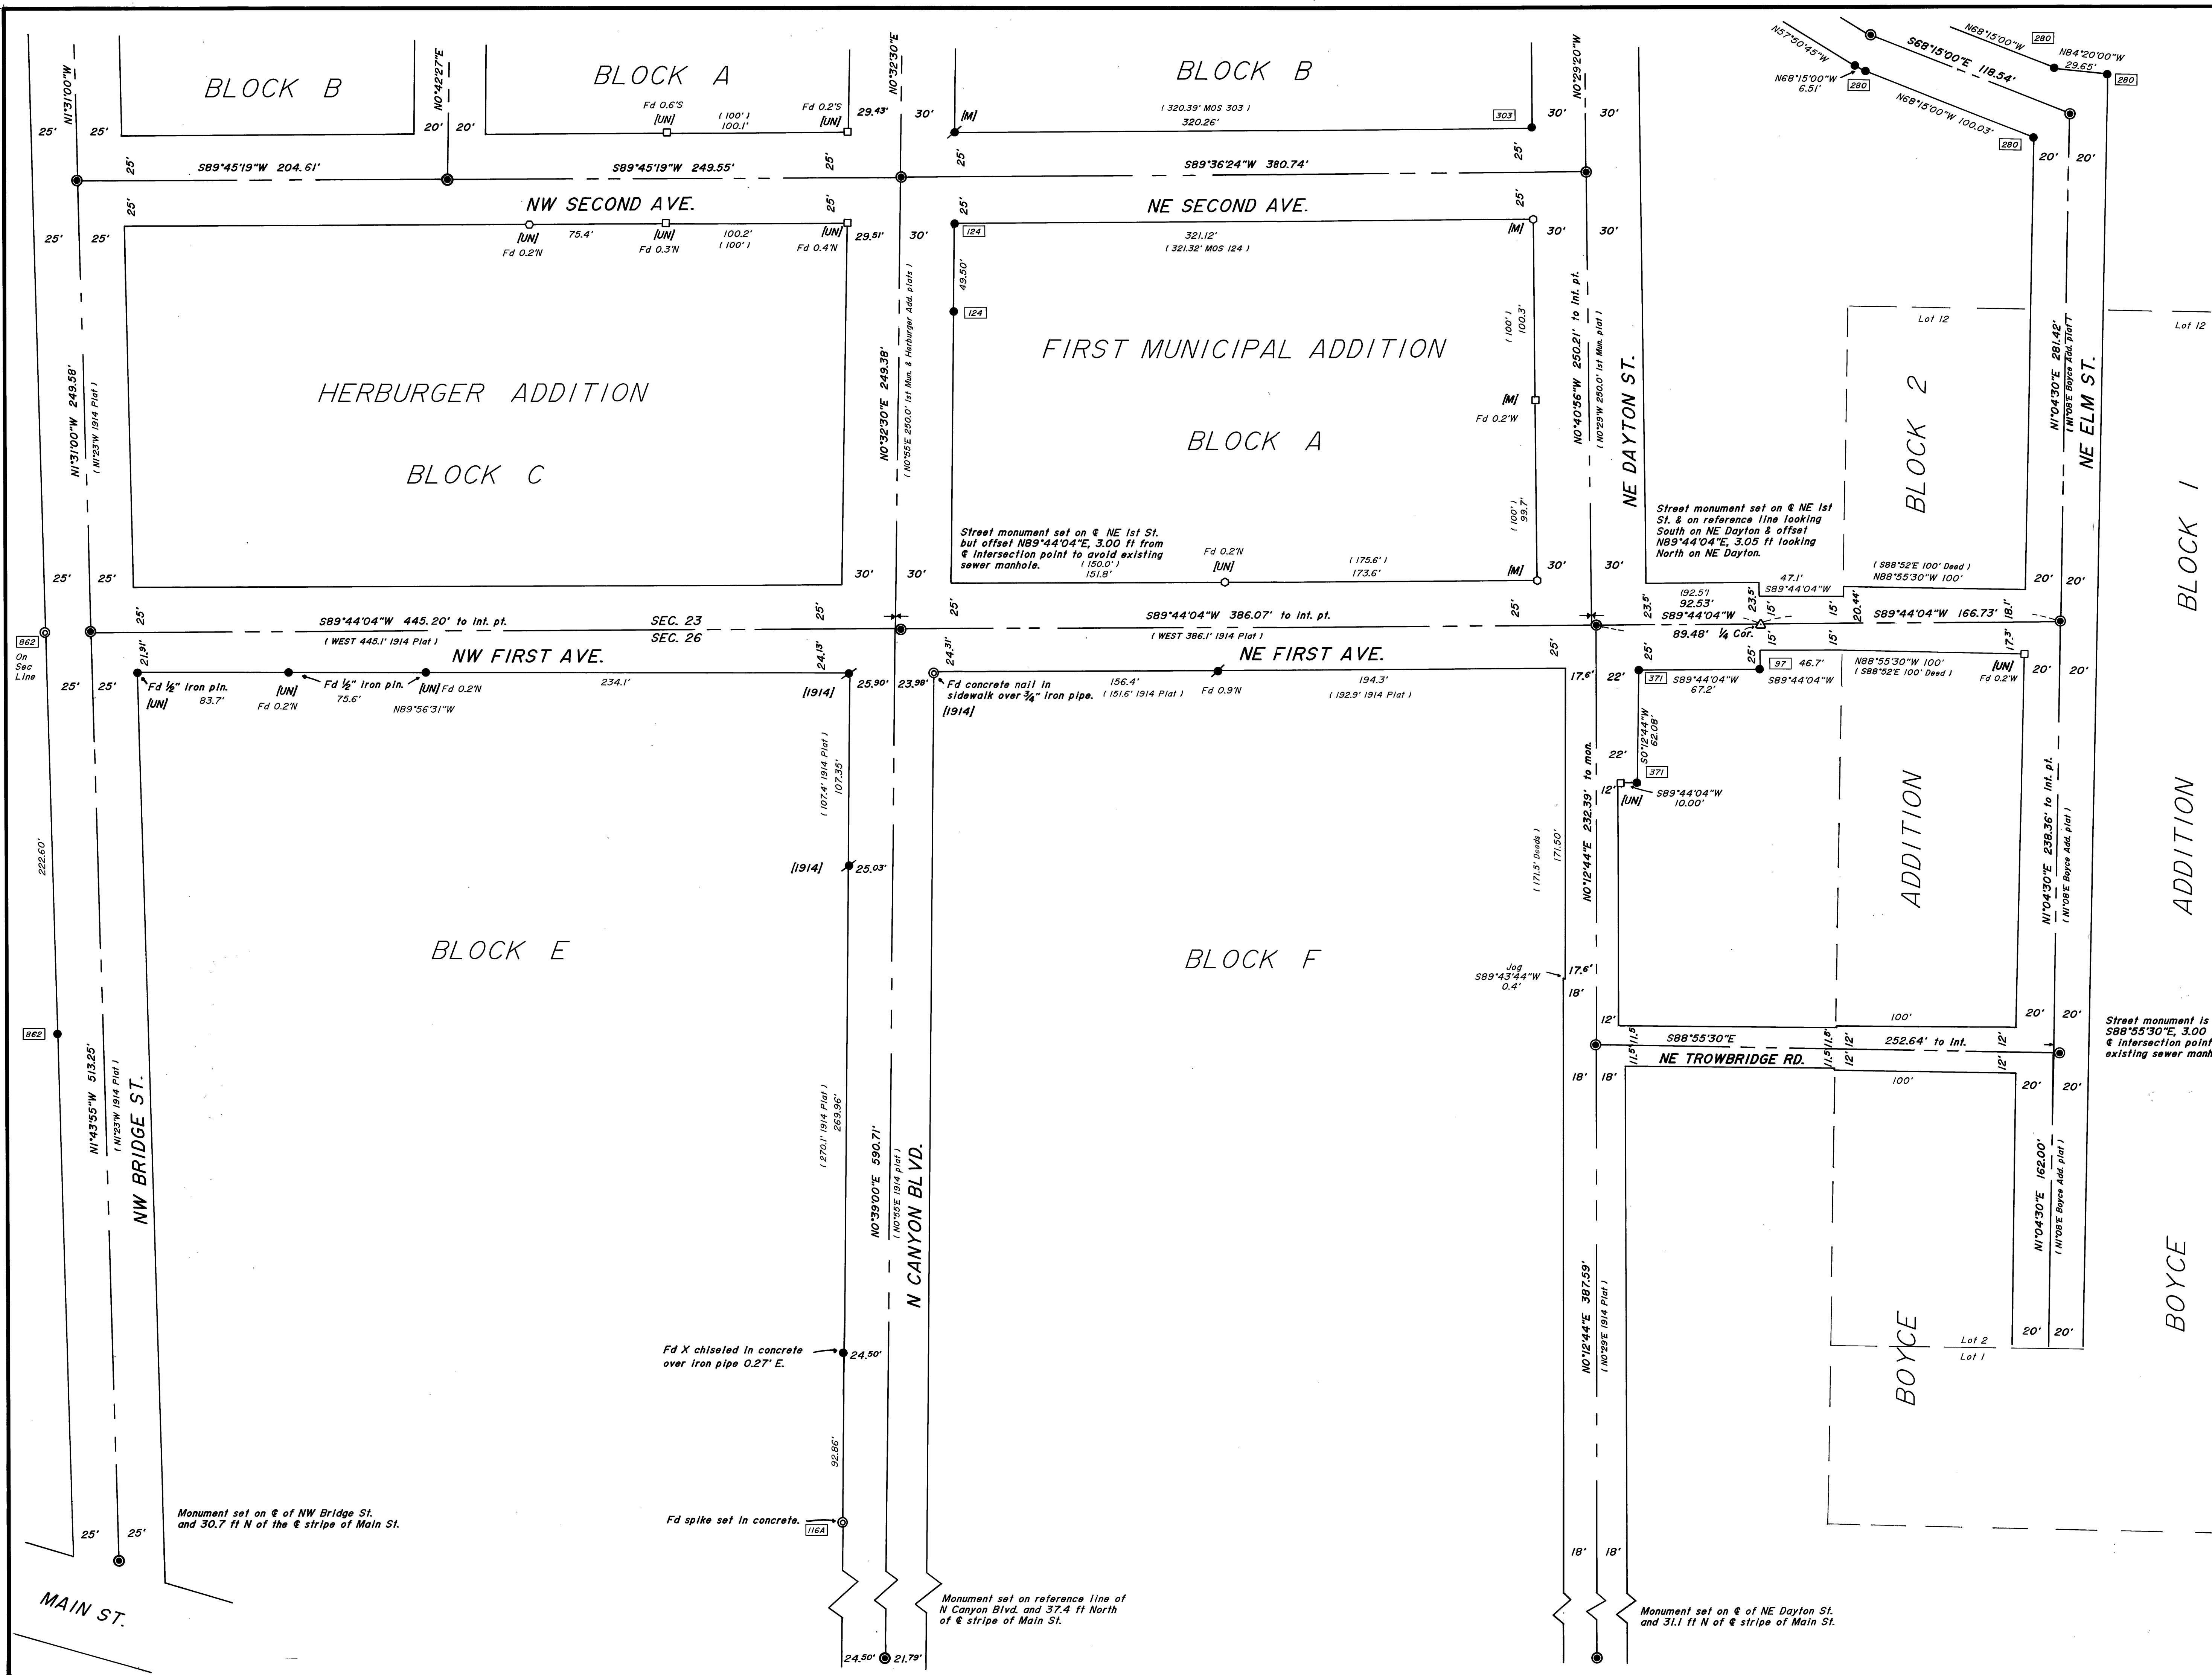

BASIS OF BEARING
SOLAR OBSERVATION

RECEIVED AND
FILED
AUG 26 1987
OFFICE OF COUNTY CLERK
Attest: *[Signature]*

REGISTERED
PROFESSIONAL
LAND SURVEYOR
Robert D. Baggett
OREGON
JULY 12, 1983
ROBERT D. BAGGETT
598

SHEET 2 OF 2

BAGETT-GRIFFITH & ASSOCIATES John Day, Oregon MAP OF SURVEY Of NE John Day Street Monumentation Project Situated in the S½ Sec. 23 and in the N½ Sec. 26 T13S, R31E, W.M. GRANT COUNTY, OREGON		
SURVEYED FOR	CITY OF JOHN DAY, OREGON	
SURVEYED BY	RDB, MWP, & WGH	6/87/87
Scale: 1"=40'	Drawn by: MWP&WGH	8/87