


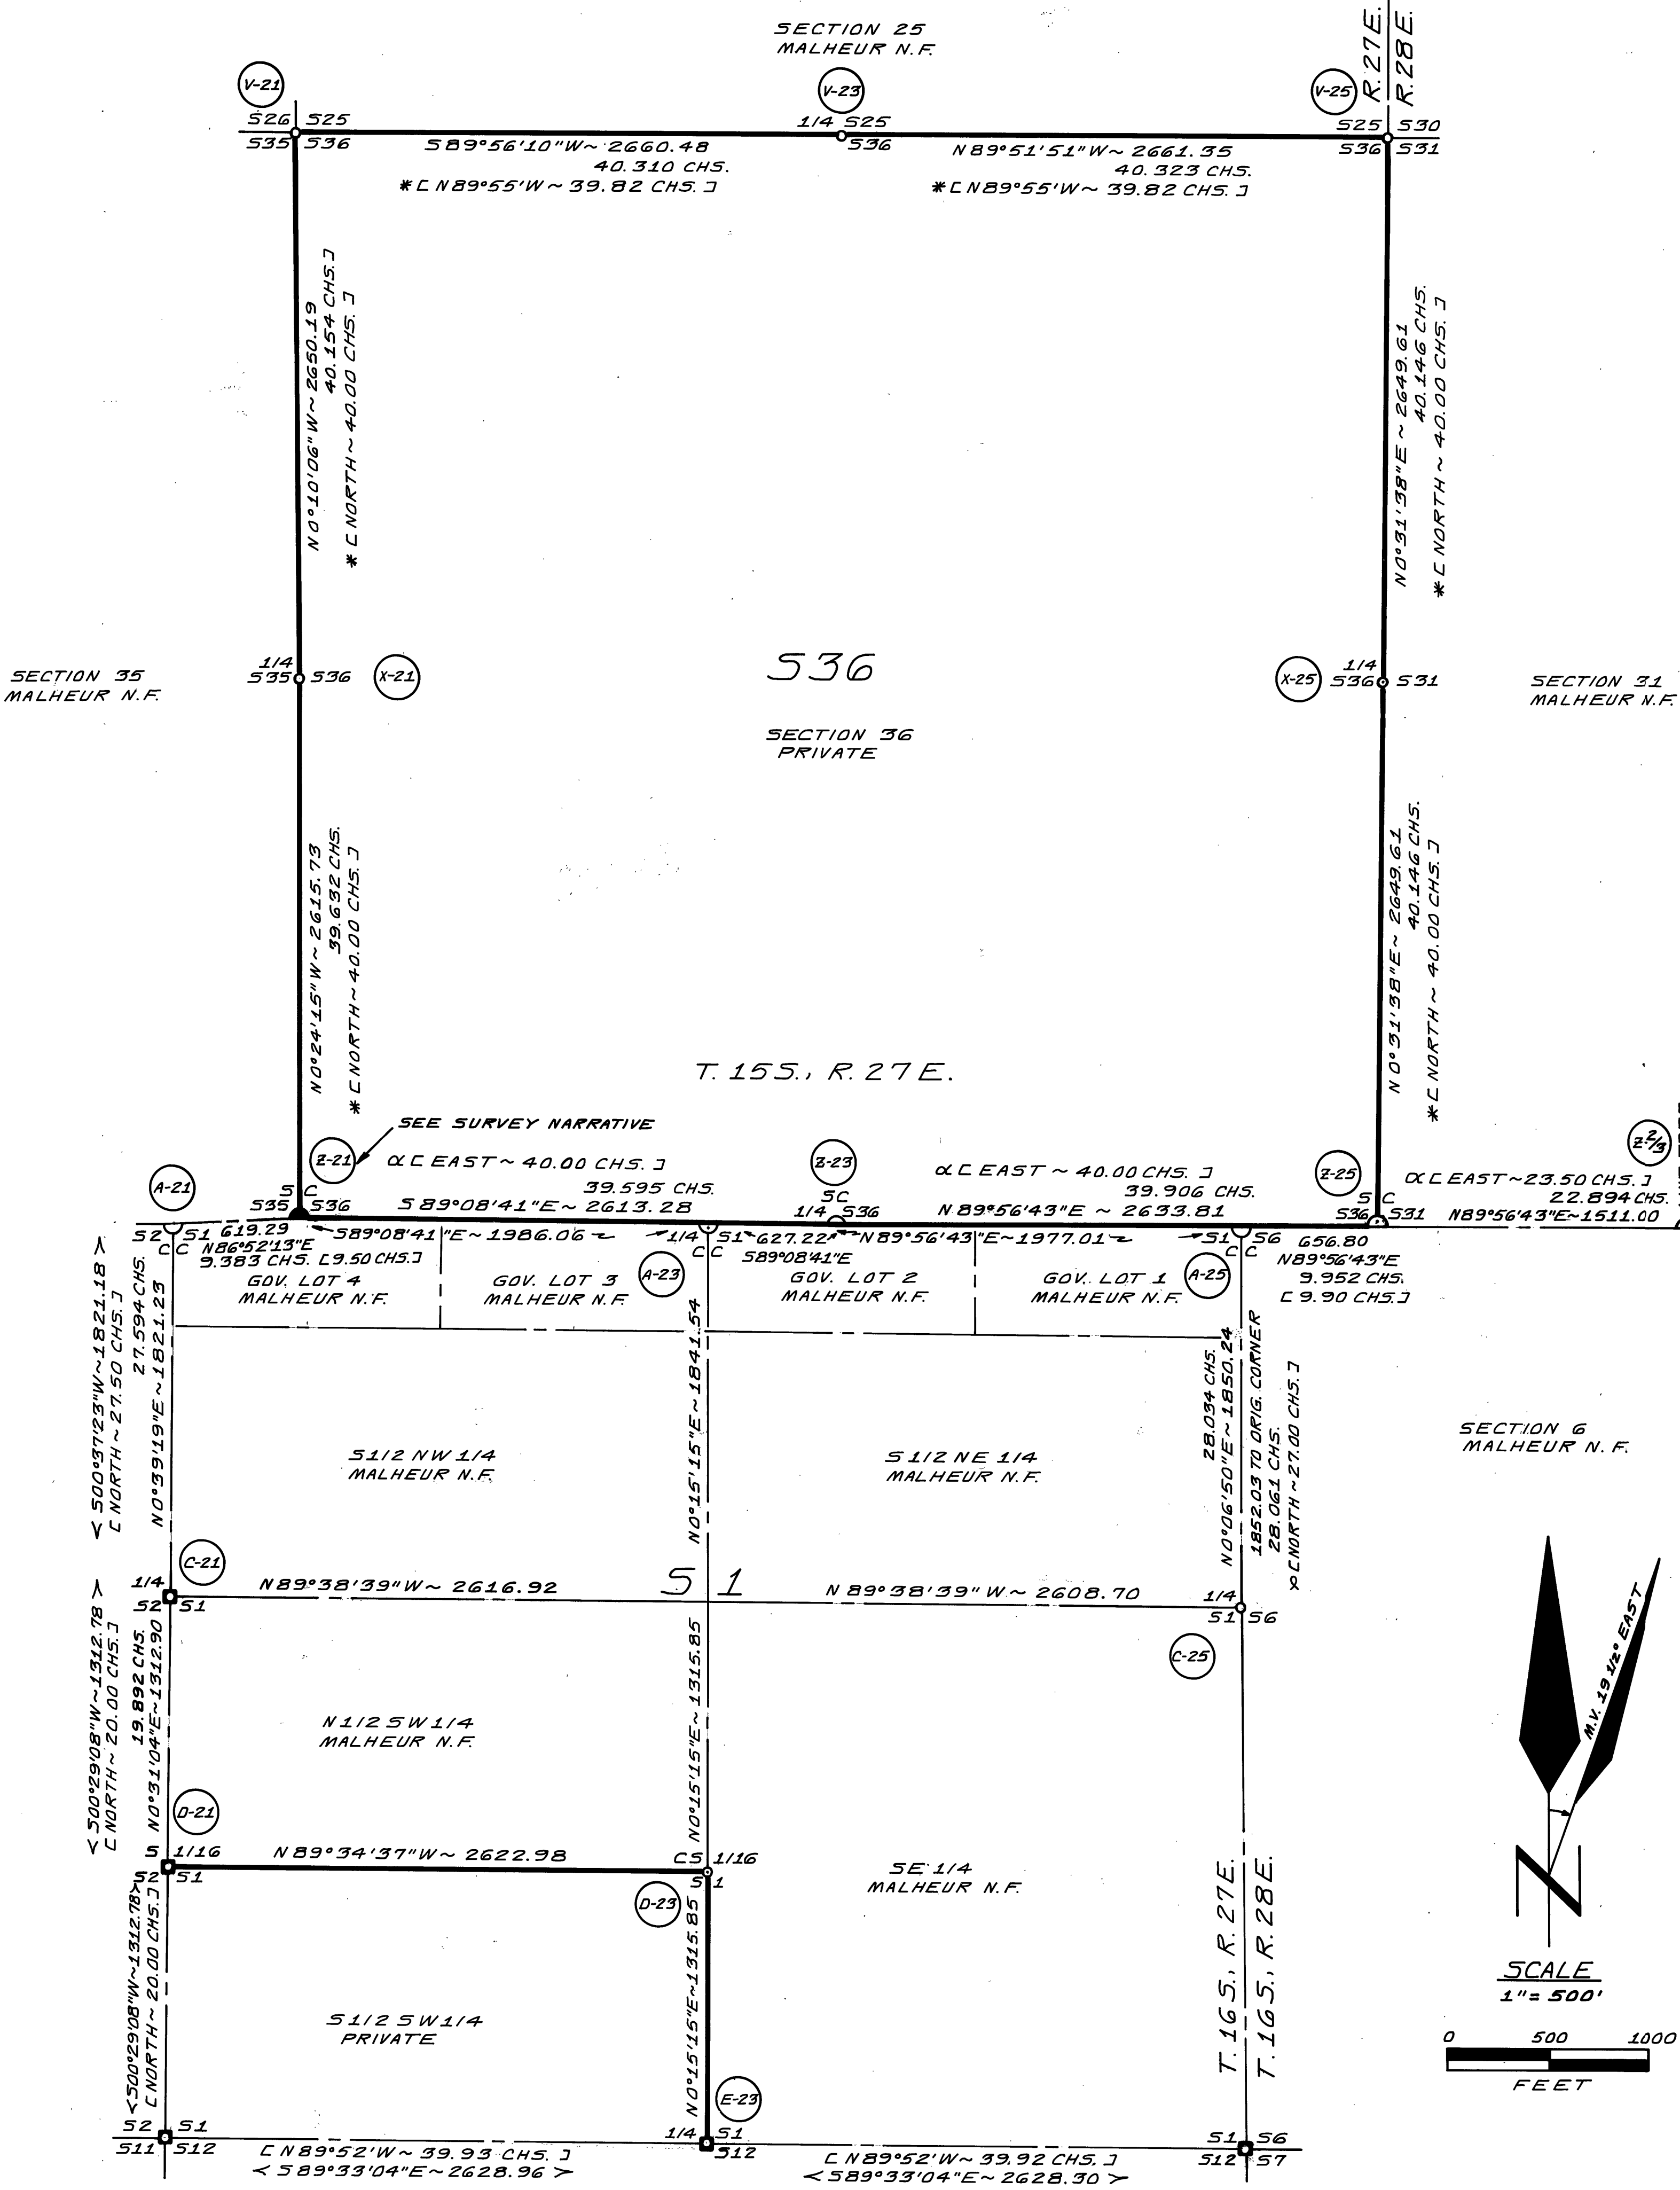

SURVEY OF MALHEUR NATIONAL FOREST BOUNDARY LINES AROUND SECTION 36, T. 15 S., R. 27 E., W. M., GRANT COUNTY, OREGON
SHAKE CADASTRAL SURVEY
CONTRACT NO. 53-04H1-6-0172N
SURVEYED - OCTOBER, 1986 - JUNE, 1987
FIELD BOOKS 1, 2, 3

SURVEY FOR
U.S.D.A., FOREST SERVICE
MALHEUR NATIONAL FOREST
139 N.E. DAYTON STREET
JOHN DAY, OREGON 97845
C503J 575-1731

GENERAL SURVEY NOTES
1. SURVEY FIELD NOTES ARE ON FILE IN THE OFFICE OF ARMSTRONG SURVEYING & ENGINEERING, INC.
2. BASIS OF BEARINGS. BEARINGS ARE BASED ON SOLAR OBSERVATION TAKEN BY ALTITUDE METHOD AT CORNER A-25, CLOSING CORNER TO SECTIONS 1 AND 6 AND CHECKED AGAINST BEARINGS OF COMMON LINES WITH C.S. 897 ALONG THE WEST LINE OF SECTION 1.
3. SURVEY INFORMATION - SEE ACCOMPANYING SHEETS OF CORNER ACCESSORY INFORMATION; ACCOMPANYING CERTIFIED RECORDS OF LAND CORNER MONUMENTATION; AND ATTACHED SURVEY NARRATIVE FOR ADDITIONAL INFORMATION ON PROCEDURES AND/OR CONDITIONS ENCOUNTERED DURING THIS SURVEY.

RECORDATION
OFFICE OF COUNTY SURVEYOR,
COUNTY OF GRANT, STATE OF
OREGON. I HEREBY CERTIFY
THE WITHIN INSTRUMENT WAS
RECORDED August 1987
COUNTY SURVEY NO. 1011
Robert D. Baggett
COUNTY SURVEYOR

SURVEY BY
ARMSTRONG SURVEYING & ENGINEERING, INC.
378 EAST SECOND STREET
PRINEVILLE, OREGON 97754
C503J 447-7791


HISTORY OF SURVEYS
1. GENERAL LAND OFFICE SURVEY OF THIRD STANDARD PARALLEL BY ALBERT O. ECHELSON, DEPUTY SURVEYOR, UNDER JOINT G.L.O. CONTRACT NO. 328 DATED JUNE 20, 1879, AND PERFORMED THAT YEAR.
2. GENERAL LAND OFFICE SURVEY OF EAST RANGE LINE, T. 16 S., R. 27 E., BY BAMFORD ROBB, DEPUTY SURVEYOR, UNDER G.L.O. CONTRACT NO. 366 DATED AUGUST 18, 1880, AND PERFORMED THAT YEAR.
3. GENERAL LAND OFFICE SURVEY OF EAST RANGE LINE AND SUBDIVISION OF T. 15 S., R. 27 E., BY SAMUEL W. LACKLAND, DEPUTY SURVEYOR, UNDER G.L.O. CONTRACT NO. 384 DATED MARCH 29, 1881, AND PERFORMED THAT YEAR.
4. GENERAL LAND OFFICE SURVEY OF SUBDIVISION OF T. 16 S., R. 27 E., BY SAMUEL W. LACKLAND, DEPUTY SURVEYOR, UNDER G.L.O. CONTRACT NO. 415 DATED AUGUST 19, 1881, AND PERFORMED THAT YEAR.
5. STANDARD CORNER COMMON TO SECTIONS 35 AND 36 REMONUMENTED BY GARY OVIATT AND WAYNE ROGERS UNDER B.L.M. GROUP NO. 882 DATED 1975.
6. SURVEY OF SOUTH AND WEST LINES OF SECTION 1 BY ROBERT D. BAGGETT, LS 598, IN C.S. 897 DATED AND RECORDED IN 1985.

HELD FOR LINE ONLY
T. 15 S., R. 28 E.
HELD FOR DISTANCE
SEE SURVEY NARRATIVE
THIRD STANDARD PARALLEL SOUTH

LEGEND
X C J G.L.O. RECORD, ECHELSON, 1879.
X C J G.L.O. RECORD, ROBB, 1880.
* C J G.L.O. RECORD, LACKLAND, CON. NO. 384, 1881.
C J G.L.O. RECORD, LACKLAND, CON. NO. 415, 1881.
< > RECORD, BAGGETT, C.S. 897, 1985.
CORNER MONUMENTED BY BAGGETT, C.S. 897, 1985.
CORNER ESTABLISHED OR RE-ESTABLISHED BY BY SURVEY DURING THIS SURVEY.
CORNER MONUMENTED BY OVIATT & ROGERS, 1975.
INDICATES MALHEUR NATIONAL FOREST BOUNDARY LINE POSTED UNDER THIS CONTRACT WITH 6 FOOT LONG STEEL OR WOOD POSTS WITH BOUNDARY SIGNS 54-2 ATTACHED.
CORNER MONUMENT NUMBER - SEE CORNER SUMMARY FOR ADDITIONAL INFORMATION.

SURVEYOR'S CERTIFICATE
I, DAVID B. ARMSTRONG, A REGISTERED PROFESSIONAL LAND SURVEYOR IN THE STATE OF OREGON, ON THE BASIS OF MY KNOWLEDGE, INFORMATION, AND BELIEF, CERTIFY THAT THIS PLAT, SURVEY NARRATIVE, AND CERTIFIED RECORDS AND/OR NOTES ARE A CORRECT REPRESENTATION OF A SURVEY PERFORMED DURING OCTOBER, 1986 - JUNE, 1987, AT THE REQUEST OF THE U.S.D.A., FOREST SERVICE, IN ACCORDANCE WITH STATUTES OF THE STATE OF OREGON AND ARTICLES OF CONTRACT NO. 53-04H1-6-0172N WITH ARMSTRONG SURVEYING & ENGINEERING, INC..

REGISTERED PROFESSIONAL LAND SURVEYOR
DAVID B. ARMSTRONG
JULY 22, 1973
1025

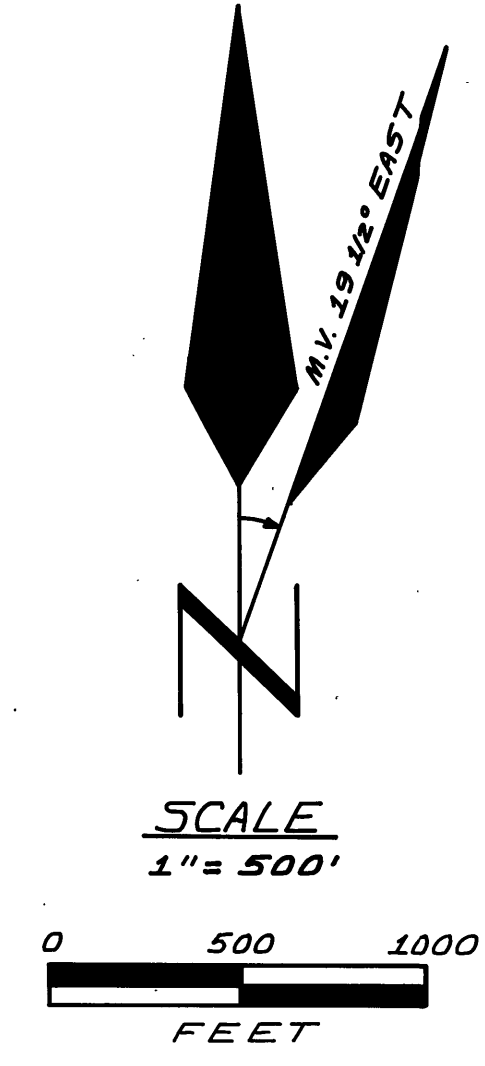

C.R.L.C.M. FORMS ~ 15
SURVEY NARRATIVE ~ 4
SHEET 1 OF 5 ~ MAP
W.O. 86-529-C