


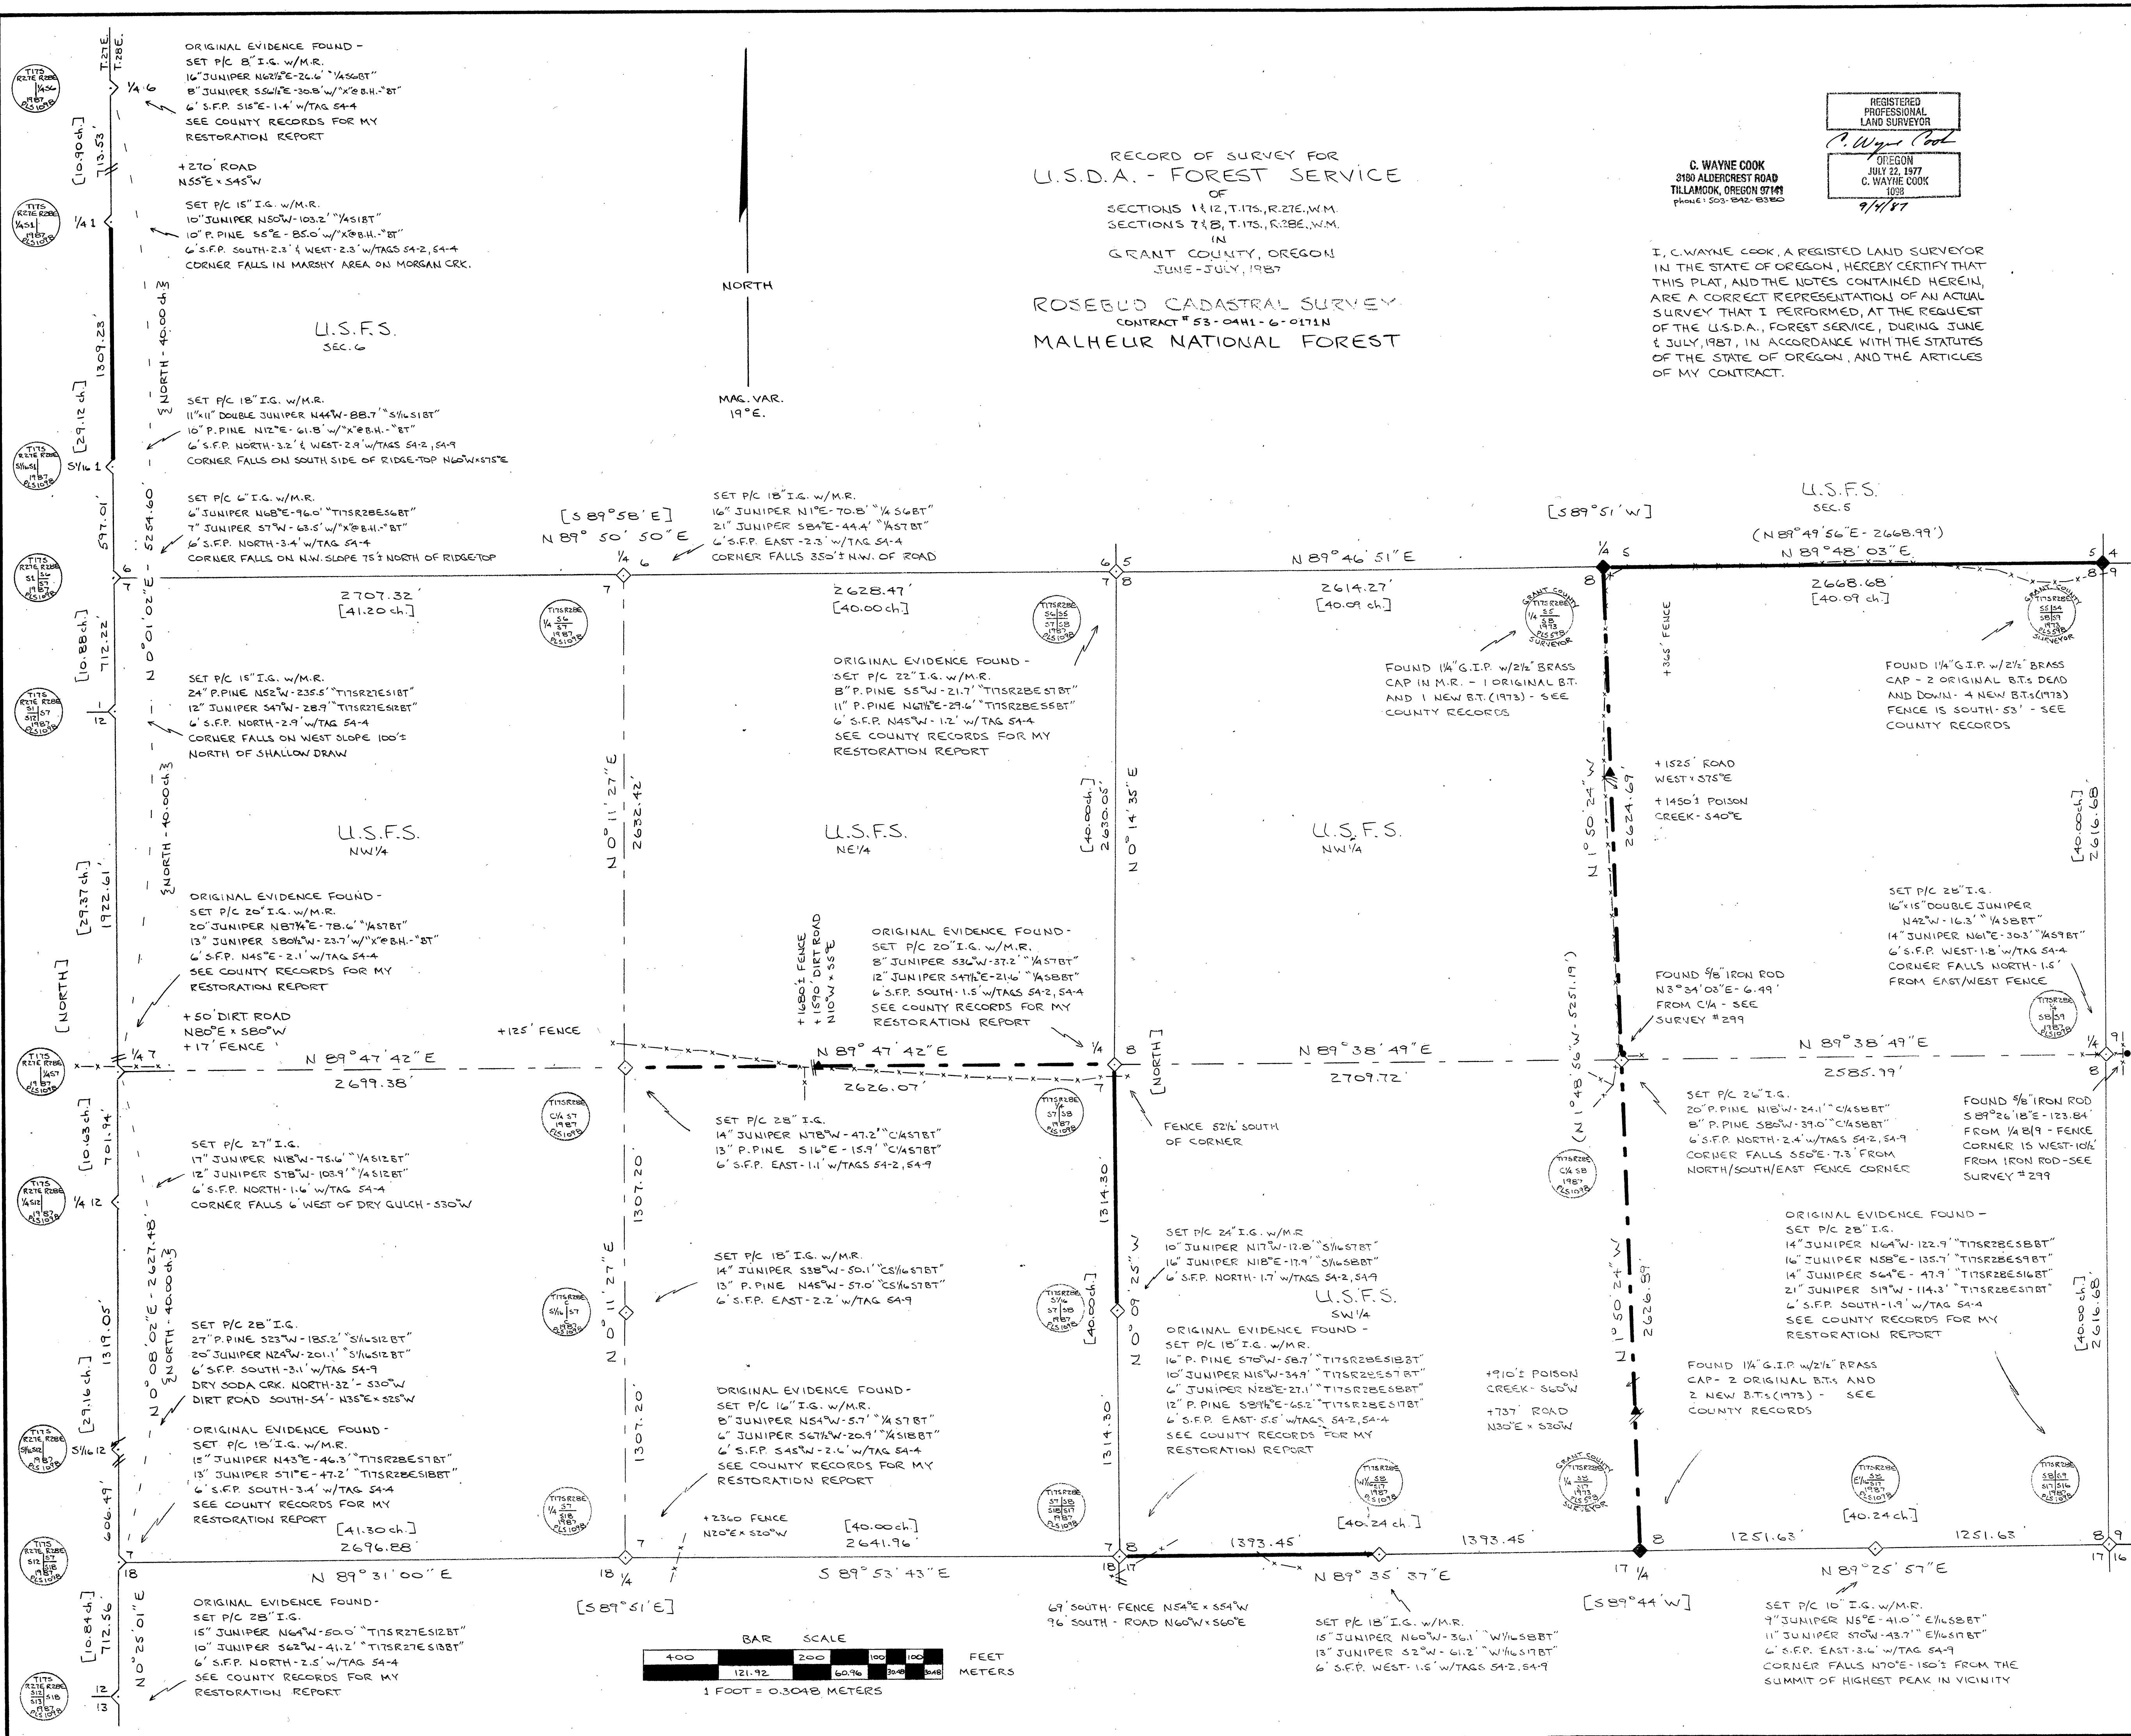

- ### LEGEND
- ◆ - MONUMENT FOUND, TYPE AND SIZE AS STATED
 - ◇ - MONUMENT SET, TYPE AND SIZE AS STATED
 - P/C - 2 1/2" x 30" ALUMINUM PIPE WITH 3" ALUMINUM CAP
 - { } - ORIGINAL G.L.O. RECORD BEARING AND DISTANCE AS SURVEYED BY BANFORD ROBB IN 1880 UNDER CONTRACT #366
 - [] - ORIGINAL G.L.O. RECORD BEARING AND DISTANCE AS SURVEYED BY HENRY W. COOKE IN 1882 UNDER CONTRACT #427
 - () - RECORD BEARING AND DISTANCE AS SURVEYED BY ROBERT BAGETT IN 1973, SEE SURVEY #299
 - - - - - HEAVY LINE DENOTES NATIONAL FOREST BOUNDARY MARKED WITH 6" STEEL FENCE POSTS AND U.S.F.S. TAGS 54-2
 - " " - DENOTES SCRIBE MARKS ON NEW BEARING TREES
 - x" @ B.H. - DENOTES "X" CHOPPED AT BREAST HEIGHT ON NEW BEARING TREES
 - x-x-x - EXISTING FENCE LINES
 - G.I.P. - GALVANIZED IRON PIPE
 - ▲ - 6" STEEL FENCE POST WITH U.S.F.S. TAG 54-5 OR 54-6 SET AT ROAD CROSSINGS ON BOUNDARY LINES
 - W/TAG - 54-2 = U.S.F.S. "PROPERTY BOUNDARY" SIGN
54-4 = U.S.F.S. "ATTENTION" SIGN
54-9 = U.S.F.S. "LAND SURVEY MONUMENT" SIGN
 - S.F.P. - STEEL FENCE POST
 - W/M.R. - WITH MOUND OF ROCK TO BASE OF CAP
 - P.PINE - PONDEROSA PINE
 - I.G. - IN GROUND
 - ch. - CHAINS

- ### HISTORY OF PRIOR SURVEY
- RANGE LINE - SURVEYED BY BANFORD ROBB IN 1880 UNDER CONTRACT #366
 - DEPENDENT RESURVEY BY HENRY W. COOKE IN 1882 UNDER CONTRACT #427
 - SUBDIVISION - HENRY W. COOKE, 1882, CONTRACT #427
 - OTHER - SURVEY IN SECTION 8 BY ROBERT BAGETT IN 1973, SEE SURVEY #299

NARRATIVE

THIS IS A DEPENDENT RETRACEMENT SURVEY OF SECTIONS 7 AND 8, T.17S., R.27E., AND PORTIONS OF THE RANGE LINE BETWEEN RANGES 27 AND 28 EAST TO MONUMENT AND DEFINE NATIONAL FOREST BOUNDARIES, AS SHOWN. NO EVIDENCE WAS FOUND OF THE E/4 1, 1/4, 1/2, 1/4, 1/4, OR 1/4 B/4. THESE CORNERS WERE RE-ESTABLISHED AT SINGLE-PROPORTIONATE MEASURE AS PER HENRY COOKE'S SURVEY IN 1882. CORNERS RE-ESTABLISHED ON THE RANGE LINE WERE SET ON LINE BETWEEN THE SENIOR CORNERS AS SET BY BANFORD ROBB IN 1880. THE CORNER 1/4 B/4 IS A JUNIOR CORNER AND THE AMENDED POSITION WAS NOT MONUMENTED. THE PINE LINE TREE 32.21 CHAINS NORTH OF 1/4 B/4 WAS FOUND UP-ROOTED AND THE ORIGINAL POSITION IS INDEFINITE, THEREFORE IT WAS DISREGARDED IN THE RE-ESTABLISHMENT OF 1/4 B/4. ALL MONUMENTS AND ACCESSORIES ARE MARKED IN ACCORDANCE WITH THE "MANUAL OF INSTRUCTIONS FOR THE SURVEY OF THE PUBLIC LANDS OF THE UNITED STATES." ALL NEW BEARING TREES HAVE U.S.F.S. TAGS 54-3, PLUS U.S.F.S. TAGS 54-4 OR 54-9, AND A 6" RED PAINT BAND. BEARING TREE DISTANCES WERE MEASURED TO A 60D NAIL DRIVEN INTO THE BASE OF THE TREE AT SIDE-CENTER, AFFIXED WITH A 1/4" ALUMINUM WASHER MARKED "C. WAYNE COOK-PLS 10198". BASIS OF MERIDIAN SOLAR-ORIENTED TO OBSERVATION TAKEN AT 1/4 3/4, T.16S., R.27E.

METHOD OF SURVEY: CLOSED AND BALANCED RANDOM TRAVERSE, SOLAR-ORIENTED

EQUIPMENT: ZEISS TH-43 THEODOLITE, CITATION E.D.M., HEWLETT-PACKARD 3800A E.D.M., LUPKIN 300TAP

FIELD CREW: C. WAYNE COOK, LAUREN R. EDGAR, STEVE J. EVERITT, A.D. COOK, C.G. COOK

RECEIVED AND
FILED
OCT 12 1987

OFFICE OF COUNTY SURVEYOR
JULY 22 1977
C. WAYNE COOK
1099

L.R.E. 8/87