

IN  
SECTIONS 2,3,4,T.17S.,R.28E.,W.M.:  
GRANT COUNTY OREGON  
JULY 1987  
ROSEBUD CADASTRAL SURVEY  
CONTRACT #53-04H1-6-0171N  
MALHEUR NATIONAL FOREST

FOUND 1 1/4" G.I.P. WITH 2 1/2"  
BRASS CAP - 1 NEW B.T. -  
(1973) - CORNER FALLS 2 1/2'  
SOUTH OF FENCE

ORIGINAL EVIDENCE FOUND-  
SET P/C 18" I.G. w/M.R.  
9" JUNIPER S66.4"E-26.7" "T17SR28E510BT"  
8" JUNIPER S52.4"W-65.8" "T17SR28E59BT"  
13" P. PINE N50.6"W-23.2" "T17SR28E54BT"  
16" P. PINE N38"E-4.1" "T17SR28E53BT"  
6" S.F.P. WEST-2.7' & EAST-2.5' w/TAGS  
54-2, 54-4 - FENCE IS 100'E SOUTH - SEE  
COUNTY RECORDS FOR MY RESTOR-  
ATION REPORT

ORIGINAL EVIDENCE FOUND-  
SET PIC 26" I.G. w/M.R.  
9" JUNIPER N 65° E - 114.6' "1/4 SSBT"  
18' P. PINE S 43° W - 38.5' "1/4 SSBT"  
6' S.F.P. WEST - 3' ± EAST - 3' ±  
W/TAGS 54-2, 54-4 - CORNER IS  
1' NORTH OF FENCE - SEE COUNTY  
RECORDS FOR MY RESTORATION  
REPORT

ORIGINAL EVIDENCE FOUND -  
SET P/C 24" I.G. w/M.R.  
11" JUNIPER S57.4°W - 57.9" "T17SR2BE53BT"  
10" JUNIPER N21°W - 11.0" "T16SR2BE534BT"  
10" JUNIPER N13.2°E - 21.5" "T16SR2BE535BT"  
12" JUNIPER S54°E - 12.1" "T17SR2BE53BT"  
6" S.F.P. SOUTH - 1.5" w/TAG 54.4  
SEE COUNTY RECORDS FOR MY  
RESTORATION REPORT

SEARCHED FOR -  
NOT FOUND

FOUND P/C IN M.R. - 2 NEW  
B.T.s (19Bi) - 6' S.F.P. EAST-2.0'  
w/TAGS 54-2, 54-4 - CORNER IS  
STS°E - 6.0' FROM S.E. FENCE  
CORNER - SEE SURVEY #708

U.S.F.S. - (  $\frac{32}{511}$  PLS 1287 ) - SECTION 2

NORTH

MAG. VAR  
19° E.

SET P/C 17" I.G. w/M.R.  
18" JUNIPER S16"E - 12.5' "T17SRZBE511BT"  
13" JUNIPER N88"E - 26.6' "T17SRZBE 52BT"  
18" JUNIPER N81"W - 16.75' "T17SRZBE 53BT"  
11" JUNIPER S21"W - 49.6' "T17SRZBE510BT"  
6' S.F.P. EAST-2.1' w/TAGS 54-2, 54-4  
CORNER FALLS 60' SOUTH OF FENCE

I, C. WAYNE COOK, A REGISTERED LAND SURVEYOR IN THE STATE OF OREGON, HEREBY CERTIFY THAT THIS PLAT, AND THE NOTES CONTAINED HEREIN, ARE A CORRECT REPRESENTATION OF AN ACTUAL SURVEY THAT I PERFORMED, AT THE REQUEST OF THE U.S.D.A. - FOREST SERVICE, DURING JULY, 1987, IN ACCORDANCE WITH THE STATUTES OF THE STATE OF OREGON, AND THE ARTICLES OF MY CONTRACT.

**C. WAYNE COOK**  
3180 ALDERCREST ROAD  
TILLAMOOK, OREGON 97141  
phone: 503-842-8380

**REGISTERED  
PROFESSIONAL  
LAND SURVEYOR**

OREGON  
JULY 22, 1977  
C. WAYNE COOK  
1098

9/4/87

RECEIVED AND  
FILED

OCT 12 1987

OFFICE OF COUNTY SURVEYOR  
Attest: Michael W. Berry

L.R.F 8/87

MAP OF SURVEY NO. 1015 sheet 3 of 3

### LEGEND

## HISTORY OF PRIOR SURVEY

TOWNSHIP LINE - SURVEYED BY BANFORD ROBB IN 1880 UNDER  
CONTRACT #366

SUBDIVISION - SURVEYED BY HENRY W. COOKE IN 1882 UNDER  
CONTRACT #427

OTHER - SURVEY IN SECTION 9 BY ROBERT BAGETT IN  
1973, SEE SURVEY #299

## NARRATIVE

THIS IS A DEPENDENT RETRACEMENT SURVEY OF PORTIONS OF THE SOUTH LINE OF SECTION 2, SECTIONS 3 AND 4, T.17S. R.28E. TO MONUMENT AND DEFINE NATIONAL FOREST BOUNDARIES, AS SHOWN. NO EVIDENCE WAS FOUND OF THE SECTION CORNER  $\frac{3}{4}$ . THIS CORNER WAS RE-ESTABLISHED AT DOUBLE-PROPORTIONATE MEASURE BETWEEN THE NEAREST FOUND CORNERS NORTH, SOUTH, EAST, AND WEST, AS PER THE ORIGINAL G.L.O. SURVEY BY HENRY W. COOKE IN 1882, AS SHOWN. ALL NEW MONUMENTS AND ACCESSORIES ARE MARKED IN ACCORDANCE WITH THE "MANUAL OF INSTRUCTIONS FOR THE SURVEY OF THE PUBLIC LANDS OF THE UNITED STATES." ALL NEW BEARING TREES HAVE U.S.F.S. TAGS 54-3, 54-4, AND A 6" RED PAINT BAND. BEARING TREE DISTANCES WERE MEASURED TO A 60D NAIL DRIVEN INTO THE BASE OF THE TREE AT SIDE-CENTER AFFIXED WITH A 1 1/2" ALUMINUM DISK MARKED "C. WAYNE COOK - PL3109B" BASIS OF MERIDIAN SOLAR-ORIENTED TO OBSERVATION TAKEN AT  $\frac{1}{4}$   $\frac{25}{26}$ , T.16S., R.27E.

METHOD OF SURVEY: CLOSED AND BALANCED RANDOM TRAVERSE, SOLAR-ORIENTED

EQUIPMENT: ZEISS TH-43 THEODOLITE, CITATION CI-450 E.D.M.  
HEWLETT-PACKARD 3800A E.D.M., LUFKIN 300' TAPE.

FIELD CREW: C. WAYNE COOK, LAUREN R. EDGAR, A.D. COOK,  
S.J. EVERETT, C.G. COOK

- SEARCHED FOR-  
NOT FOUND


SEARCHED FOR  
NOT FOUND

ORIGINAL EVIDENCE FOUND-  
SET P/C 17" I.G. w/M.R.  
NO B.T.'s AVAILABLE  
6'S.F.P. SOUTH-2.6" w/TAGS 54-4, 54-5  
6'S.F.P. WEST-2.9" w/TAGS 54-4, 54-5  
SEE COUNTY RECORDS FOR MY  
RESTORATION REPORT

77SR2BE  
YA  
SIS | SIA  
1987  
PLS 1098

- ◆ - MONUMENT FOUND, TYPE AND SIZE AS STATED
- ◊ - MONUMENT SET, TYPE AND SIZE AS STATED
- [ ] - ORIGINAL RECORD G.L.O. BEARING AND DISTANCE AS SURVEYED BY HENRY W. COOKE IN 1882, UNDER CONTRACT #427
- { } - RECORD BEARING AND DISTANCE AS SURVEYED BY ROBERT BAGETT IN 1973, SEE SURVEY #299
- P/C - 2 1/2" x 30" ALUMINUM PIPE WITH 3" ALUMINUM CAP
- - HEAVY LINE DENOTES NATIONAL FOREST BOUNDARY MARKED WITH 6' STEEL FENCE POSTS AND U.S.F.S. TAGS 54-2
- " " - DENOTES SCRIBE MARKS ON NEW BEARING TREES
- x-x- - EXISTING FENCE LINES
- G.I.P. - GALVANIZED IRON PIPE
- ▲ - 6' STEEL FENCE POST WITH U.S.F.S. TAG 54-5 SET AT ROAD CROSSINGS ON BOUNDARY LINES
- W/TAG - 54-2 = U.S.F.S. "PROPERTY BOUNDARY" SIGN  
54-4 = U.S.F.S. "ATTENTION" SIGN  
54-5 = U.S.F.S. "LOCATION POSTER" SIGN
- S.F.P. - STEEL FENCE POST
- w/MR. - WITH MOUND OF ROCK TO BASE OF CAP
- P.PINE - PONDEROSA PINE
- I.G. - IN GROUND
- ch. - CHAINS

BAR SCALE

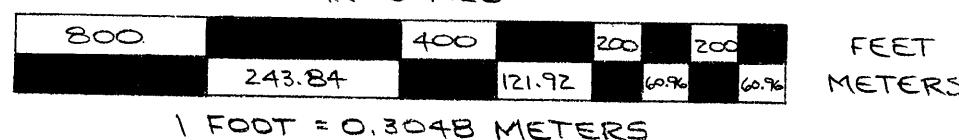

1 FOOT = 0.3048 METERS