

National Forest Lands

Township 8 South, Range 35 East

Section 24

The North half

The North half of the Southeast quarter

The West half of the Southwest quarter

Section 25

The East half of the Northeast quarter

The East half of the Southeast quarter

The Southwest quarter of the Southeast quarter

The Northwest quarter of the Southwest quarter

Section 26

The East half

Section 36

The North half of the North half

Township 8 South, Range 35 1/2 East

Section 21

The West half

History of Surveys

The Range line between Township 8 South, Ranges 35 and 35 1/2 East, was originally established by Eugene P. McCornack under GLO contract number 398, dated July 2, 1881.

The Range line between Township 8 South, Ranges 35 and 35 1/2 East was retraced and Township 8 South, Range 35 East was subdivided by Herman D. Gradon under GLO contract number 499, dated March 11, 1884.

In Township 8 South, Range 35 East, the Northwest corner and the North and South quarter corners of Section 24 and the Southwest corner, the Northeast corner and the South quarter corner of Section 25, and in Township 8 South, Range 35 1/2 East, the West quarter corners of Sections 21 and 28 were monumented from original GLO corner evidence by William L. Hanley, OPLS 1639, in September, 1979.

The South quarter corner of Section 23, Township 8 South, Range 35 East was monumented from original GLO corner evidence by Gary L. Langlitz, OPLS 1099, in November, 1982.

BASIS OF BEARING

Solar observation taken at a point 150.24 feet South and 127.99 feet East of the Southwest corner of Section 25 Township 8 South, Range 35 East of the Willamette Meridian. (Hour angle method)

Date July 25, 1987

Latitude 44°50'09"

Longitude 118°27'14"

Time 16:52:31 (GCT)

Magnetic declination 17° East

LEGEND

- Found brass cap monument set by William L. Hanley, OPLS 1639
- Found brass cap monument set by Gary L. Langlitz, OPLS 1099
- Found original GLO evidence and set a 2 1/2" x 30" aluminum monument
- ⊙ Set 2 1/2" x 30" aluminum monument at position determined by survey
- () Record bearing and distance of GLO survey by Herman D. Gradon
- { } Record bearing and distance of GLO survey by Eugene P. McCornack
- National Forest boundary posted to standard
- United States government property administered by the Umatilla National Forest
- P Privately owned land

NOTE:
For monumentation information, see monumentation sheets filed separately.

SURVEYOR'S STATEMENT

I, Duane I. Griffith, Registered Land Surveyor in the State of Oregon, hereby certify that this plat and the notes hereon, or attached, are a true and correct representation of the survey I made in July and August, 1987, at the request of the USDA, Forest Service, in accordance with the statutes of the State of Oregon, and with the articles of my contract.

This survey was performed using Zeiss Th-2 one second theodolites. The distances were measured with Mac IE and Mac ITH (infra-red) units. The purpose of this survey was to locate and establish the National Forest boundary as shown.

Many controlling corners on this survey were previously monumented by William L. Hanley. I find one of his monuments at the Northeast corner of Section 25, Township 8 South, Range 35 East, which he set at the original corner stone position. The range line between Ranges 35 and 35 1/2 East was originally established by Eugene P. McCornack. Corners monumented under GLO contract of Herman D. Gradon, pertaining to Range 35 East are junior to the McCornack range line corners, and with the articles of my contract. I set a new monument N 89°40'25" W, along the North line of Section 25, 27.09 feet, at the true closing corner position, as the corners pertaining to Range 35 East are junior to the R 35 1/2 East corners. I also find the original Gradon corner at the Northeast corner of Section 24, Range 35 East. I set the corner monument N 88°38'09" W, along the North line of Section 24, 4.71 feet, at the true closing corner position. I find two unrecorded bearing trees along the range line as follows:

At the Southwest corner of Section 28, Township 8 South, Range 35 1/2 East, I find the record bearing trees East and also an unrecorded bearing tree to the West. At the Northwest corner of Section 21, Township 8 South, Range 35 1/2 East, I find the rotted remains of a White Fir with a slab of wood blazed and scribed R35E S24. I find no record of this tree and therefore am forced to set this corner at proportionate distance.

At the Northwest corner of Section 25, Township 8 South, Range 35 East, I find a stump hole and a stump that match the record GLO calls. By locating the corner from this stump and stump hole, the corner position is within 2 feet East-West and 3 feet North-South of the proportionate position. It is also harmonious with the creek call to the East. I therefore place this corner at record bearing and distance from the stump hole and stump.

I find no other unusual conditions on this survey.


Duane I. Griffith
Duane I. Griffith, OPLS 644
Baggett, Griffith and Associates
2006 Adams Avenue
La Grande, Oregon 97850

September 15, 1987

Magnolia Cadastral Survey
Contract number 53-04R3-7-5
See also field books Phase II Magnolia I through VI
and monumentation books Phase II Magnolia I and II

BAGETT - GRIFFITH & ASSOCIATES La Grande, Oregon		
Map of Survey National Forest boundary within Sections 24 and 25, Township 8 South, Range 35 East of the Willamette Meridian GRANT COUNTY, OREGON		
SURVEYED FOR	Umatilla National Forest	
SURVEYED BY	d.l.g.	788-87
Scale: 1" = 600'	Drawn by: R.G.R.	9-87

Scale 1" = 600'

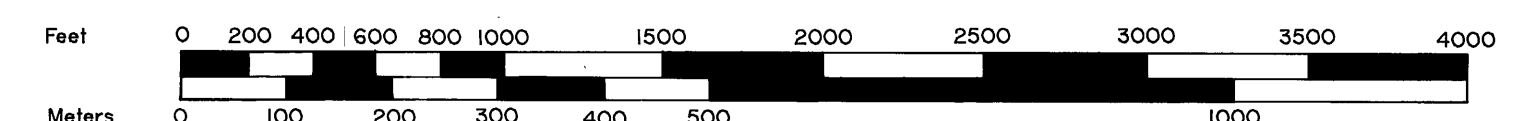

1 Meter = 3.28083333 Feet

RECEIVED AND
FILED

OCT 22 1987

OFFICE OF COUNTY SURVEYOR
Duane I. Griffith

