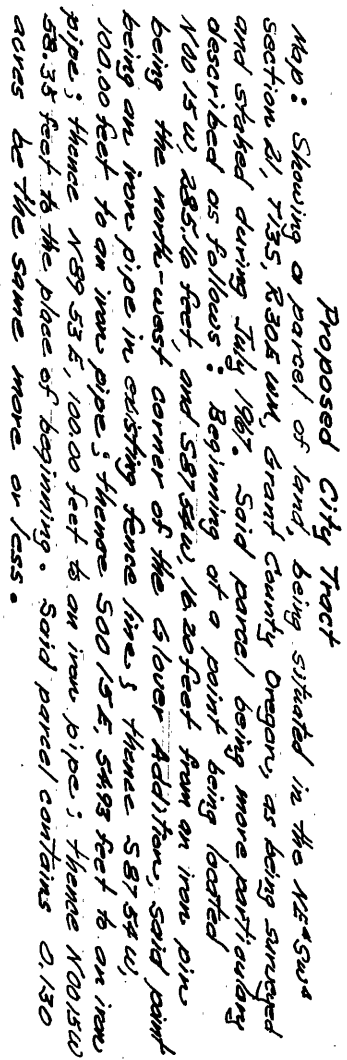





[illegible]

Map: Showing a parcel of land, being situated in the S4SW1/4 of section 21, T13S, R30E, W4M, Grant County, Oregon, as surveyed and staked during July, 1967. Said parcel, being more particularly described as follows: Beginning of an new pine being located S89°48'W, 335.26 feet, and N20°15'W, 531.78 feet from the SE corner S89°48'W, T13S, R30E, W4M, to the corner S89°51'W, 132.00 feet to an new pine; thence, S02°15'E, 42.00 feet to an new pine; thence, N89°51'E, 134.00 feet to an new pine; thence, N03°58'W, 40.10 feet to the place of beginning. Said parcel contains 0.122 acres to the place of beginning. Said parcel contains 0.122 acres to the same more or less.

REGISTERED
OREGON
LAND SURVEYOR

James H. Hambleton
9-20-67

JULY 10, 1964

JAMES H. HAMBLETON
645

JOHN DAY HIGHWAY
Set Pile spike
R/L
580 ASW
519.06
0
1/4 den. 25
7135 R 30.5 W.N.