

RECEIVED AND

REGISTERED PROFESSIONAL LAND SURVEYOR


OREGON
JULY 12, 1863
ROBERT D. BAGETT
598

NARRATIVE:

This survey was performed at the request of Jim Weaver and Bill Davis, acting in behalf of Oradell Weaver. The purpose of this survey was to create the three tracts as shown hereon.

A search was made of the available records pertaining to this survey. Field measurements were made to locate existing monuments. New monuments were set in accordance with the evidence found as shown hereon.

I found no unusual conditions with this survey.

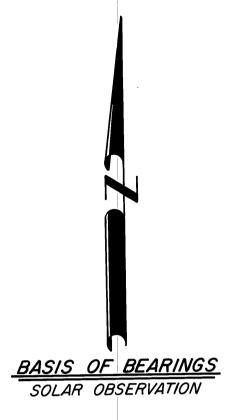

LEGEND

- Found 1/8" iron pin of record
- Set %"x30" iron pin with attached yellow plastic cap marked BGA SURVEY MARKER.

REFERENCES

Plat of Charolias Heights Addition Deed Records book IIO Page 947

Record Map of Survey No. 166 190 495



BAGETT - GRIFFITH & ASSOCIATES

John Day, Oregon

Map of Survey LAND PARTITION SITUATED IN THE SEYNWY SECTION 23, TI3S, R3IE, W.M. CITY OF JOHN DAY

GRANT COUNTY, OREGON Oradell Weaver SURVEYED FOR 3/23/88 R.D.B. & J.L.W. SURVEYED BY 3/25/88 Drawn by: J.L.W. Scale: /"= 50'