
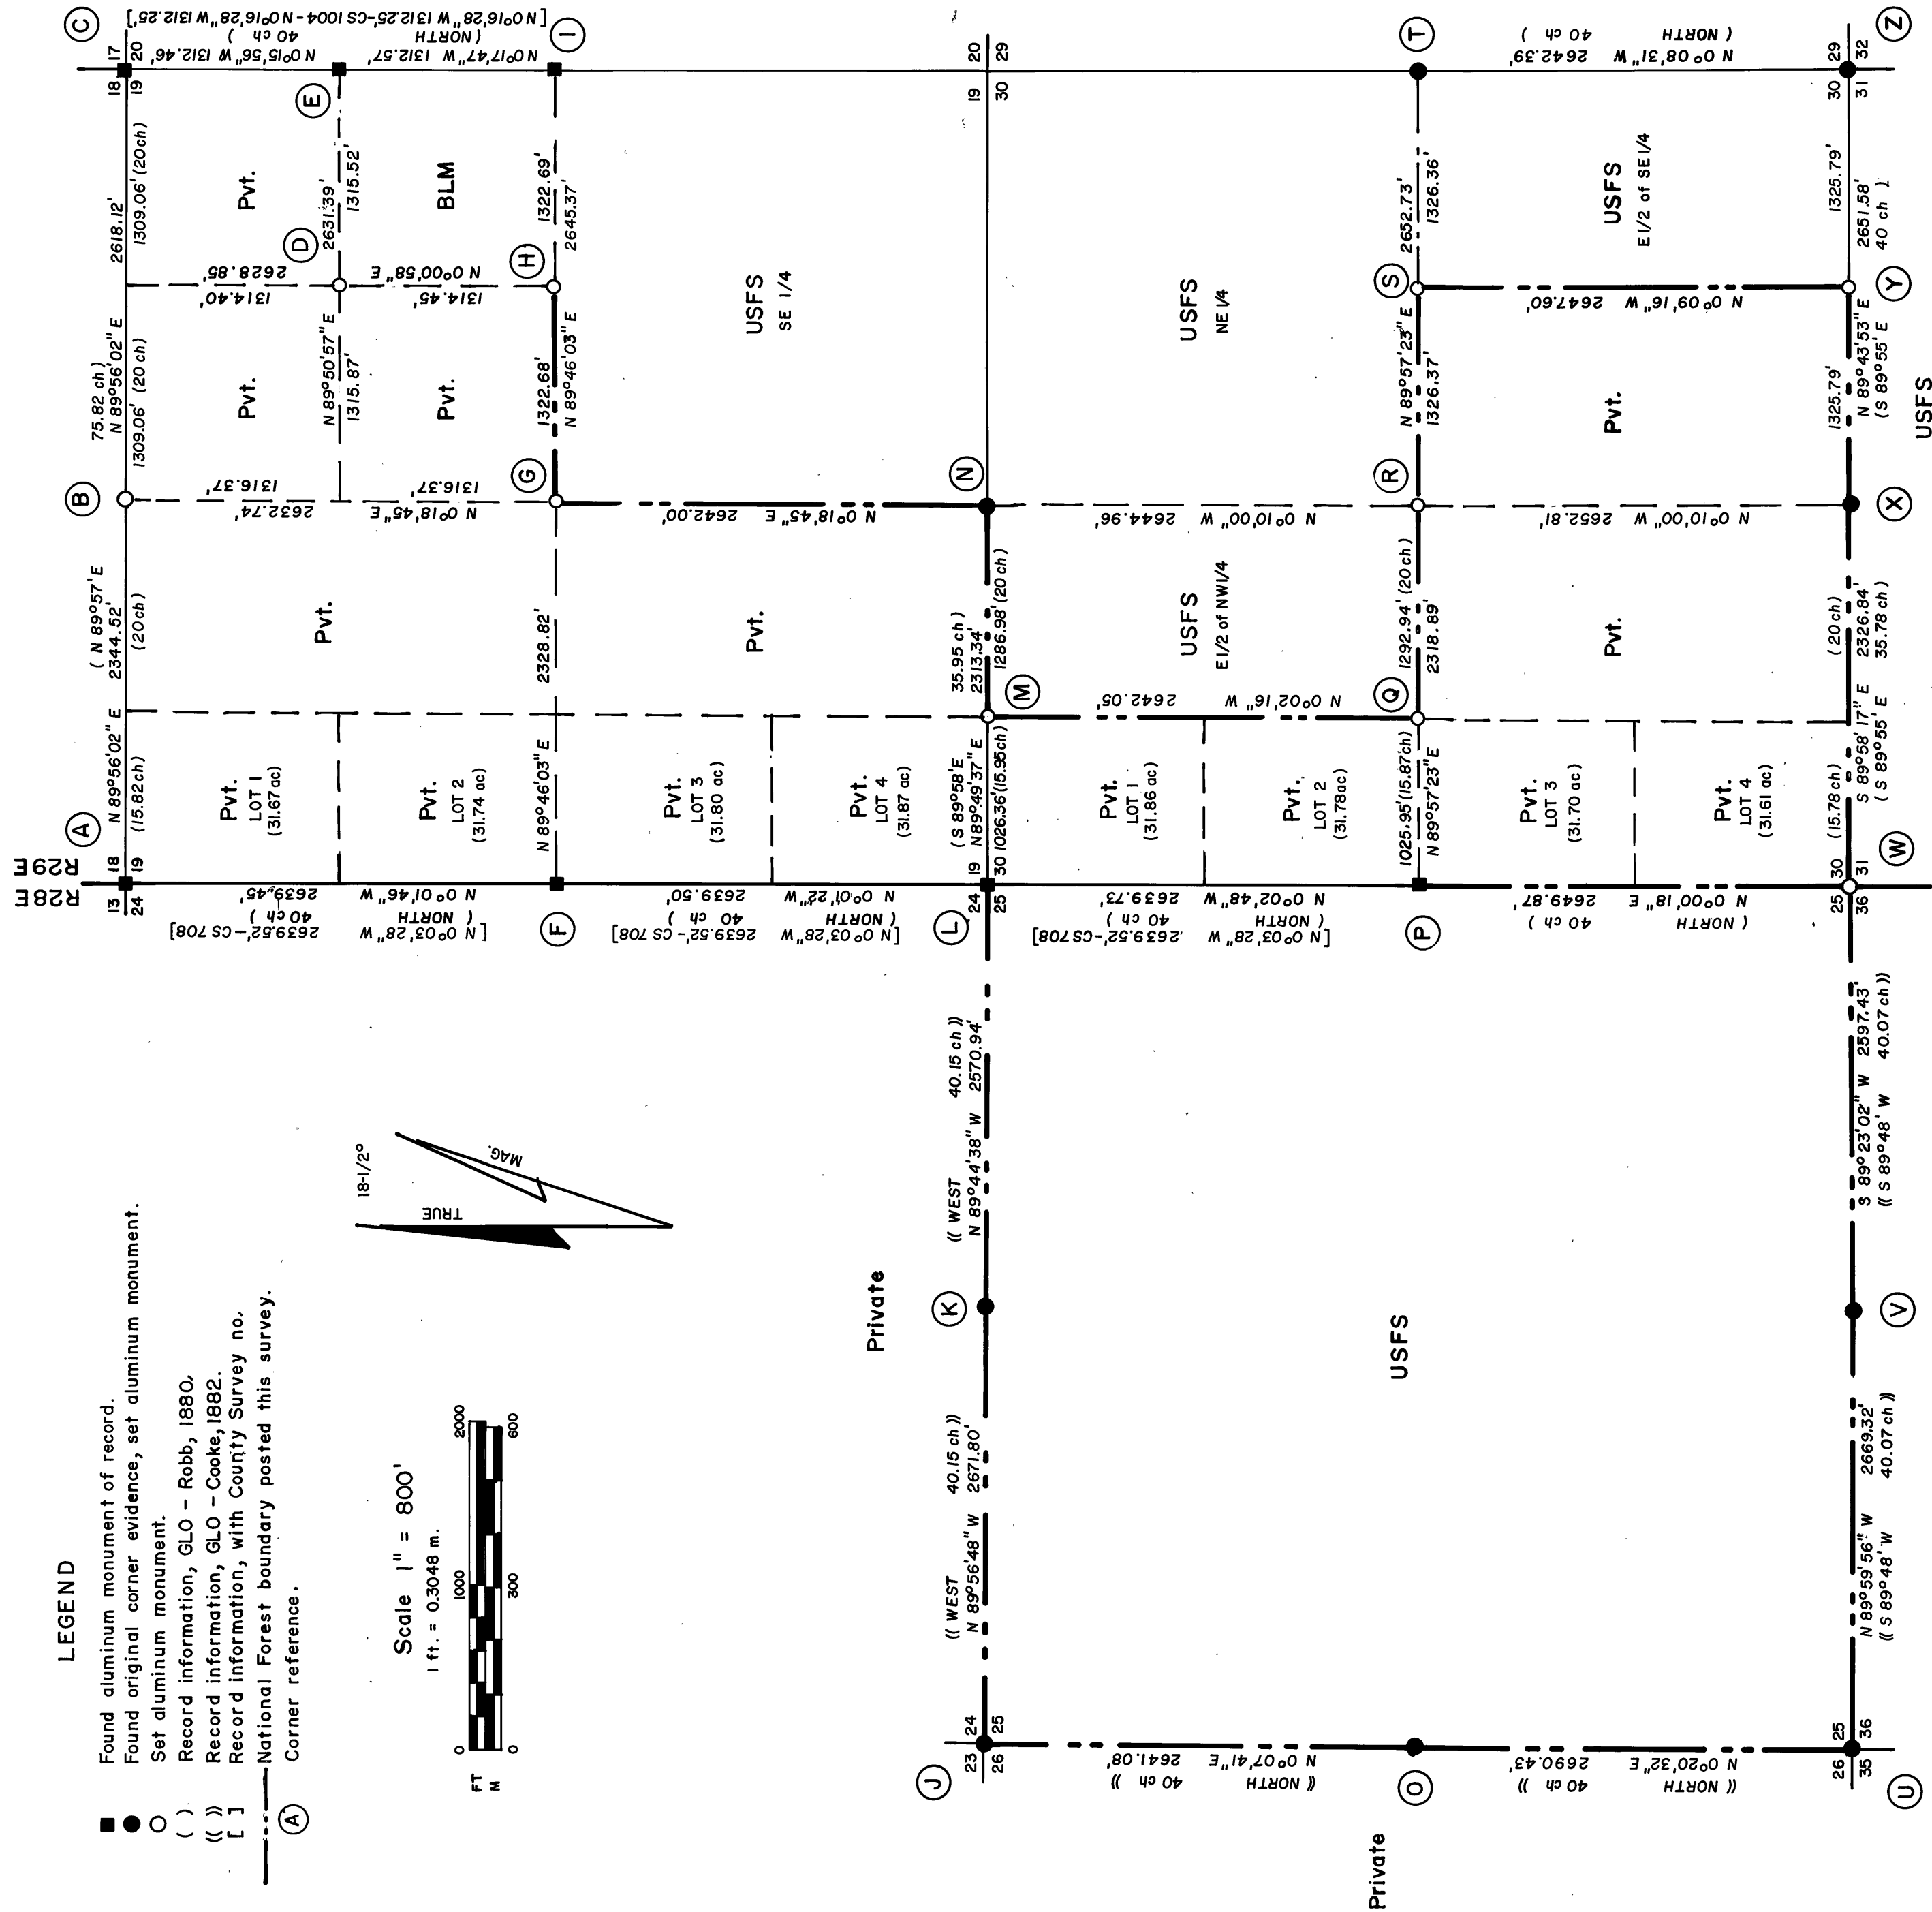
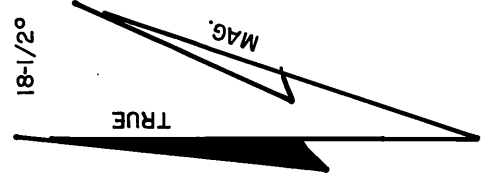


LEGEND

- Found aluminum monument of record.
- Found original corner evidence, set aluminum monument.
- Set aluminum monument.
- Record information, GLO - Robb, 1880.
- Record information, GLO - Cooke, 1882.
- Record information, with County Survey no.
- National Forest boundary posted this survey.
- Corner reference.

Scale 1" = 800'

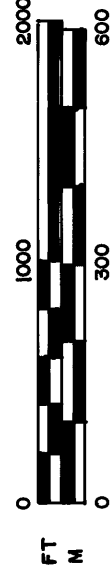

REGISTERED
PROFESSIONAL
LAND SURVEYOR
Tyler B. Parsons
OREGON
JULY 18, 1980
TYLER B. PARSONS
1918

EXAMINED AND ACCEPTED FOR THE US FOREST SERVICE
THIS 9th DAY OF September, 1988.
DE Calver, COR.
I CERTIFY THAT THIS SURVEY WAS PERFORMED AT THE REQUEST
OF THE MALHEUR NATIONAL FOREST SUPERVISOR.
M. L. Gordon DATE 9/17/88

RECORD OF SURVEY for the U.S. FOREST SERVICE

MALHEUR NATIONAL FOREST
Sec 25 & 36, T17S, R28E, W.M.
Sec 19 & 30, T17S, R29E, W.M.

Grant County, Oregon

July 18, 1988

PARSONS SURVEYING
1915 SE Stone St.
Corvallis, OR 97333
(503) 752-7515

Job No. 8722G

RECEIVED AND
FILED

NOV 4 1988

OFFICE OF COUNTY SURVEYOR
Robert J. ...

