


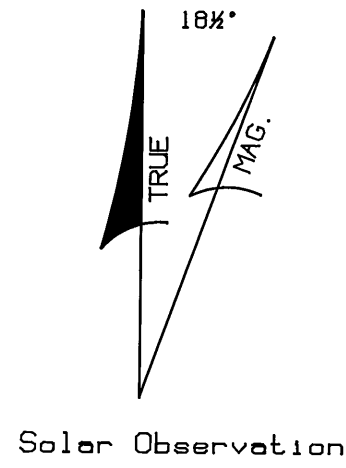


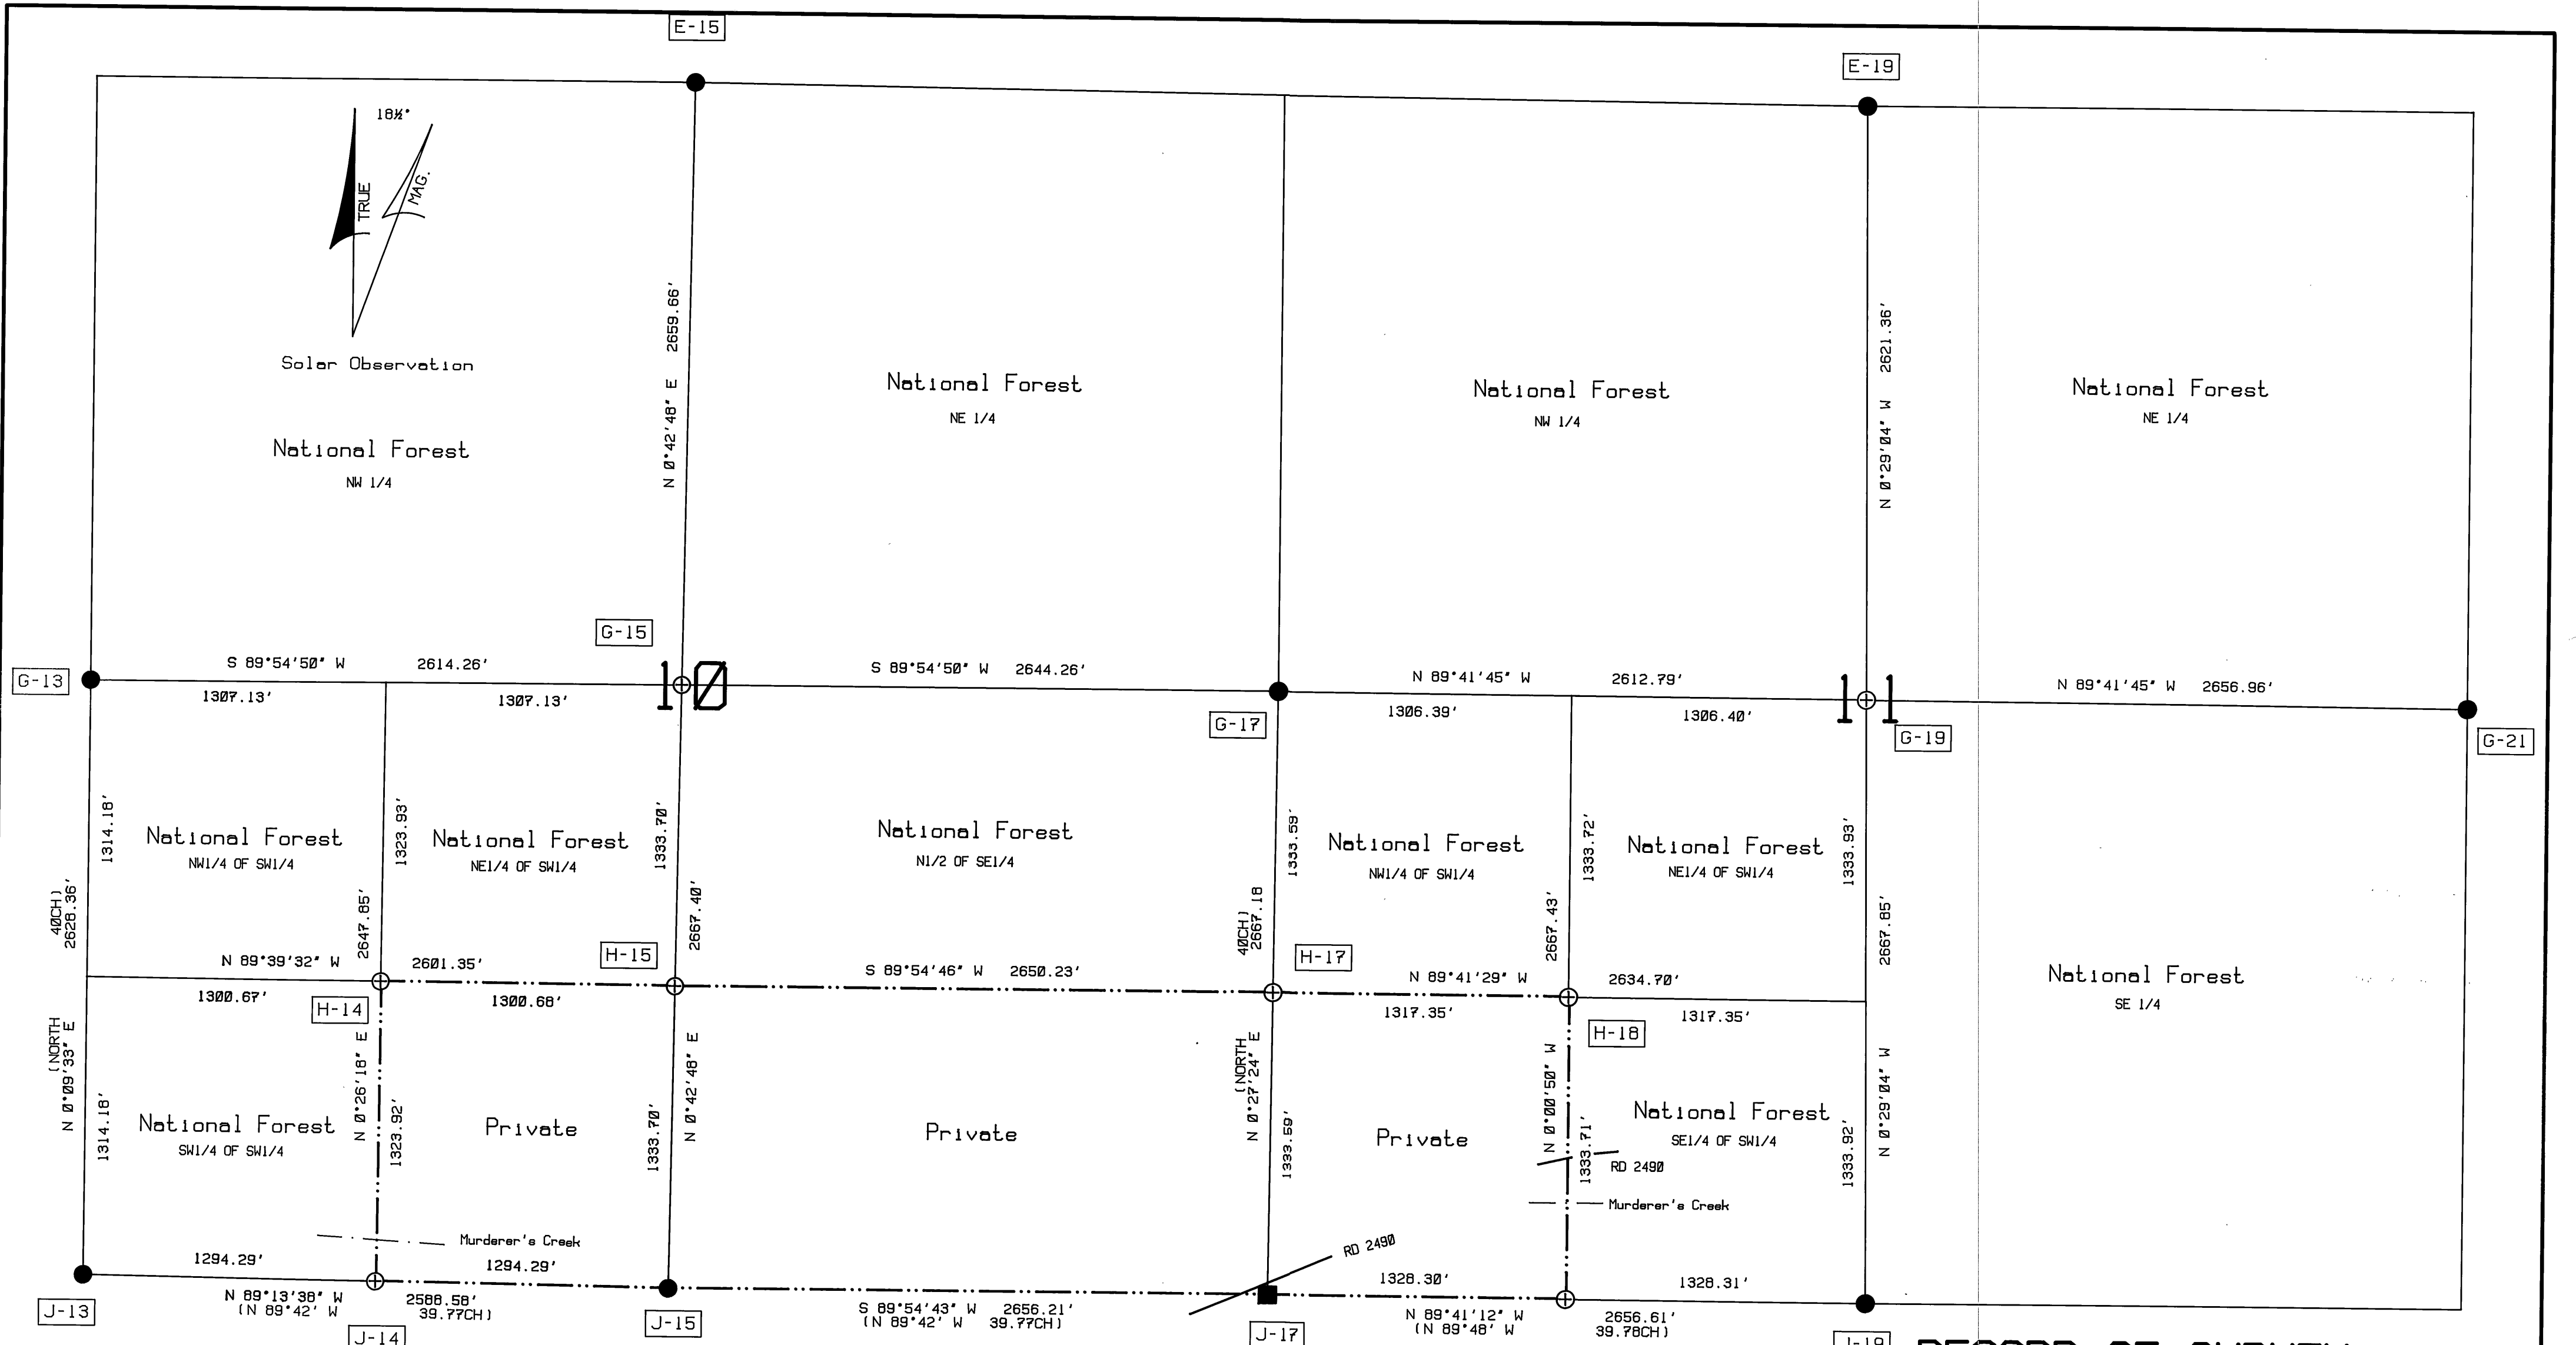

Scale: 1 in. = 500 ft.
1 foot = 0.3048 meter

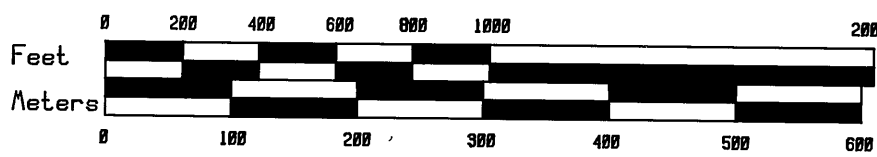

- Legend
- Found aluminum or brass cap.
 - ⊙ Found corner. Set aluminum monument.
 - ⊕ Set aluminum monument.
 - () Record Information, GLO 1881.
 - [] Record Information
 - () Record Information
 - Boundary line posted this contract.
 - ⊙ Corner reference.

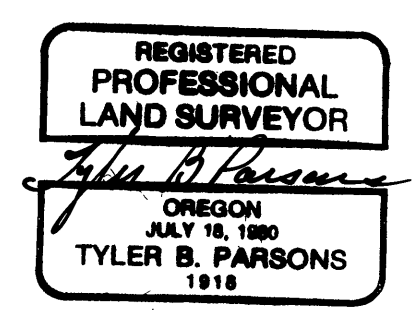

EXAMINED AND ACCEPTED FOR THE U.S. FOREST SERVICE
THIS 9th DAY OF September 1988.
I CERTIFY THAT THIS SURVEY WAS PERFORMED AT THE
REQUEST OF THE MALHEUR NATIONAL FOREST SUPERVISOR.
SIGNATURE DATE

RECORD OF SURVEY
for the
U.S. FOREST SERVICE
Malheur National Forest
Sec. 10 & 11, T15S, R28E, W.M.
Grant County, OR
Smokey Cadestral Survey
Cont. No. 53-04H1-7-4011
August 14, 1988
PARSONS SURVEYING
1915 S.E. Stone Street
Corvallis, OR 97333
(503) 752-7515
Job No. 8722H

RECEIVED AND FILED
NOV 4 1988
OFFICE OF COUNTY SURVEYOR
Attest: [Signature]

Sheet 1 of 2