


NARRATIVE: This survey was performed at the request of Bob Stanbro. The purpose of this survey was to delineate the tract of land shown hereon from his ranch. A search was made of the available records pertaining to this survey. Field measurements were made to locate the appurtenant controlling corners of section 13 as shown. The new monument at the SW corner of this tract was set on the E-W center of section line as shown. The other monuments were set at locations approved by Mr. Stanbro. In my research, I found that the county court, upon petition, ordered that the county road along W. boundary of Sec. 18 be viewed, located by survey and the reports thereof filed. Thereupon the county court considered, ordered, and declared this a county road, May 3, 1906, recorded in County Commissioner's Journal Book G, Page 558. I found no record of the county vacating or abandoning this county road.

RECEIVED AND  
FILED

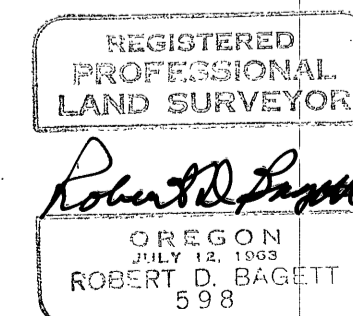

**BASIS OF BEARINGS**  
SOLAR OBSERVATION

### LEGEND

- Found 1-1/2" iron pipe with attached Grant County Surveyor Brass Cap.
- Set 5/8"x30" iron pin with attached yellow plastic cap marked BGA SURVEY MARKER.
- x — x Fence line
- ( ) Record bearing and distance

### REFERENCES

- Deed Record Book 97 Page 8
- GLO Notes
- Commissioners Journal Book G Page 558

<b>BAGETT - GRIFFITH &amp; ASSOCIATES</b> John Day, Oregon		
MAP OF SURVEY A TRACT OF LAND SITUATED IN THE NE 1/4 OF SECTION 13, T13S, R33E, W.M.		
GRANT COUNTY, OREGON		
SURVEYED FOR	BOB STANBRO	
SURVEYED BY	R.D.B. & J.L.W.	11-28-88
Scale: 1" = 200'	Drawn by: J.L.W.	11-30-88

RECORD MAP OF SURVEY NO. 1058