


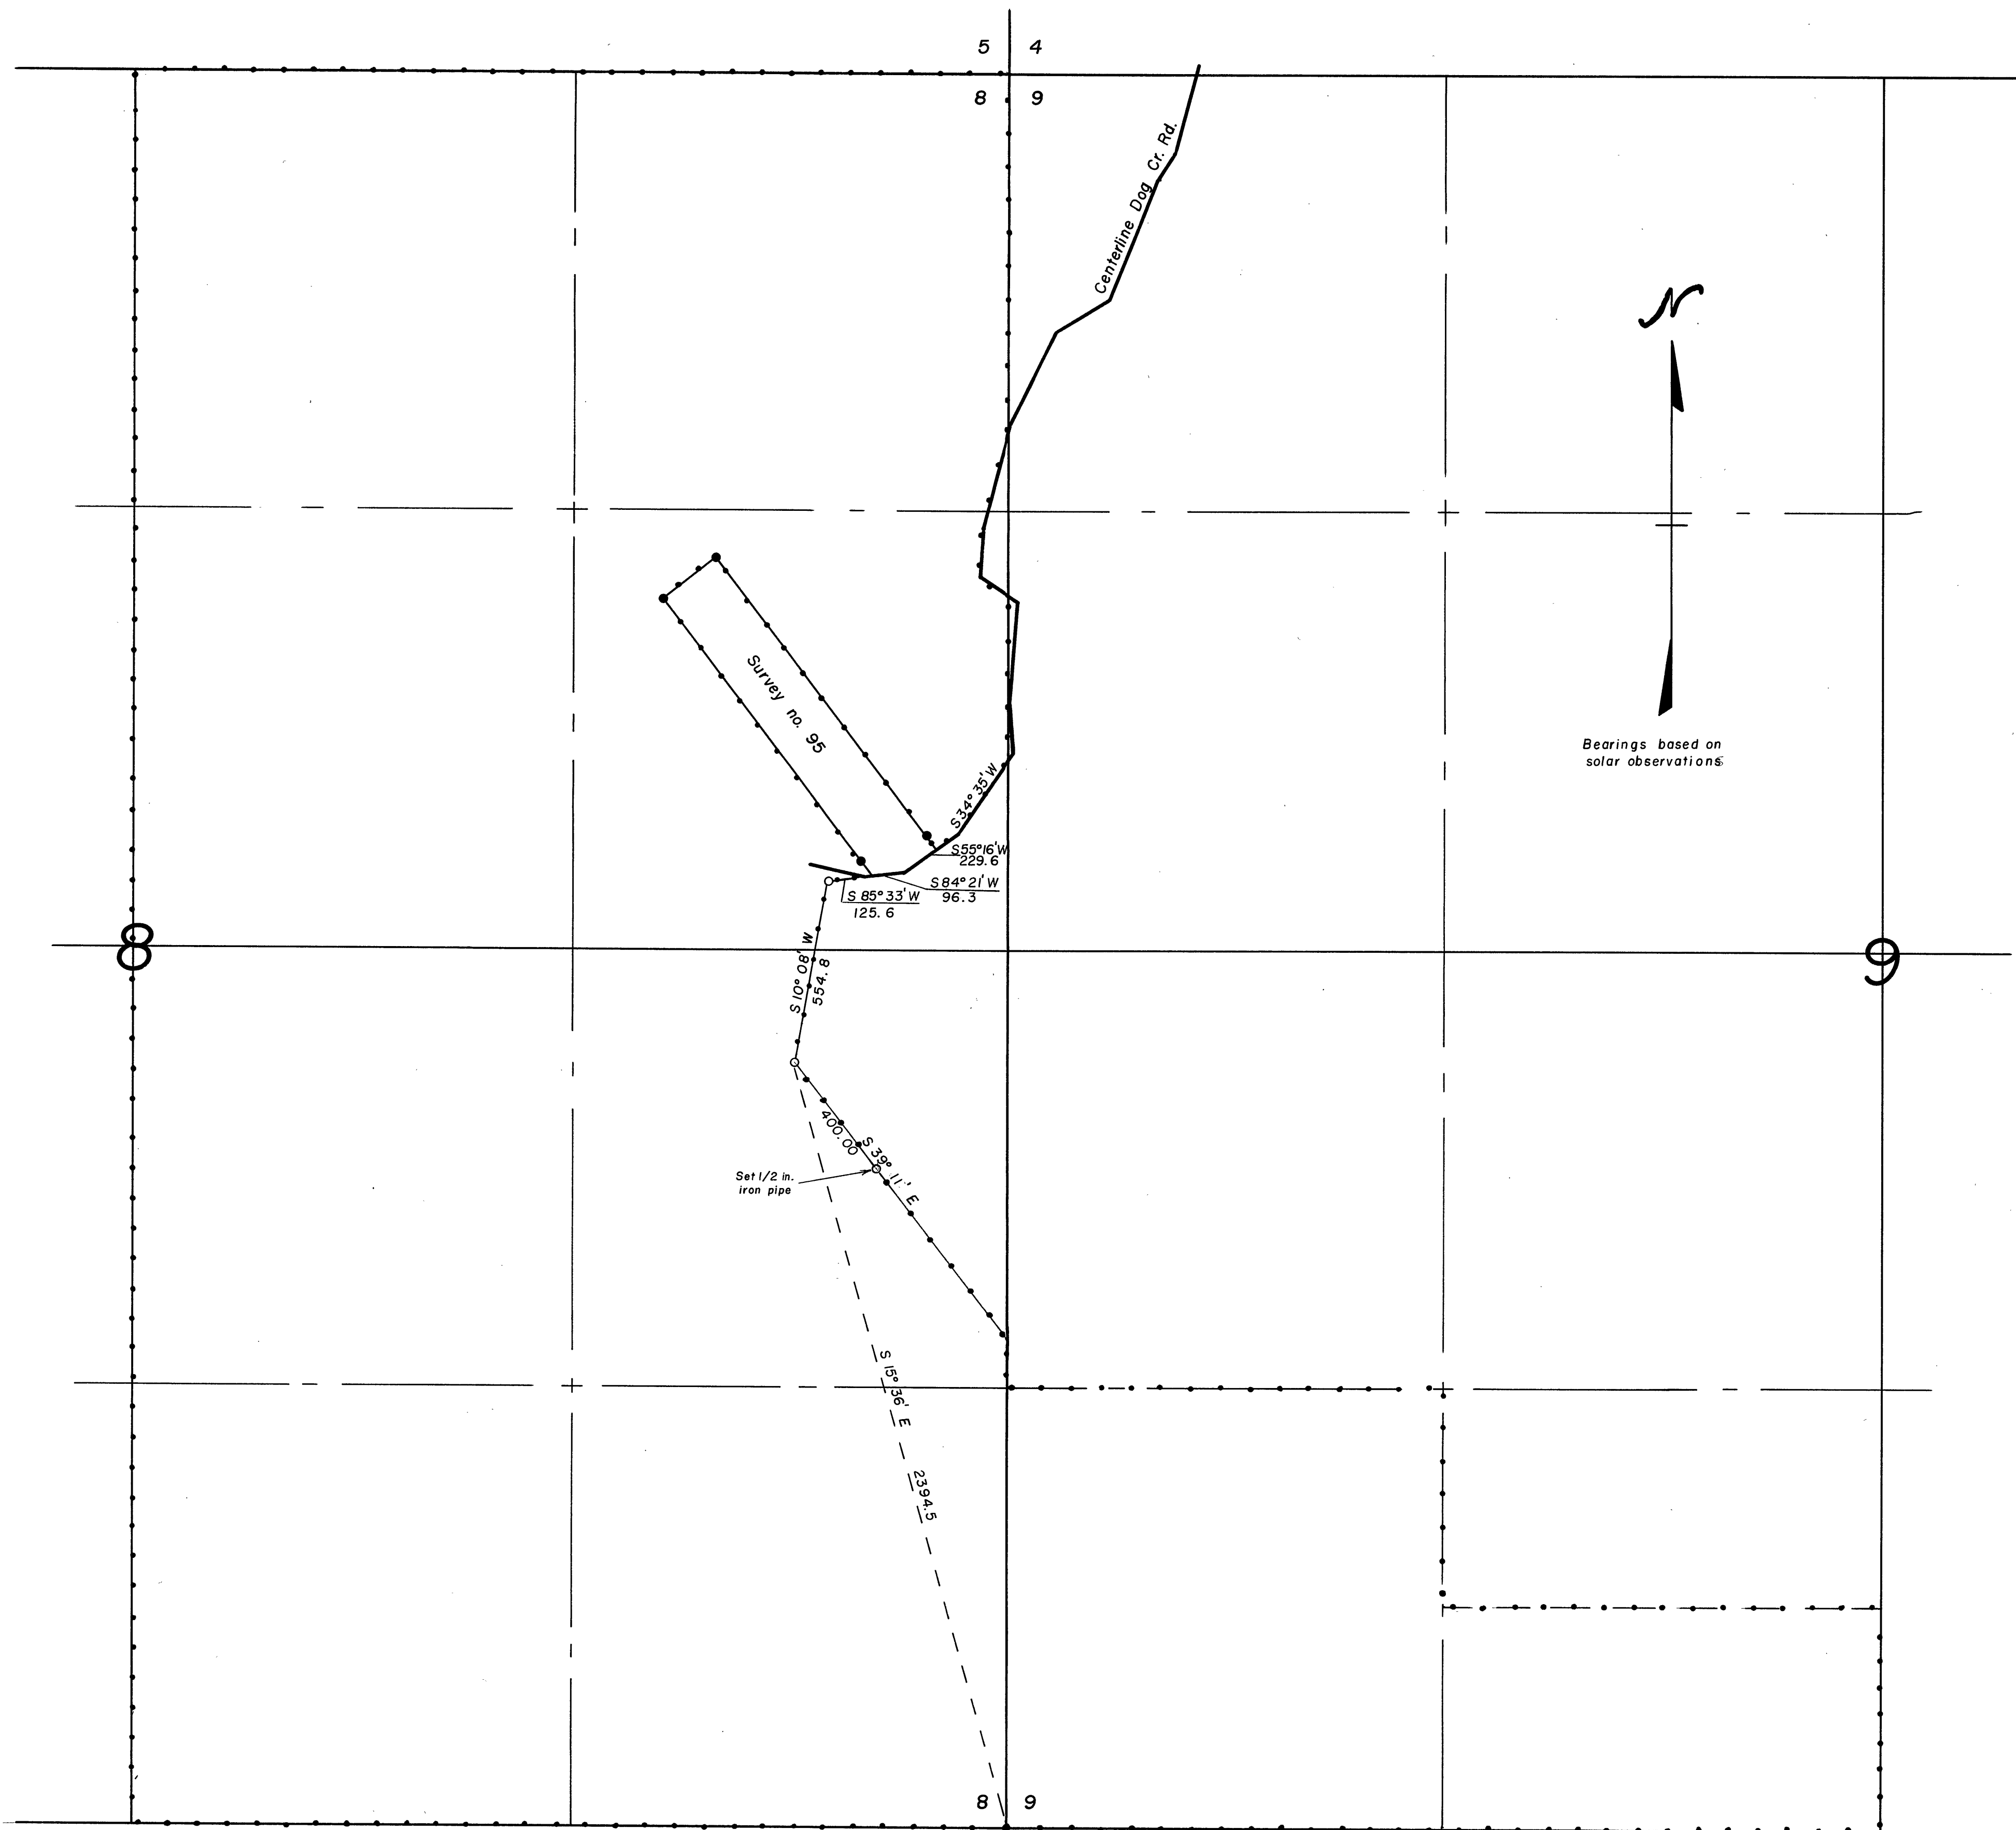

RECEIVED AND
FILED

MAY 15 - 1968
JOHN LIVEIRA, County Clerk

By Deputy

REGISTERED
OREGON
LAND SURVEYOR

JULY 10, 1964
DUANE I. GRIFFITH
644

- Fd. monuments
- Set 1/2" iron pin
- Perimeter of land to be conveyed

BAGETT & GRIFFITH SURVEYING		
JOHN DAY, OREGON		
Map of Survey		
Portions of Sections 8, & 9.		
T 14 S, R 32 E, W.M.		
GRANT COUNTY, OREGON		
Surveyed for	CARL SHEEDY	
Surveyed by	RDB & DIG	4/1968
Scale: 1" = 300'	Drawn by DIG	4/1968

Survey Map # 106