



Legend

- Found aluminum or brass cap.
- Found corner. Set aluminum monument.
- Set aluminum monument.
- () Record Information, Moore & Thompson, 1881.
- [] Record Information, Robb & Graden, 1881.
- () Record Information, Graden, 1881.
- Boundary line posted this contract.
- Corner reference.

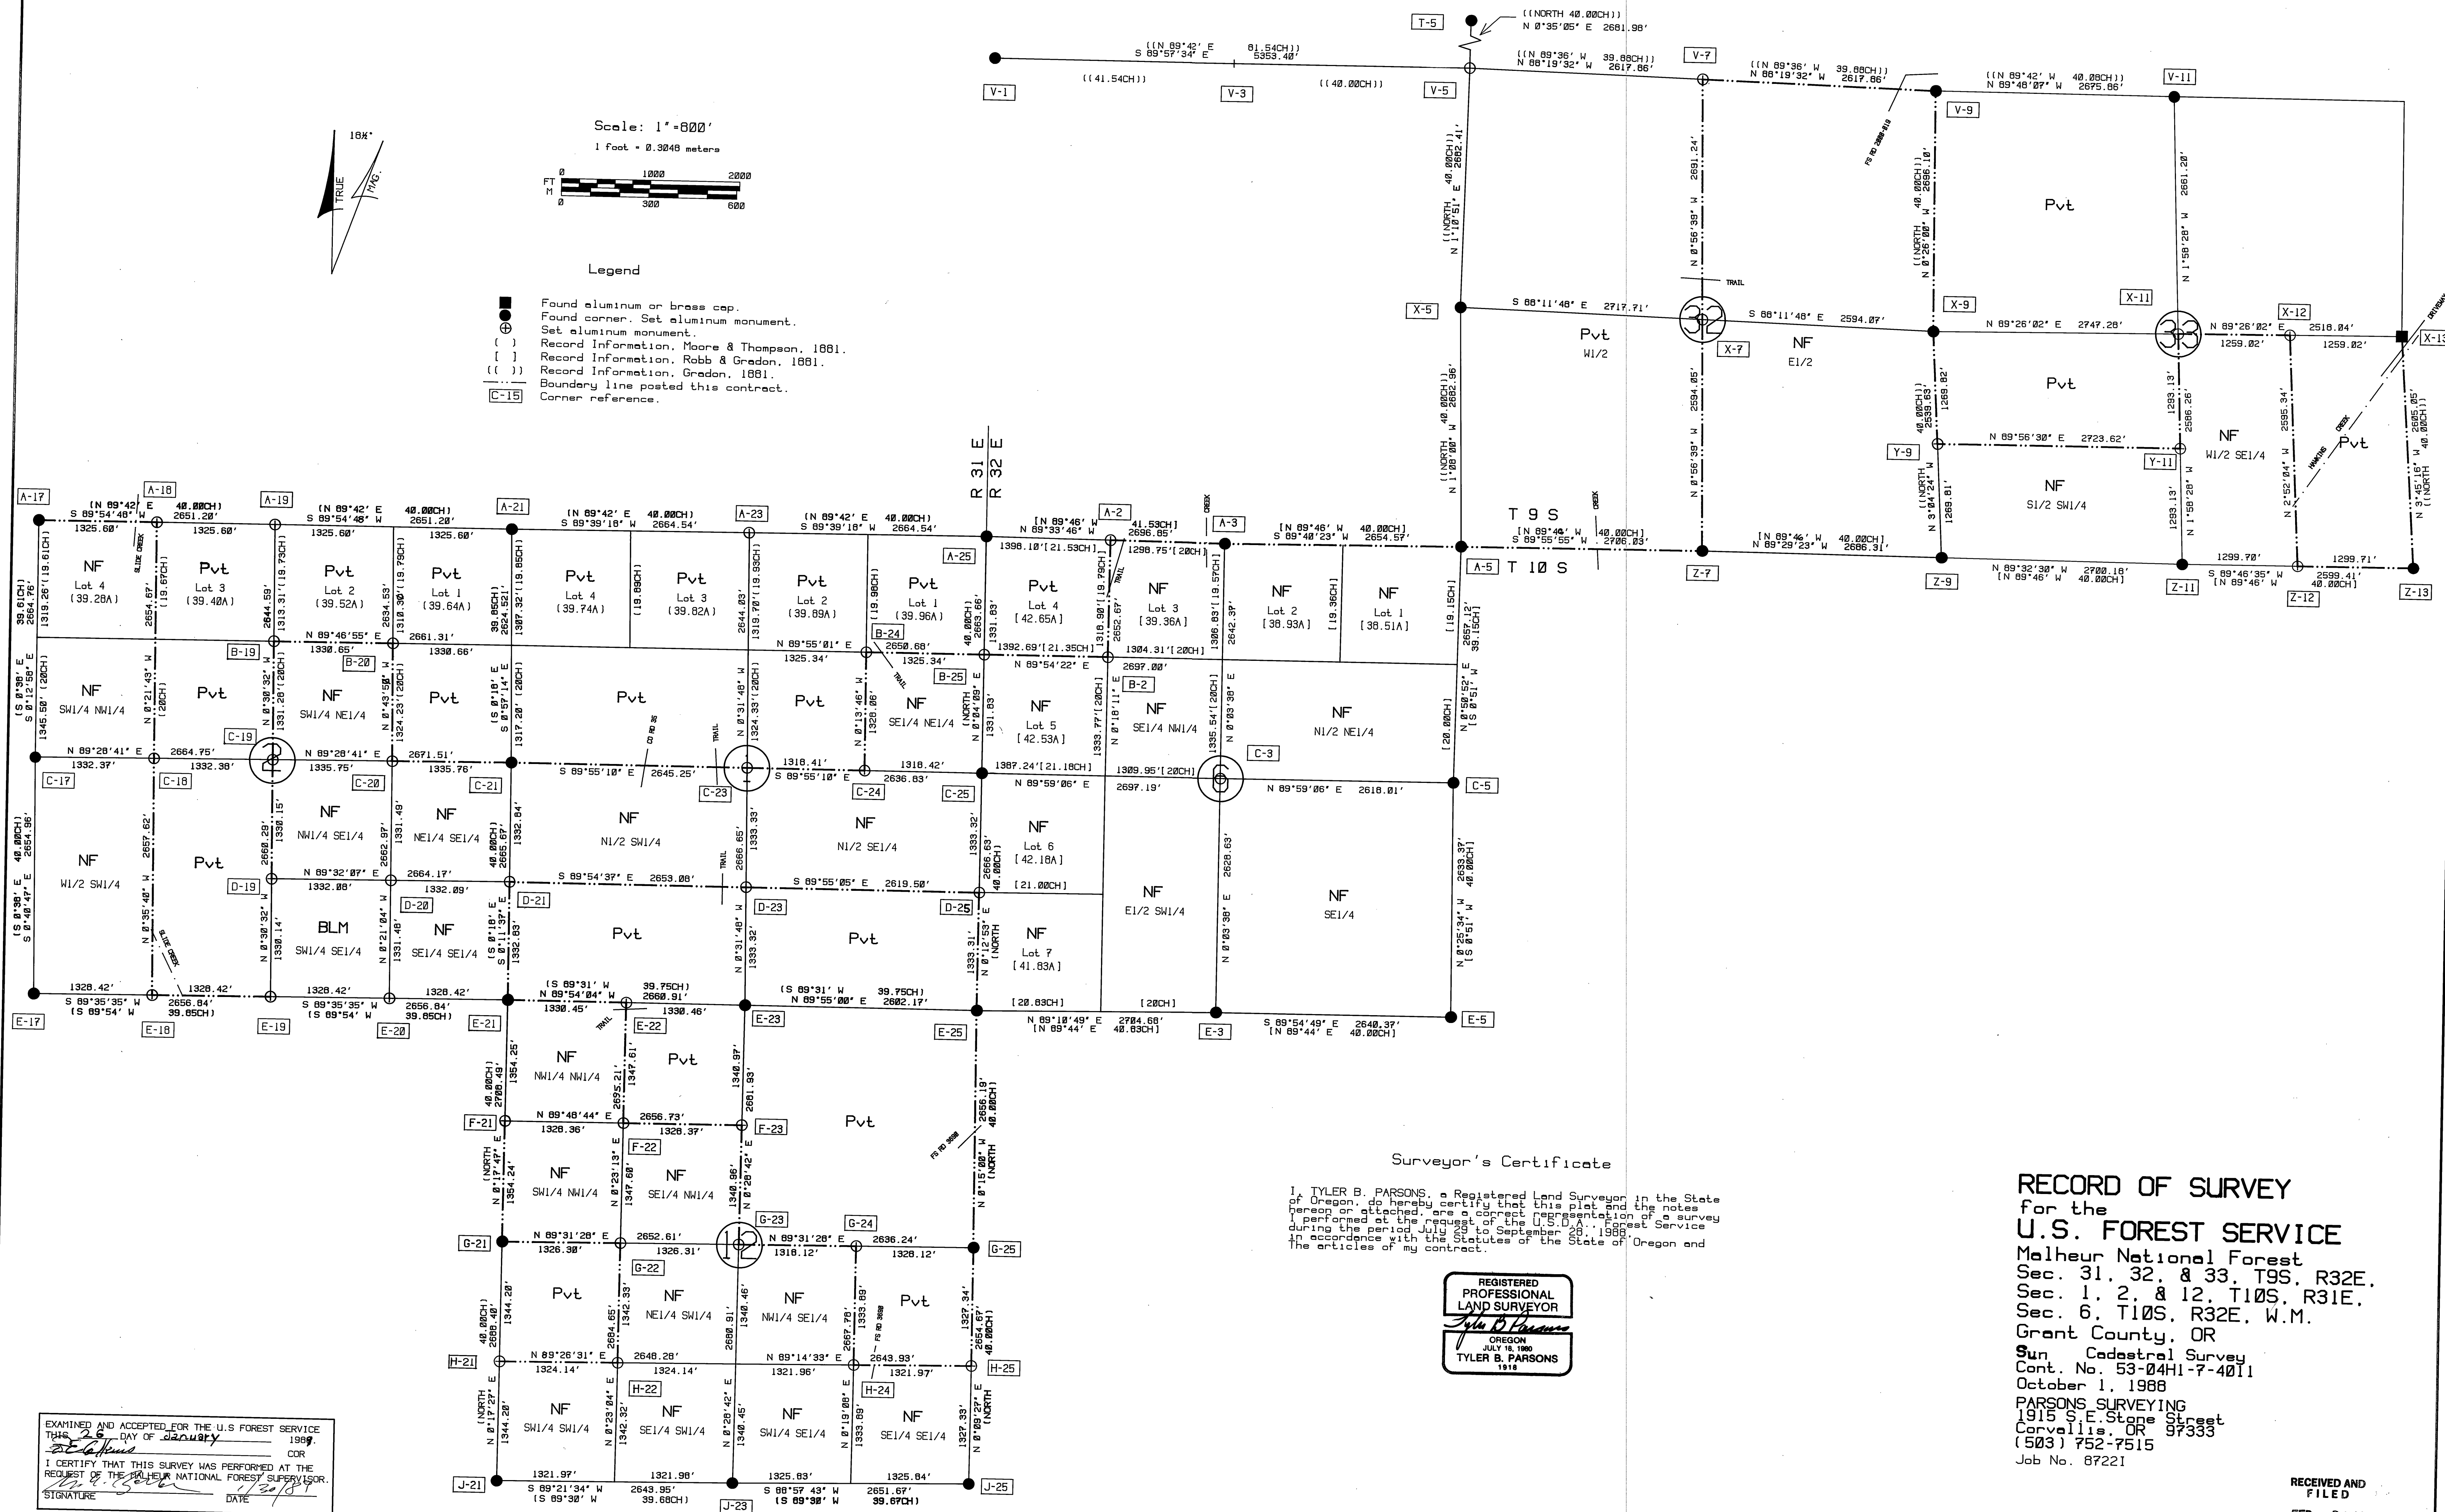

Surveyor's Certificate

I, TYLER B. PARSONS, a Registered Land Surveyor in the State of Oregon, do hereby certify that this plat and the notes hereon attached, are a correct representation of a survey performed at the request of the U.S.D.A., Forest Service during the period July 29 to September 28, 1988, in accordance with the Statutes of the State of Oregon and the articles of my contract.

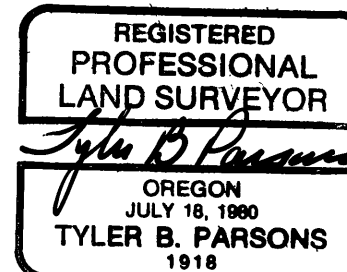

RECORD OF SURVEY
for the
U.S. FOREST SERVICE
Malheur National Forest
Sec. 31, 32, & 33, T9S, R32E.
Sec. 1, 2, & 12, T10S, R31E.
Sec. 6, T10S, R32E, W.M.
Grant County, OR
Sun Cadastrol Survey
Cont. No. 53-04H1-7-4011
October 1, 1988
PARSONS SURVEYING
1915 S.E. Stone Street
Corvallis, OR 97333
(503) 752-7515
Job No. 87221

RECEIVED AND
FILED

FEB 7 1989

OFFICE OF COUNTY SURVEYOR
ATTEST: *[Signature]*

EXAMINED AND ACCEPTED FOR THE U.S. FOREST SERVICE
THIS 26 DAY OF January 1989
I CERTIFY THAT THIS SURVEY WAS PERFORMED AT THE
SIGNATURE: *[Signature]* DATE: 1/26/89