

PARTIAL RESURVEY OF 3rd STANDARD PARALLEL SOUTH THROUGH TOWNSHIP 12 SOUTH, RANGES 26-27 EAST, W.M.


SURVEY MADE ON SEPT. 24, OCT. 6-7, 1965, BY THE BUREAU OF
LAND MANAGEMENT, USING ENGINEER'S TRANSIT & 300' TAPE

T.12 S., R.26 E.

T.12 S., R.27 E.

SCALE : 1" = 500'

RECEIVED AND
FILED
MAY 18 1968
JOHN LIVEIRA, County Clerk
By _____ Deputy

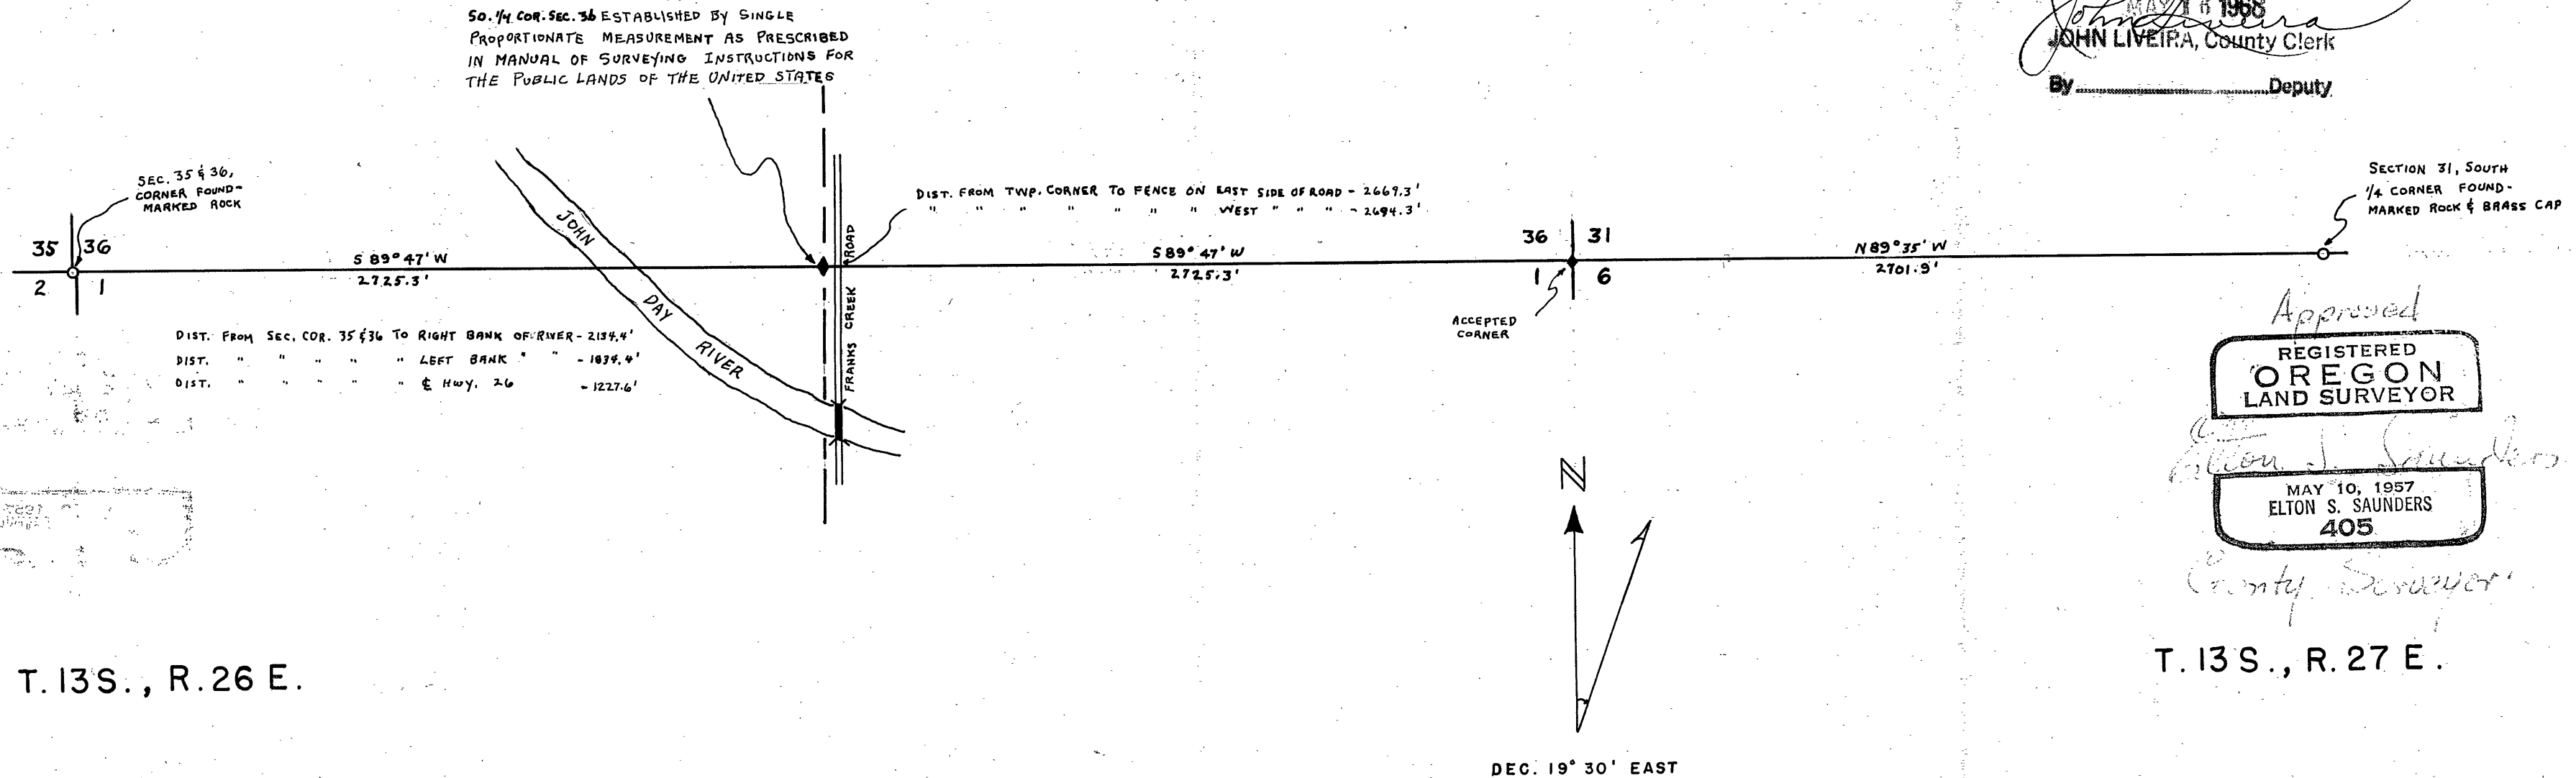

Survey Map #107