



MAP OF SURVEY
of New Eastridge Drive County Road in the
SW1/4 of Section 36, T13S, R31E, WM

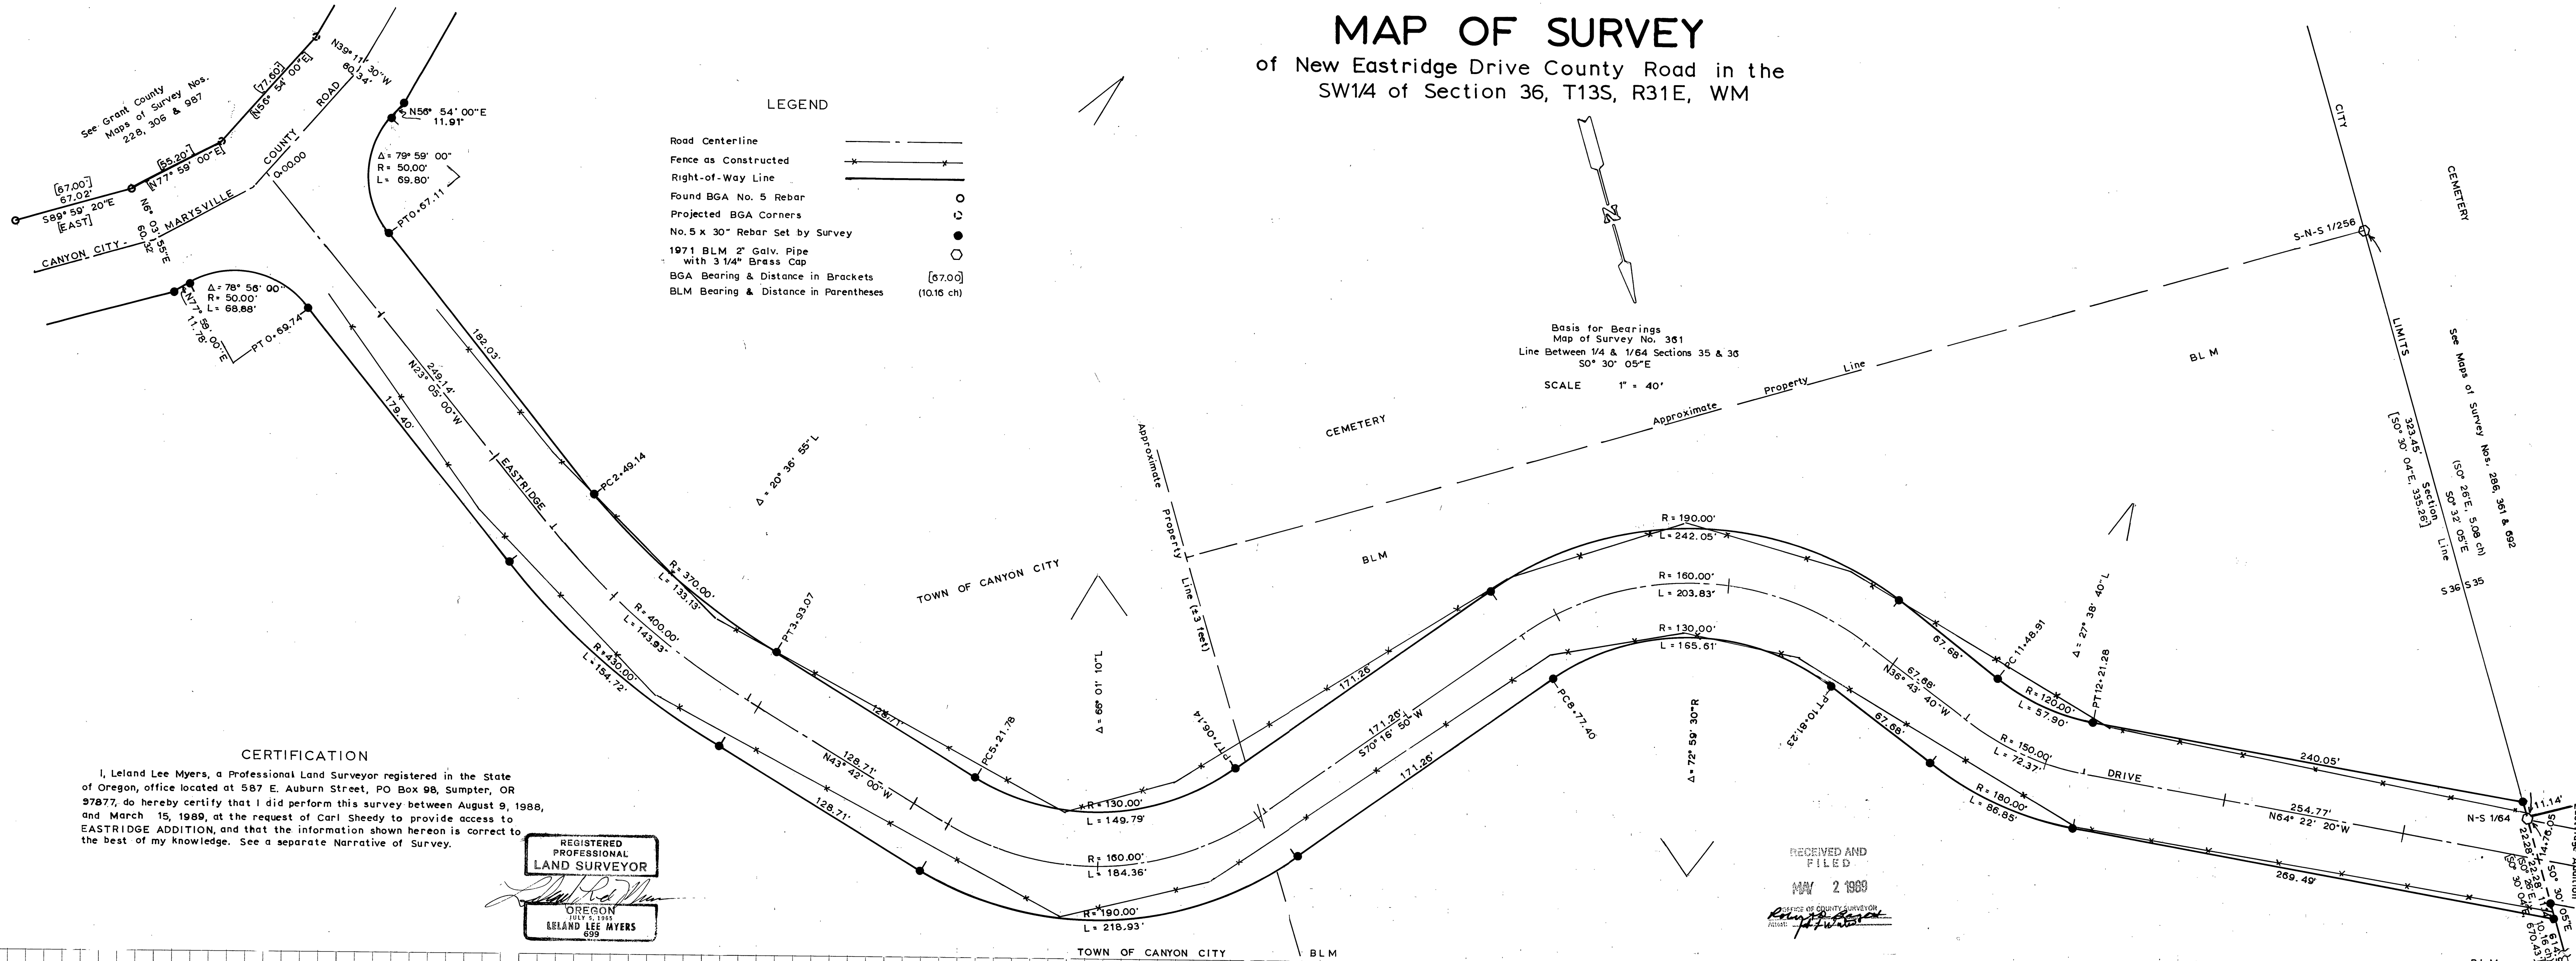

Grade of road bed as constructed at time of survey.

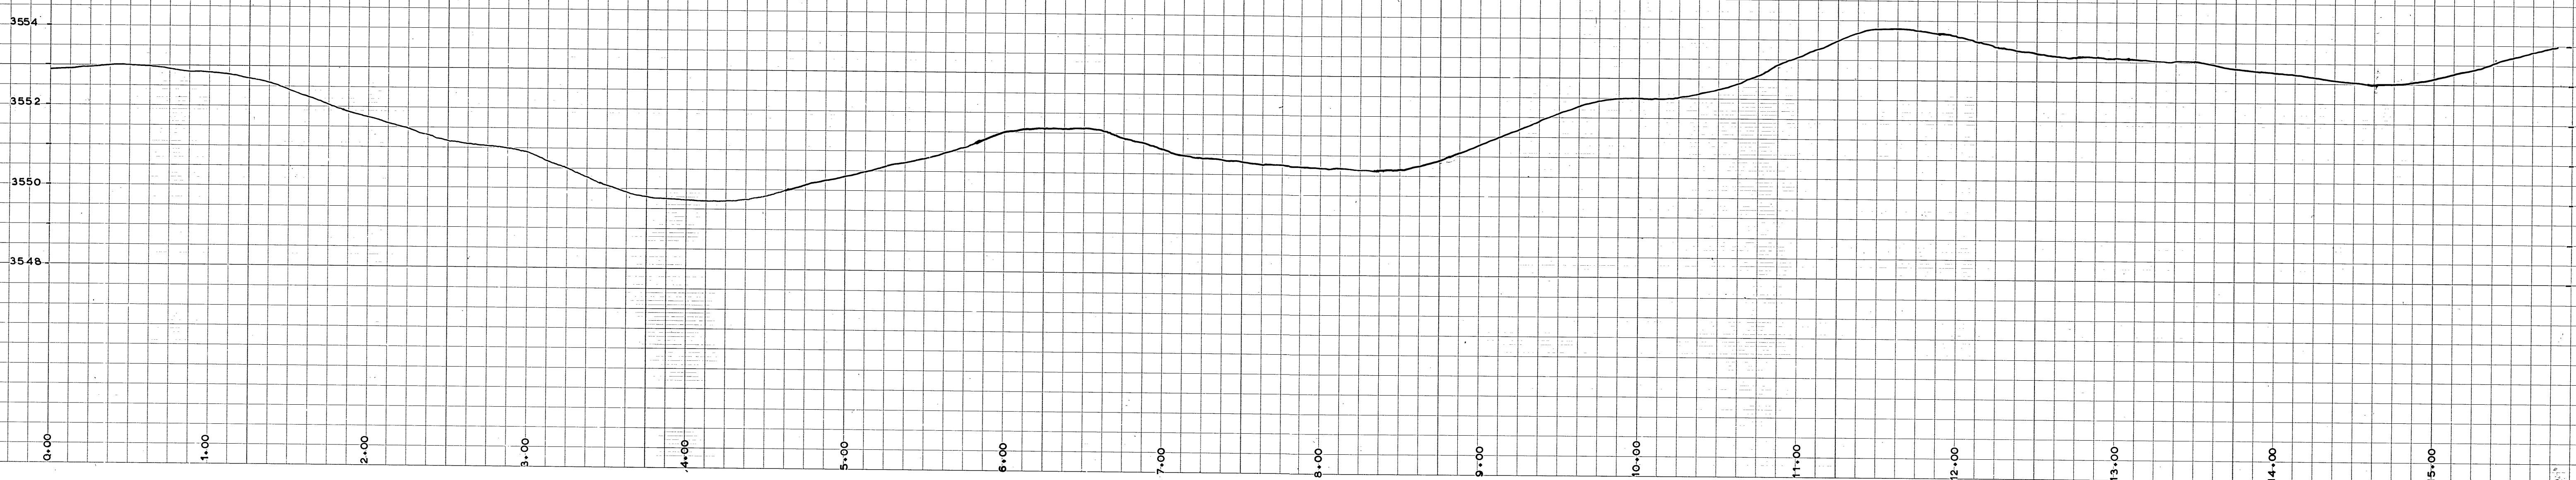


