



EXAMINED AND APPROVED FOR THE U.S. FOREST SERVICE
THIS 31st DAY OF May, 1989.
S.E. Blum, COR.
I CERTIFY THAT THIS SURVEY WAS PERFORMED AT THE
REQUEST OF THE MALHEUR NATIONAL FOREST SUPERVISOR.
Mal Blum 5/31/89
SIGNATURE DATE

Scale: 1 in. = 600 ft.

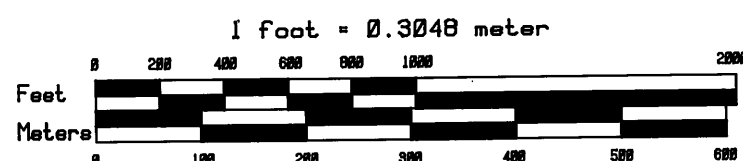



Legend

- Found aluminum or brass cap.
- Found corner. Set aluminum monument.
- Set aluminum monument.
- () Record Information, GLO 1880.
- [] Record Information
- ([]) Record Information, GLO 1881.
- Boundary line posted this contract.
- [C-15] Corner reference.

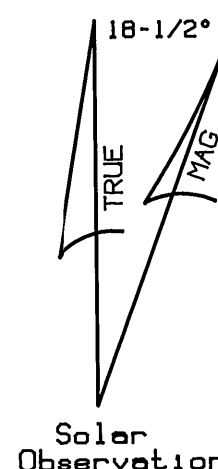

Surveyor's Certificate

I, TYLER B. PARSONS, a Registered Land Surveyor in the State of Oregon, do hereby certify that this plot and the notes hereon or attached, are a correct representation of a survey performed at the request of the U.S.D.A., Forest Service, during the period 25 November 1988 to April 10, 1989, in accordance with the Statutes of the State of Oregon and the articles of my contract.

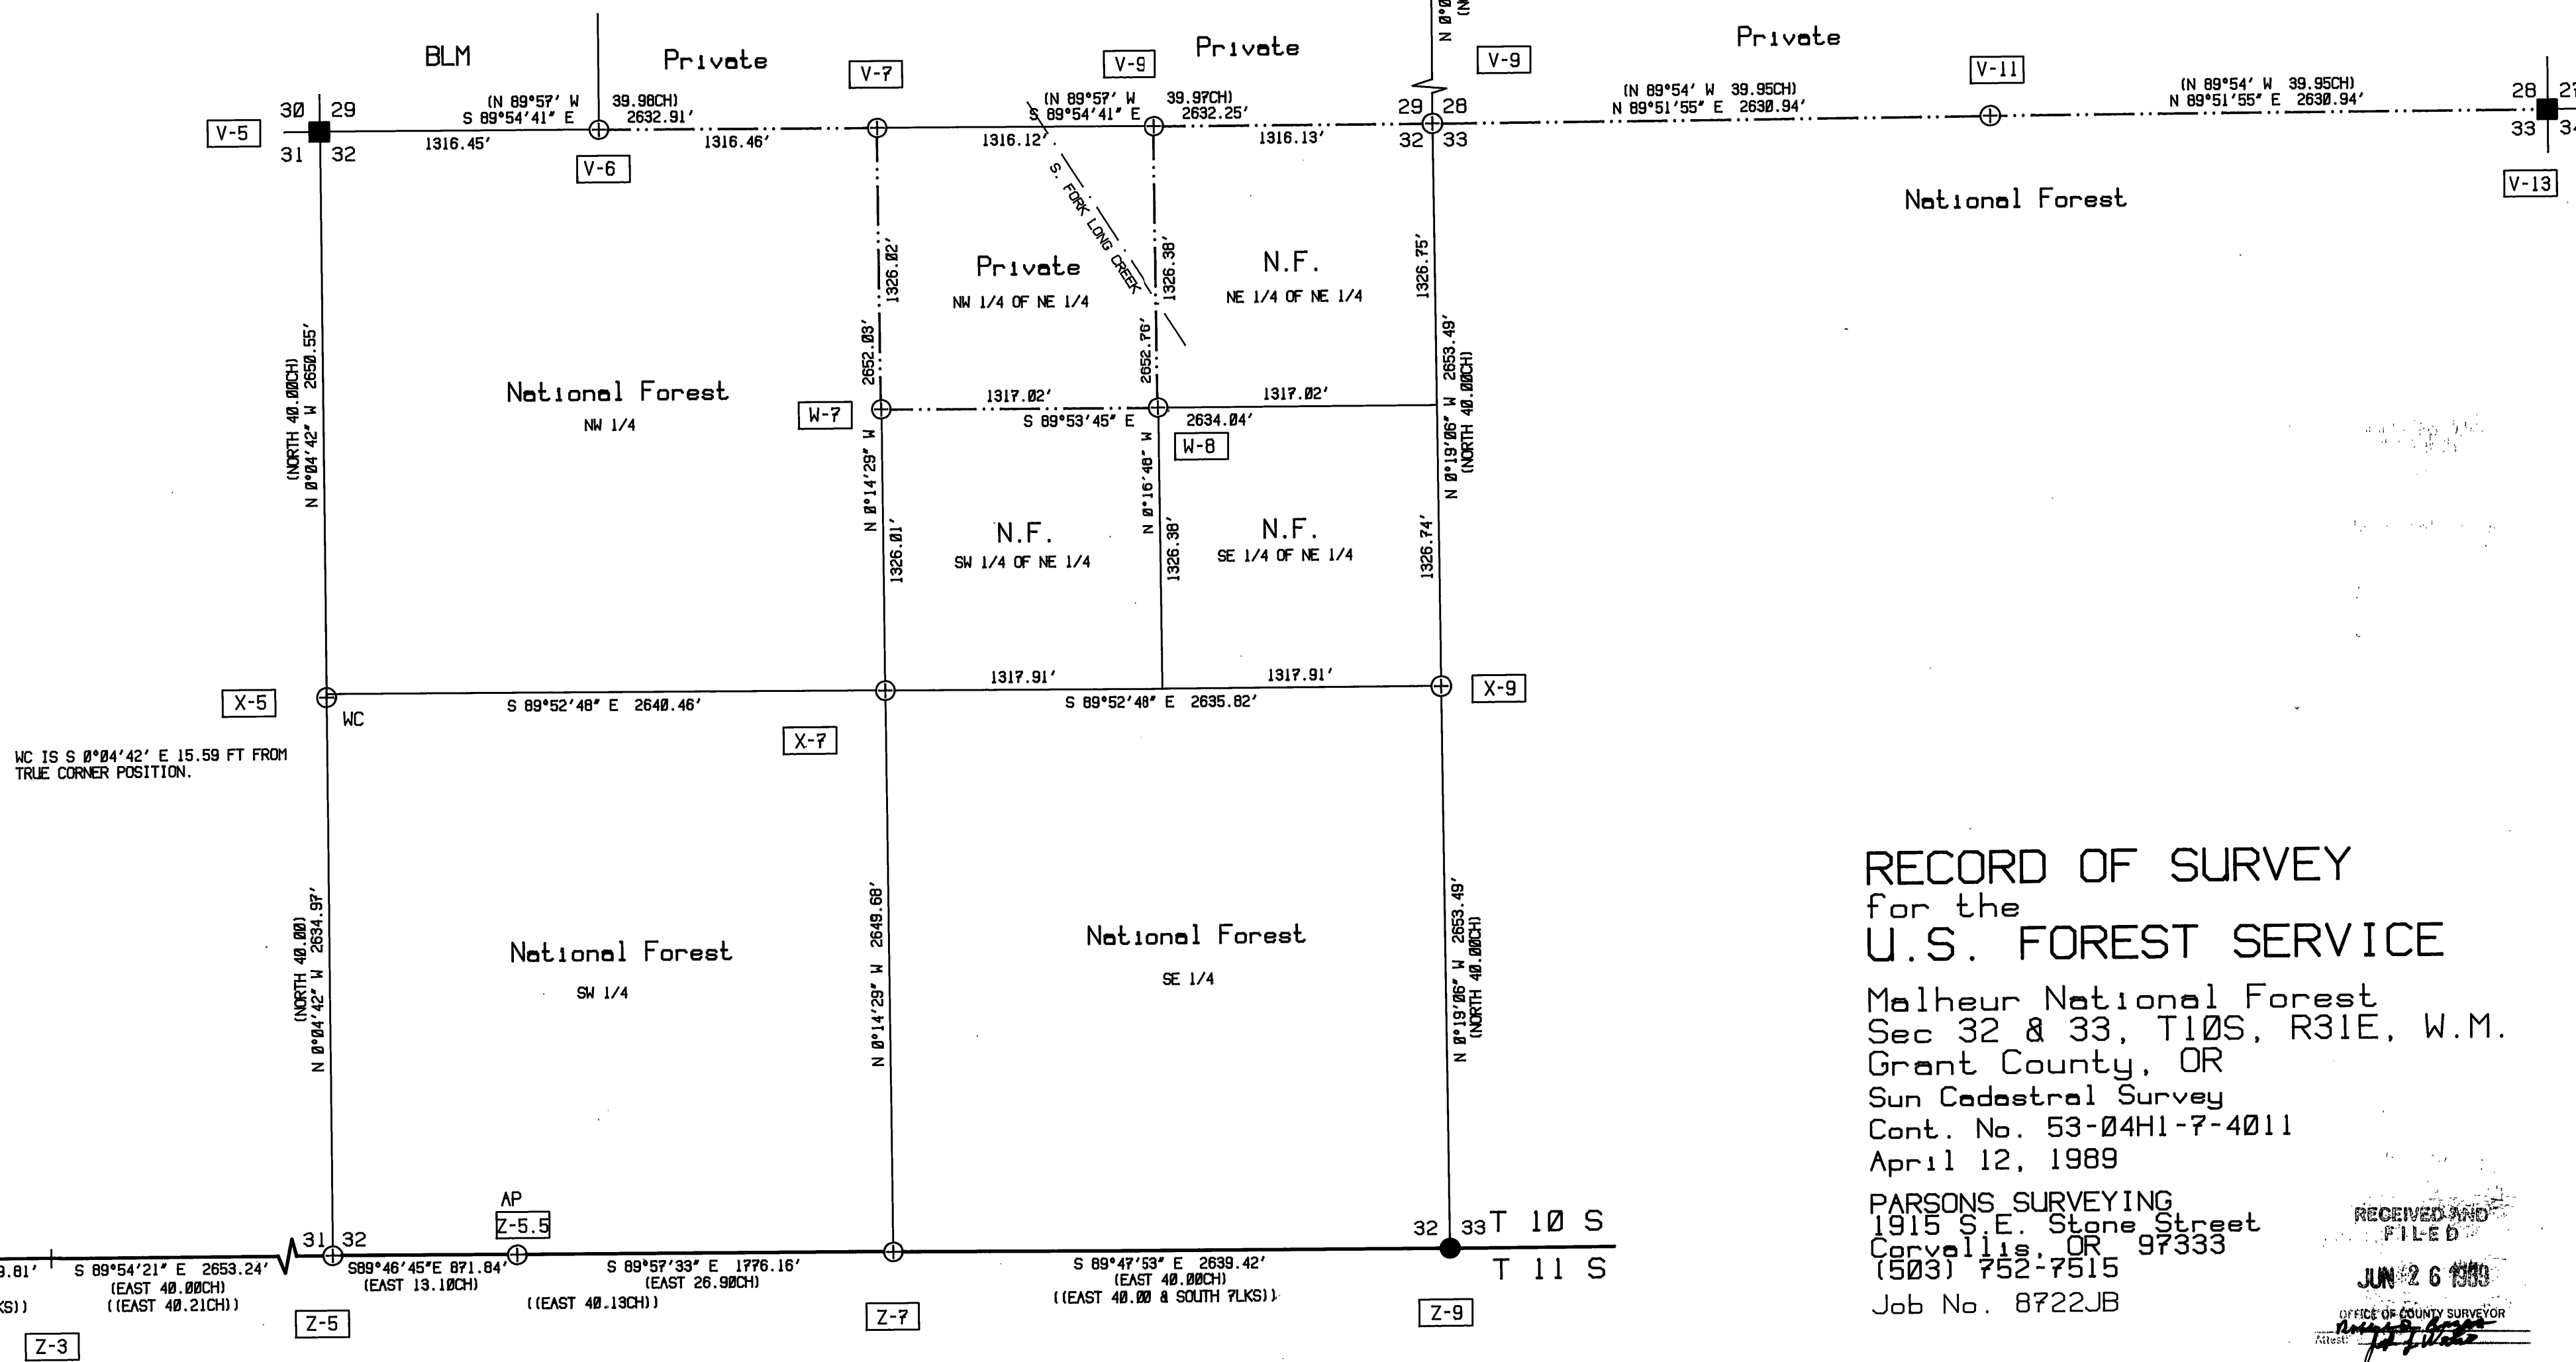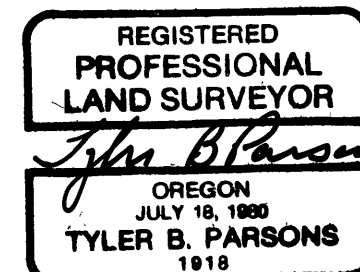

RECORD OF SURVEY for the U.S. FOREST SERVICE

Malheur National Forest
Sec 32 & 33, T10S, R31E, W.M.
Grant County, OR
Sun Cadastral Survey
Cont. No. 53-04H1-7-4011
April 12, 1989

PARSONS SURVEYING
1915 S.E. Stone Street
Corvallis, OR 97333
(503) 752-7515
Job No. 8722JB

RECEIVED AND
FILED

JUN 26 1989

OFFICE OF COUNTY SURVEYOR
Attest: [Signature]