

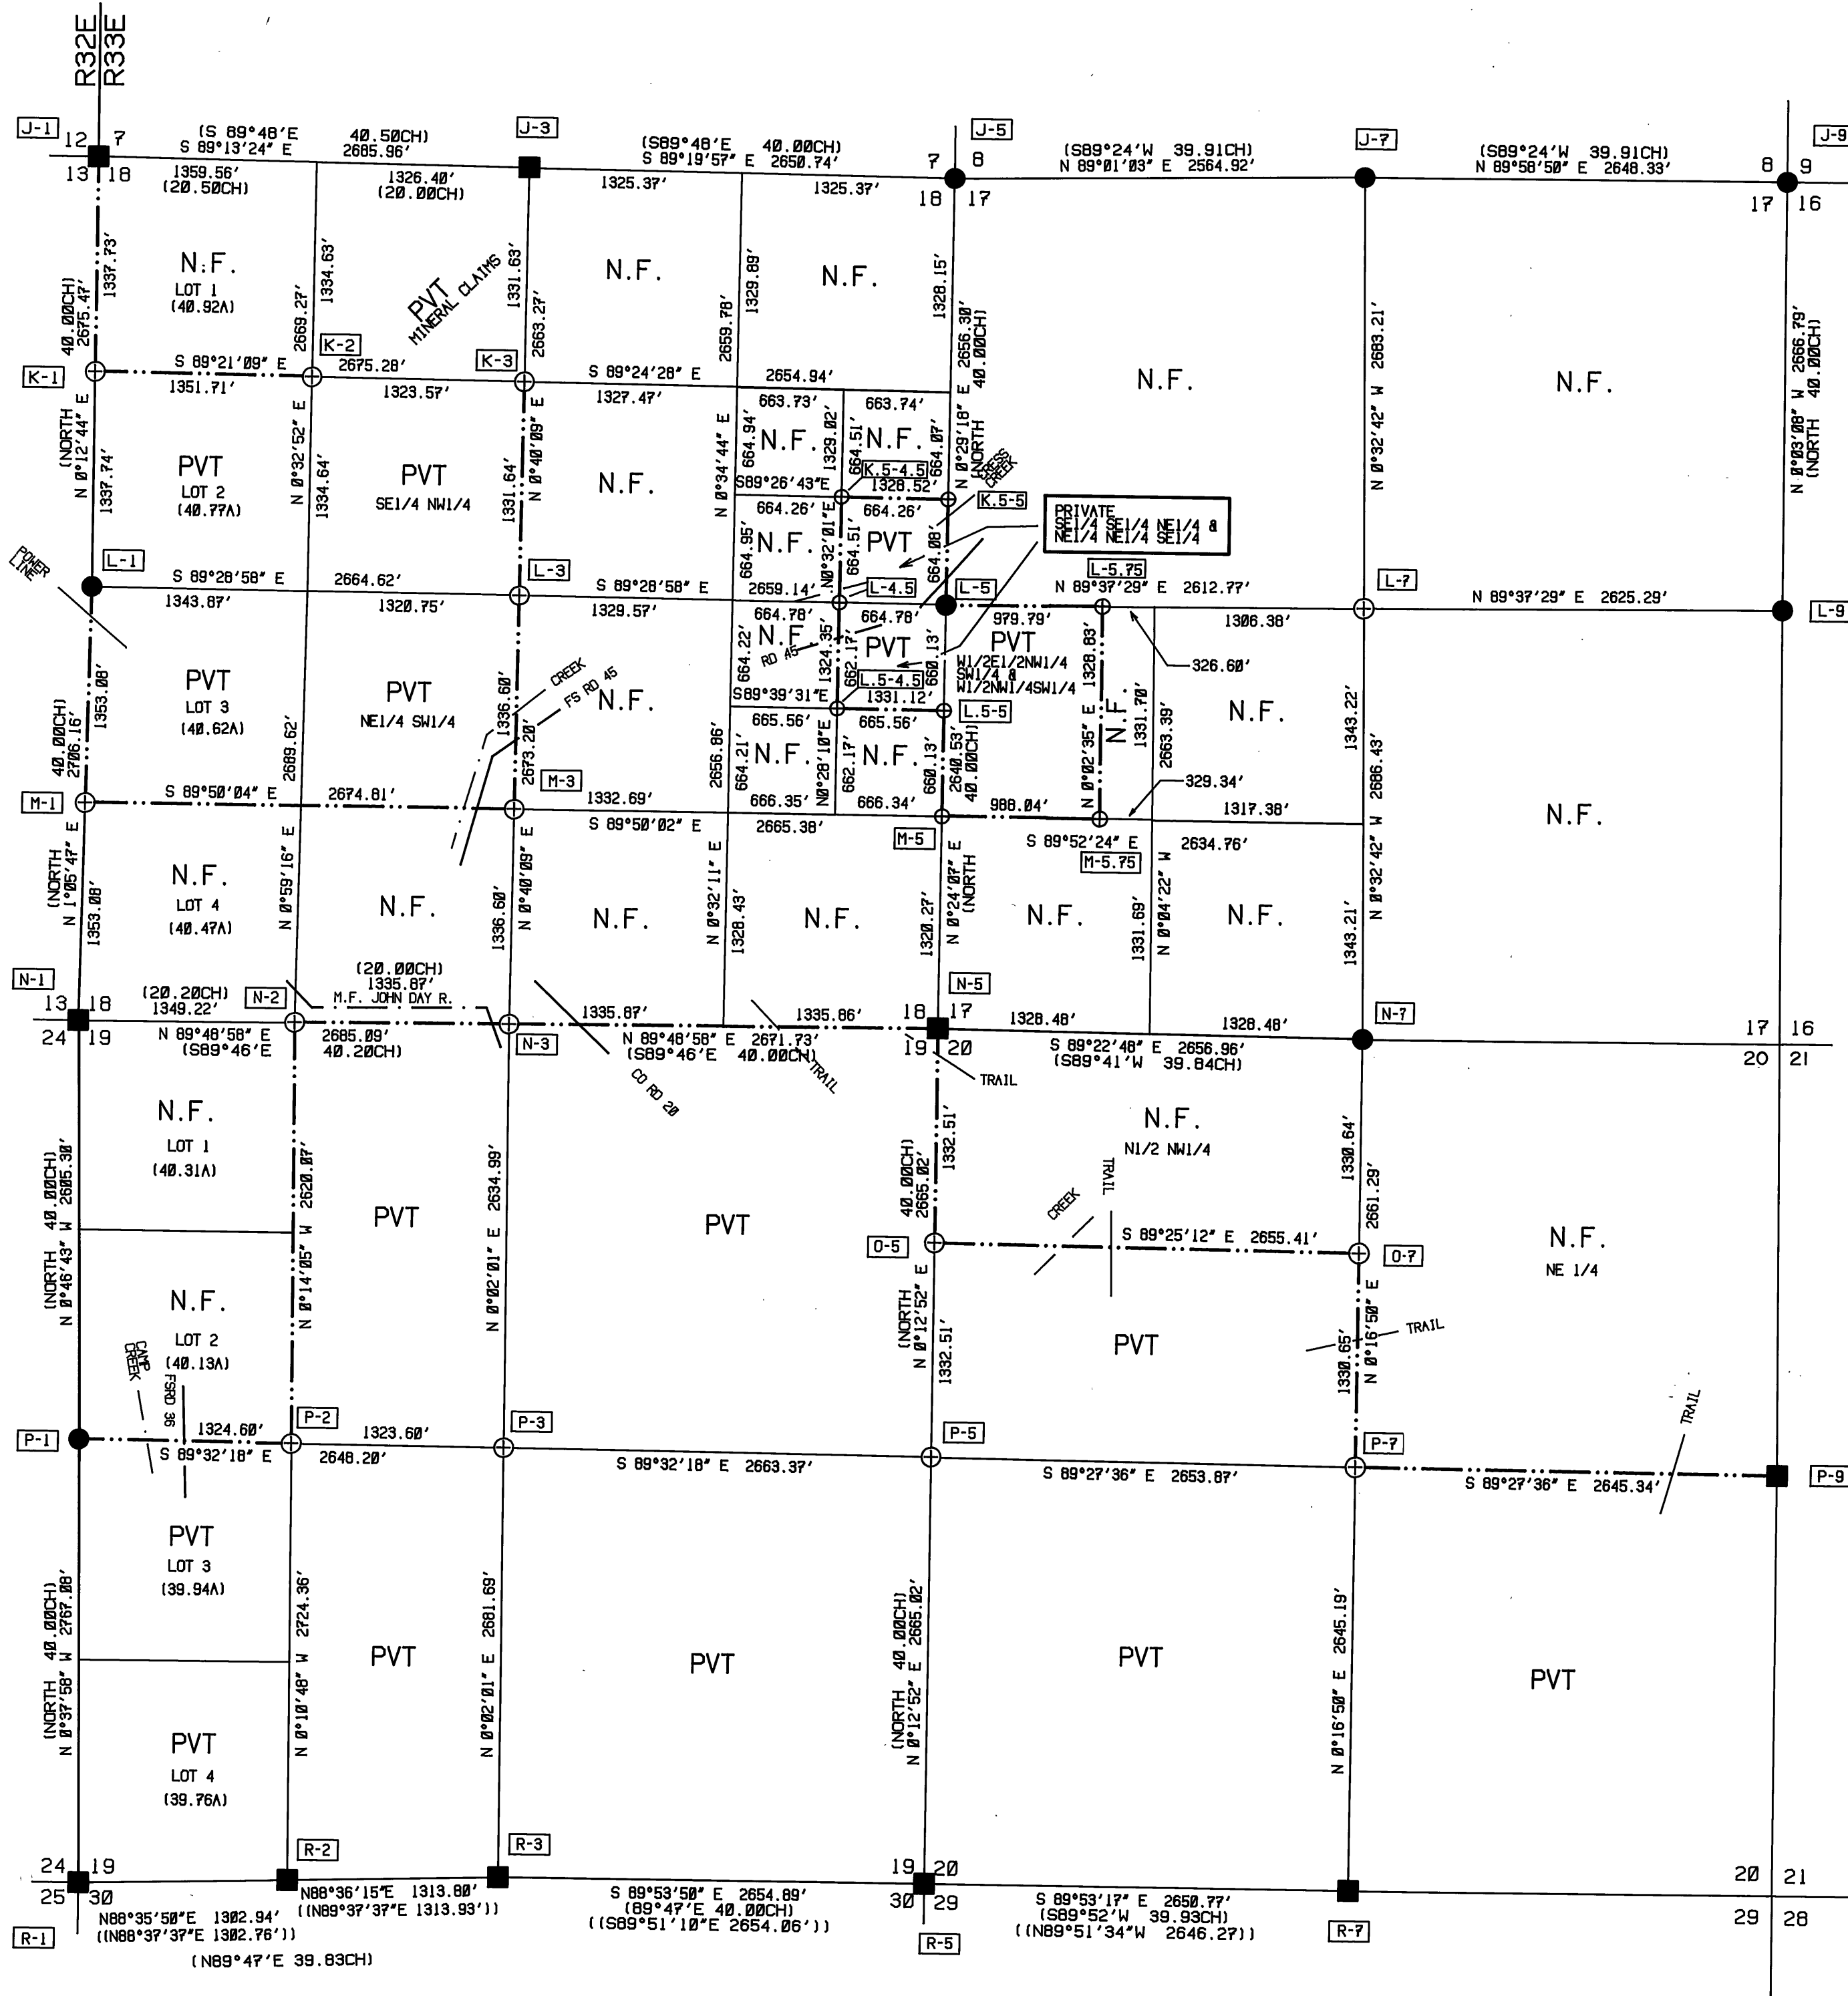


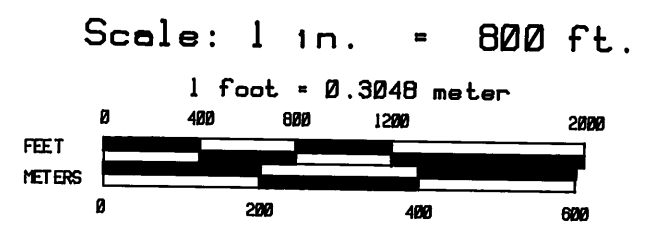

EXAMINED AND APPROVED FOR THE U.S. FOREST SERVICE
 THIS DAY OF May, 1989.
 I CERTIFY THAT THIS SURVEY WAS PERFORMED AT THE
 REQUEST OF THE MALHEUR NATIONAL FOREST SUPERVISOR.
 SIGNATURE Tyler B. Parsons DATE 7/9/89

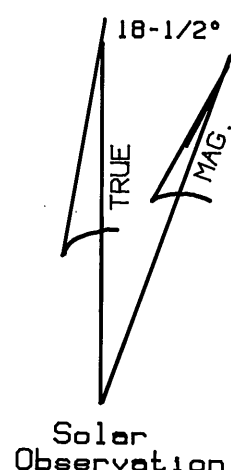

- Legend**
- Found aluminum or brass cap.
 - Found corner. Set aluminum monument.
 - Set aluminum monument.
 - () Record Information, GLO 1881.
 - [] Record Information, CS 529.
 - ([]) Record Information, CS 624.
 - Boundary line posted this contract.
 - [C-15] Corner reference.


National Forest Description

Section 17, excepting the W1/2 E1/2 NW1/4 SW1/4 and the W1/2 NW1/4 SW1/4.

Section 18, excepting LOT 2, LOT 3, the SE1/4 NW1/4, the NE1/4 SW1/4, and MINERAL CLAIMS, and the SE1/4 SE1/4 NE1/4, and the NE1/4 NE1/4 SE1/4.

Surveyor's Certificate

I, TYLER B. PARSONS, a Registered Land Surveyor in the State of Oregon, do hereby certify that this plat and the notes hereon or attached, are a correct representation of a survey I performed at the request of the U.S.D.A. Forest Service during the period 20 April 1989 to 17 May 1989 in accordance with the statutes of the State of Oregon and the articles of my contract.

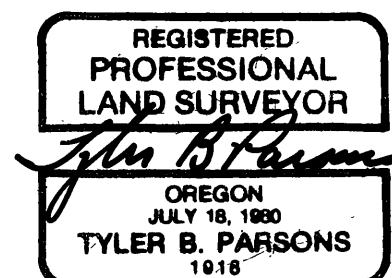

RECORD OF SURVEY
 for the
U.S. FOREST SERVICE
 Malheur National Forest
 Sec 17, 18, 19 & 20,
 T10S, R33, WM.
 Grant County, OR
 Sun Cadastral Survey
 Cont. No. 53-04H1-7-4011
 May 22, 1989
 PARSONS SURVEYING
 1915 S.E. Stone Street
 Corvallis, OR 97333
 (503) 752-7515
 Job No. 8722LA

RECEIVED AND
 FILED
 AUG 10 1989
 OFFICE OF COUNTY SURVEYOR
