NARRATIVE	TO	ACCOMPANY	PLAT

THE PURPOSE OF THIS SURVEY IS TO MARK BOUNDARY LINES BETWEEN NATIONAL FOREST LAND AND PRIVATELY OWNED LAND IN AND ADJOINING SECTIONS 17, 18, 19, AND 20, T 10 S, R 33 E, W.M. THIS SURVEY WAS PERFORMED AT THE REQUEST OF U.S.D.A. FOREST SERVICE, MALHEUR NATIONAL FOREST UNDER CONTRACT NO. 53-04H1-7-4011, SUN CADASTRAL SURVEY.

HISTORY - THE WEST LINE AND SUBDIVISION OF THE TOWNSHIP WERE SURVEYED IN 1881 BY H. GRADON UNDER CONTRACT NO 383. SECTION 19 AND THE WEST HALF OF SECTION 20 WAS SURVEYED IN 1978 BY DOUGLAS FERGUSON (CS 529). THE SOUTH LINE OF SECTIONS 19 AND 20, AND THE EAST LINES OF SECTION 20 WAS SURVEYED IN 1978 AND 1980 BY FERGUSON FOR THE FOREST SERVICE (CS 624). CERTAIN OTHER CORNERS OF THESE SECTIONS HAVE BEEN REMONUMENTED FROM ORIGINAL EVIDENCE BY THE COUNTY SURVEYOR AND THE FOREST SERVICE.

SURVEY - BASIS OF BEARINGS IS A SOLAR OBSERVATION TAKEN AT THE NORTHWEST CORNER OF SECTION 19. CLOSED RANDOM TRAVERSES WERE RUN AROUND THE EXTERIORS OF THE SECTIONS AS REQUIRED FOR SUBDIVISION AND POSTING, TYING TO THE EXISTING CORNERS SHOWN. CLOSED LOOP RANDOM TRAVERSE WERE RUN THROUGH THE INTERIOR OF THE SECTIONS, GENERALLY ALONG THE PROPERTY BOUNDARY LINES, FOR POSTING AND INTERNAL MONUMENTATION PURPOSES.

SURVEY AND SUBDIVISION OF THE SECTION WAS CONDUCTED ACCORDING TO THE ORIGINAL GOVERNMENT NOTES AND PLAT, AND IN ACCORDANCE WITH THE PRINCIPLES OUTLINED IN THE MANUAL OF SURVEYING INSTRUCTIONS, 1973.

FENCELINES RUN ALONG THE GENERAL ALIGNMENT OF MANY OF THE BOUNDARY LINES. NO OTHER OBVIOUS TRESPASS WAS NOTED. NOTES FOR THIS SURVEY ARE CONTAINED IN FIELD BOOK 7 SUN CADASTRAL SURVEY. FIELD NOTES AND CALCULATION SHEETS OF THIS SURVEY ARE ON FILE IN THIS OFFICE, AND WITH THE SURVEY OFFICER, MALHEUR NATIONAL FOREST.

GENERAL NOTES - EQUIPMENT USED - TOPCON GTS-2. ALUMINUM MONUMENTS SET IN THIS SURVEY CONSIST OF AN ALUMINUM CAP WITH MAGNET, RIVETED TO A 2-1/2" ALUMINUM PIPE 30" LONG WITH A FLARED BASE. DIRECTIONS TO BEARING TREES ARE BASED ON A SOLAR OBSERVATION. ALL BEARING TREES MARKED IN THIS SURVEY HAVE A 3/4" BRASS WASHER MARKED "PLS 1918" ATTACHED TO THE BT BLAZE. MEASUREMENTS TO ALL BEARING TREES WERE MADE TO THE CENTER OF THE TREE, UNLESS NOTED. BEARING TREES HAVE BLAZES AND BANDS PAINTED RED AND APPROPRIATE FOREST SERVICE SIGNS ATTACHED. PONDEROSA PINE IS ABBREVIATED P.PINE. UNLESS OTHERWISE NOTED, PINE REFERS TO PONDEROSA OR YELLOW PINE. RECORD BEARING TREE INFORMATION IS DENOTED BY (). ALL CORNERS SET DURING THIS SURVEY HAVE A 6 FOOT STEEL GUARD POST DRIVEN APPROXIMATELY 3 TO 5 FEET AWAY WITH APPROPRIATE FOREST SERVICE SIGNS ATTACHED. BOUNDARY LINES ARE MARKED WITH STEEL FENCE POSTS WITH PROPERTY BOUNDARY SIGNS.

CORNER NOTES

J-1 FOUND A 2-1/2" BC ON IRON PIPE IN A MOUND OF STONE. A 14" P.PINE BEARS N36°31'E 25.0FT (N37°E 24.8FT) SCRIBED TI0SR33ES7BT.	T10S R32E R33E S121S7
A 17° P.PINE BEARS N55°42'W 77.0FT (N55°W 76.8FT) SCRIBED T10SR32ES12BT.	+
A 10" P.PINE BEARS S51°18'W 21.6FT (S53°W 21.6FT)	S131S18 1975
SCRIBED T10SR32ES13BT. A 10" P.PINE BEARS S17°25'E 10.6FT (S16°E 10.4FT)	PLS598

SCRIBED TIMSR33ESTBBT. FOUND A 3-1/4" ALUMINUM MONUMENT IN A MOUND OF STONE.
A 24" P.PINE STUMP BEARS N 30°10'E 65.4FT (N30°E 97 LKS)
SCRIBED 1/4SBT.
A 30" P.PINE STUMP BEARS S80°15'E 33.3FT (S80°E 50 LKS)
SCRIBED 1/4SBT.
AN 11" P.PINE BEARS N23°27'E 26.6FT (N23°E 27.0.FT) SCRIBED
1/4S7BT & WASHER PLS 1805
A 14" P.PINE BEARS S74°12'W 11.4FT (S77° 11.4FT) SCRIBED
1/4S18BT & WASHER PLS 1805. T10S R33E S7 1/4---S18 OPLS1805 1983

FOUND 16X9X6 STONE WITH 2 NOTCHES IN A MOUND OF STONE. SET A 2-1/2X30" ALUMINUM MONUMENT 22" IN THE GROUND IN A MOUND OF STONE AND BURIED THE ORIGINAL STONE ON NORTH SIDE. NEW BEARING TREES:
A 7" P.PINE BEARS S43°52'W 19.1FT SCRIBED T10SR33ES18BT.
A 9" P.PINE BEARS N68°49'W 74.4FT SCRIBED T10SR33ES7BT.
AN 11" P.PINE BEARS N47°30'E 26.7FT SCRIBED T10SR33ES8BT.
A 16" DOUBLE P.PINE BEARS S73°47'E 33.2FT SCRIBED T10SR33ES17BT. T10S R33E S71S8 S18|S17 PLS1918 1989

FOUND A 14X10X5 STONE IN A MOUND OF STONE. SET A 2-1/2X30" ALUMINUM MONUMENT 22" IN THE GROUND IN A MOUND OF STONE AND BURIED THE ORIGINAL STONE ON NORTH SIDE.

A 30" P.PINE STUMP BEARS N35°20'E 125.8FT (N35°E 186 LKS) SCRIBED 1/48BT. S17 PLS1918 1989 ROOTHOLE OF A WINDFALL PINE BEARS \$22°W 33FT (\$25°W 57 LKS) NO MARKS. NEW BEARING TREES:

A 10" P.PINE BEARS S1°30'E 25.4FT SCRIBED 1/4S17BT AN 8" P.PINE BEARS N26°34'E 10.6FT SCRIBED 1/4S8BT

J-9
FOUND A MOUND OF STONE AT APPROXIMATE POSITION, BUT NO RECORD OR MARKED STONE. REESTABLISHED CORNER AT MEAN POSITION FROM THREE REMAINING BTS. SET A 2-1/2X30" ALUMINUM MONUMENT 22" IN THE GROUND IN A MOUND OF STONE.
A 20" P.PINE STUMP BEARS N60°41'E 55.8FT TO FACE (N60°E 83 LKS) NO MARKS.
A 27" P.PINE STUMP BEARS S25°28'E 48.7FT TO FACE (S25°E 73 LKS) SCRIBED T108R33ES16BT.
A 15" P.PINE STUMP BEARS S5°44'W 19.3FT TO FACE (S5°W 31 LKS) NO MARKS.
NEW BEARING TREES:
A 10" P.PINE BEARS S46°35'W 8.4FT SCRIBED T108R33ES17BT.
A 16" P.PINE BEARS N55°03'E 35.7FT SCRIBED T108R33ES9BT.
A 10" P.PINE BEARS S53°18'E 20.8FT SCRIBED T108R33ES16BT.

SET A 2-1/2X30" ALUMINUM MONUMENT 22" IN THE GROUND.
NEW BEARING TREES:
AN 11" P.PINE BEARS N77°03'W 77.3FT SCRIBED N1/16S13BT.
A 13" P.PINE BEARS N42°20'E 54.8FT SCRIBED N1/16S18BT. T10S R32E R33E N1/16 S131S18 PLS1918 1989

T10S R33E NW1/16

\$18 PL\$1918 1989

T105_R33E

NI\19<u>i</u>218 C PLS1918 1989

K-2
SET A 2-1/2X30" ALUMINUM MONUMENT 20" IN THE GROUND IN A
MOUND OF STONE.
NEW BEARING TREES:
A 10" P.PINE BEARS N33°25'E 10.2FT SCRIBED NW1/16S18BT.
A 10" P.PINE BEARS S55°09'E 6.1FT SCRIBED NW1/16S18BT.

K-3
SET A 2-1/2X30" ALUMINUM MONUMENT 22" IN THE GROUND IN A MOUND OF STONE.
NEW BEARING TREES:
AN 8" P.PINE BEARS S68°06'W 27.0FT SCRIBED CN1/16S18BT.
A 10" P.PINE BEARS N7°38'W 12.2FT SCRIBED CN1/16S18BT.

<.5-4.5 SET A 2-1/2X30" ALUMINUM MONUMENT 14" IN THE GROUND IN A MOUNDERSTONE.	ID TIØS R33 SENEI/64
NEW BEARING TREES:	+
A 9" P.PINE BEARS N71°08'W 23.7FT SCRIBED SENE1/64S18BT. AN 11" P.PINE BEARS N30°44'E 12.2FT SCRIBED SENE1/64S18BT.	S18 PLS1918 1989
	1303

K.5-5
SET A 2-1/2X30" ALUMINUM MONUMENT 20" IN THE GROUND IN A MOUND
OF STONE.
NEW BEARING TREES: A 13" P.PINE BEARS N62°56'W 5.8FT SCRIBED SN1/64S18BT. AN 8" P.PINE BEARS N44°06'E 32.3FT SCRIBED SN1/64S17BT.

FOUND 16X11X4 STONE BROKEN IN 2 PIECES, MARKED 1/4, MONUMENT
HAS BEEN MOVED FROM THE ORIGINAL POSITION. I REESTABLISH THE
R32E R33E
CORNER AT RECORD DISTANCE AND DIRECTION FROM THE ORIGINAL BT.
SET A 2-1/2"X30" ALUMINUM MONUMENT 22" IN THE GROUND IN A MOUND
S131S18
OF STONE AND BURIED THE ORIGINAL STONE ON THE NORTH SIDE.
A 34" PINE STUMP BEARS S20°E 14.5FT (22 LKS) SCRIBED 1/4SBT.
1989
NEW BEARING TREES. NEW BEARING TREES: A 10" P.PINE BEARS S66°22'E 18.1FT SCRIBED 1/4S18BT AN 8" P.PINE BEARS S61°21'W 21.6FT SCRIBED 1/4S13BT

SET A 2-1/2X30" ALUMINUM MONUMENT 22" IN THE GROUND IN A MOUND OF STONE.

NEW BEARING TREES:
A 7" P.PINE BEARS S62°24'E 8.3FT SCRIBED C1/4S18BT.
A 10" P.PINE BEARS N47°37'E 12.7FT SCRIBED C1/4S18BT. S18 PLS1918 1989

T10S R33E EE1/64 C-----C

S18 PLS1918 1989


SET A 2-1/2X30" ALUMINUM MONUMENT 20" IN THE GROUND.
NEW BEARING TREES:
A 12" P.PINE BEARS S42°22'W 33.1FT SCRIBED CEE1/64S18BT.
A 13" P.PINE BEARS N36°17'W 82.7FT SCRIBED CEE1/64S18BT.

L-5
FOUND A 12X10X6 STONE MARKED 1/4 IN A MOUND OF STONE AND REBAR W/CAP OF UNKNOWN ORIGIN. SET A 2-1/2X30" ALUMINUM MONUMENT 24"
IN THE GROUND IN A MOUND OF STONE & BURIED THE ORIGINAL STONE ON THE NORTH SIDE.
A 28" P.PINE SNAG BEARS N39°59'E 20.9FT (N30°E 39 LKS) SCRIBED 1/4SBT.
A 22" P.PINE SNAG BEARS N85°09'W 62.2FT (N80°W 95 LKS) SCRIBED 1/4SBT.
NEW BEARING TREES:
A 10" P.PINE BEARS N 47°56'F 35 BET SCRIBED 1/4S17BT

A 10" P.PINE BEARS N 47°56'E 35.8FT SCRIBED 1/4S17BT A 10" P.PINE BEARS S 82°23'W 28.3FT SCRIBED 1/4S18BT

L-5.75
SET A 2-1/2X30" ALUMINUM MONUMENT 22" IN THE GROUND IN A MOUND TIØS R33E
OF STONE.
NEW BEARING TREES:
A 12" P.PINE BEARS S60°29'E 35.4FT SCRIBED CEWW1/256S17BT.
A 12" P.PINE BEARS N9°47'W 6.5FT SCRIBED CEWW1/256S17BT.
PLS1918
1989 PLŠ1918 1989

L-9
FOUND A 16X1ØX6 STONE, NO MARKS. SET A 2-1/2X3Ø" ALUMINUM
MONUMENT 2Ø" IN THE GROUND IN A MOUND OF STONE AND BURIED
THE ORIGINAL STONE ON THE NORTH SIDE.
A 15" P.PINE STUMP BEARS N26°57'W 61.ØFT (N3ذW 89 LKS).
ROOTHOLE OF WINDFALL P.PINE BEARS N27°3Ø'E 6Ø.ØFT (N3ذE 86 LKS)
SCRIBED 1/4SBT.
NEW BEARING TREES:
A 10" P.PINE BEARS N58°55'W 17 7ET SCRIBED 1/4S17BT T105 R33E 1/4 S171S16 PLS1918

A 10" P.PINE BEARS N58°55'W 17.7FT SCRIBED 1/4S17BT A 17" P.PINE BEARS N72°43'E 8.7FT SCRIBED 1/4S16BT.

L.5-4.5
CORNER FALLS IN A 26" P.PINE. SCRIBED NESEL/64S18 ON THE NORTHEAST AND SOUTHWEST SIDES. SET A 1-1/2" ALUMINUM CAP ON REBAR S47°36'W 9.31FT FROM TRUE CORNER POSITION, MARKED RP NESEL/64 PLS 1918.
NEW BEARING TREES:
A 10" P.PINE BEARS N83°01'W 28.6FT SCRIBED NESEL/64S18BT.
A 9" P.PINE BEARS S7°40'W 24.2FT SCRIBED NESEL/64S18BT.

L.5-5
A 2-1/2X30" ALUMINUM MONUMENT 20" IN THE GROUND IN A MOUND OF STONE.
NEW BEARING TREES:
A 6" P.PINE BEARS N7°59'E 28.8FT SCRIBED NS1/64S17BT.
A 7" P.PINE BEARS S65°59'W 22.2FT SCRIBED NS1/64S18BT. L-7
SET A 2-1/2X30" ALUMINUM MONUMENT 22" IN THE GROUND IN A MOUND T10S R33E
OF STONE.
NEW BEARING TREES:
AN 11" FIR BEARS N29°20'E 31.8FT SCRIBED C1/4S17BT.
A 16" FIR BEARS S25°05'W 43.2FT SCRIBED C1/4S17BT.
PLS1918
1989

S17 PLS1918 1989 M-1 SET A 2-1/2X30" ALUMINUM MONUMENT 22" IN THE GROUND. NEW BEARING TREES: A 12" P.PINE BEARS S86°52'E 35.8FT SCRIBED S1/16S18BT. AN 8" P.PINE BEARS S52°30'W 26.6FT SCRIBED S1/16S13BT. T10S R32E R33E S1/16 S131S18 PLS1918 1989


NEW BEARING TREES:

A 9" P.PINE BEARS S38°06'W 25.0FT SCRIBED CS1/16S18BT.

A 10" P.PINE BEARS S70°46'E 23.2FT SCRIBED CS1/16S18BT.

C PLS1918 1989 M-5
SET A 2-1/2X30" ALUMINUM MONUMENT 22" IN THE GROUND IN A MOUND OF STONE.
NEW BEARING TREES:
A 9" P.PINE BEARS S37°34'W, 12.4FT SCRIBED S1/16S18BT.
A 12" P.PINE BEARS S42°31'E 58.5FT SCRIBED S1/16S17BT. T105 R33E \$1/16 \$181\$17 PL\$1918 1989

M-5.75
SET A 2-1/2X30" ALUMINUM MONUMENT 20" IN THE GROUND IN A MOUND TIØS R33E OF STONE.
NEW BEARING TREES:
A 14" P.PINE BEARS SB0°12'E 25.3FT SCRIBED CEWSW1/256S17BT.
A 12" P.PINE BEARS S37°49'W 17.3FT SCRIBED CEWSW1/256S17BT.
PLS1918 1989

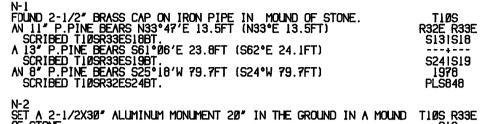

SET A 2-1/2X30" ALUMINUM MONUMENT 20" IN THE GROUND IN A MOUND TI0S R33E OF STONE.

A 1-1/2" ALUMINUM CAP ON REBAR BEARS N51°48'W 58.75FT MARKED W1/16--RM W1/16518 PLS1918

A 1-1/2" ALUMINUM CAP ON REBAR BEARS S62°53'W 44.0FT MARKED PLS1918
RM W1/16S19 PLS1918.

N-3
FOUND NO EVIDENCE OF THE ORIGINAL CORNER. REESTABLISH THIS
CORNER BY SINGLE PROPORTION. SET A 2-1/2X30" ALUMINUM MONUMENT
20" IN THE GROUND IN A MOUND OF STONE.
A 1-1/2" ALUMINUM CAP ON REBAR BEARS \$3°45'W 8.17FT MARKED
RM 1/4S19 PLS1918.
A 1-1/2" ALUMINUM CAP ON REBAR BEARS N3°45'E 8.09FT MARKED
RM 1/4S18 PLS1918. T10S R33E S18 1/4---S19 PLS1918 1989 T10S R33E S18|S17

S19 S20

PLS 1918 1989

T10S R33E N1/16 S191S20 PLS1916 1969

T10S_R33E

T10S R33E W1/16 C----C

S19 PLS1918 1989

T10S R33E C1/4

TIØS R33E Cl/4

1/4 5201521 1972 PLS598

N1\19Ĭ250 PLSĬ918

N-5
FOUND A 2-1/2" GRANT CO BC ON IRON PIPE IN A MOUND OF STONE.
A 43" P.PINE SNAG BEARS N31°41'W 116.3FT (N35°W 169 LKS)
SCRIBED TIØSR33ES18BT.
A 10" P.PINE BEARS S12°59'W 43.6FT (S14°W 43.0FT)
SCRIBED TIØSR33ES19BT.
A 21" P.PINE BEARS S61°52'E 36.6FT (S61°E 35.7FT)
SCRIBED TIØSR33ES20BT.
A 25" P.PINE BEARS N71°19'E 65.0FT (N75°E 64.4FT)
SCRIBED TIØSR33ES17BT.
A 16" P.PINE BEARS N42°45'W 73.4FT (N42°W 72.7FT)
SCRIBED TIØSR33ES18BT.

N-7
FOUND 18X8X6 STONE, POSSIBLE MARK 1/4. SET A 2-1/2X30"
ALUMINUM MONUMENT 22" IN THE GROUND IN A MOUND OF STONE AND
BURIED THE ORIGINAL STONE ON NORTH SIDE.
A 20" P.PINE STUMP, TOP TO WEST, BEARS NI1°25'E 43.8FT
(N10°E 63 LKS) SCRIBED 1/4SBT.
A 20" P.PINE STUMP BEARS S20°57'E 27.8FT (S20°E 49 LKS)
SCRIBED 1/4SBT.
NEW BEARING TREES:
A 9" P.PINE BEARS N9°05'W 42.7FT, SCRIBED 1/4S17BT.
AN 8" P.PINE BEARS S76°48'W 16.4FT SCRIBED 1/4S20BT. T10S R33E S17 1/4---S2Ø PLS1918 1989

SET A 2-1/2X30" ALUMINUM MONUMENT 20" IN THE GROUND IN A MOUND OF STONE.

NEW BEARING TREES

A 10" P.PINE BEARS N32°48'E 68.3FT SCRIBED N1/16S20BT.

A 14" P.PINE BEARS N84°39'W 64.1FT SCRIBED N1/16S19BT.

SET A 2-1/2X30" ALUMINUM MONUMENT 22" IN THE GROUND.
NEW BEARING TREES:
A 9" P.PINE BEARS N64°46'W 20.8FT SCRIBED CN1/16S20BT.
A 12" P.PINE BEARS S14°06'E 28.8FT SCRIBED CN1/16S20BT.

FOUND A 11X10X6" STONE MARKED 1/4 IN AN EAST/WEST FENCELINE.
SET A 2-1/2X30" ALLMINUM MONUMENT 20" IN THE GROUND IN A MOUND
OF STONE AND BURIED THE ORIGINAL STONE ON THE NORTH SIDE.
NEW BEARING TREES:
A 16" P.PINE BEARS S5°19'W 1008.00FT SCRIBED 1/4S24BT.
A 1-1/2" ALLMINUM CAP ON REBAR BEARS N78°07'E 33.62FT MARKED T105 R32E R33E

P-2
S-1 A 2-1/2X30" ALUMINUM MONUMENT 22" IN THE GROUND IN A MOUND OF STONE.
NEW BEARING TREES:
AN 11" P.PINE BEARS N24°05'W 6.7FT SCRIBED CW1/16S19BT.
A 7" P.PINE BEARS S37°08'W 13.6FT SCRIBED CW1/16S19BT.

SET A 2-1/2X30" ALUMINUM MONUMENT 22" IN THE GROUND IN A MOUND OF STONE.

NEW BEARING TREES:

A 14" P.PINE BEARS S84°51'W 34.8FT SCRIBED C1/4S19BT.

A 15" P.PINE BEARS S16°42'W 43.2FT SCRIBED C1/4S19BT.

FOUND NO EVIDENCE OF THE ORIGINAL CORNER. I REESTABLISH THIS CORNER BY SINGLE PROPORTION. SET A 2-1/2X30" ALUMINUM MONUMENT 20" IN THE GROUND IN A MOUND OF STONE.

NEW REFERENCES:
A 1/1-2" ALUMINUM CAP ON REBAR BEARS N33°59'W 38.20FT MARKED RM 1/4S19 PLS1918.
A 1-1/2" ALUMINUM CAP ON REBAR BEARS N54°33'E 25.29FT MARKED RM 1/4S20 PLS1918.

SET A 2-1/2X30" ALUMINUM MONUMENT 20" IN THE GROUND IN A MOUND OF STONE.
NEW BEARING TREES
A 21" P.PINE BEARS N42°28'W 41.6FT SCRIBED C1/4S20BT.
A 13" P.PINE BEARS N5°25'E 61.8FT SCRIBED C1/4S20BT.

FOUND A 2-1/2" BRASS CAP ON IRON PIPE IN A MOUND OF STONE.
A 38" P.PINE SNAG BEARS S36°25'W 39.3FT (S30°W 59 LKS)
SCRIBED S.
A 10" P.PINE BEARS N86°12'E 18.5FT (N87°E 18.4FT) HEALED BLAZE.
A 14" P.PINE BEARS N11°33'W 43.2FT (N12°W 43.2FT) HEALED BLAZE. T105 R33E

FOUND A 2-1/2" BRASS CAP ON IRON PIPE IN A MOUND OF STONE.
A 16" P.PINE BEARS S78°14'W 51.9FT (S86°W 52FT)
SCRIBED T10SR32ES25BT.
A 34" FIR BEARS S46°21'W 50.2FT (S52°W 50.6FT)
SCRIBED T10SR32ES25BT.

FOUND A 3-1/4" UNMARKED ALUMINUM MONUMENT IN A MOUND OF STONE. TIØS R33E I STAMPED THE MONUMENT AS SHOWN. S19
A 16" P.PINE BEARS Nذ2Ø'W 17.ØFT (Nذ3Ø'W 17.ØFT) PARTLY W1/16--HEALED BLAZE. S3Ø
AN 11" P.PINE BEARS S72°Ø3'E 31.3FT (S72°18'E 31.5FT) PARTLY
HEALED BLAZE

R-3
FOUND A 3-1/4" UNMARKED ALLMINUM MONUMENT IN A MOUND OF STONE. TIØS R33E
I STAMPED THE MONUMENT AS SHOWN. S19
AN 18" P.PINE BEARS S 60°07'E 29.0FT (S60°E 42 LKS) SCRIBED BT. 1/4--A 29" P.PINE BEARS N30°44'E 68.5FT (N30°E 103 LKS) S30
SCRIBED 1/4S.
A 14" P.PINE BEARS S24°48'E 66.4FT (S25°W 66.3FT) SCRIBING
VISIBLE.
A 14" P.PINE BEARS N68°45'W 47.9FT (N68°50'W 49.0FT) HEALED
BLAZE.

S301S29


R-5
FOUND A 3-1/4" ALUMINUM MONUMENT IN A MOUND OF STONE.
A 42" P.PINE SNAG BEARS N23°25'E 28.8FT (N33°E 42 LKS)
SCRIBED TIØSR33ES2ØBT.
A 21" P.PINE SNAG BEARS S36°45'W 34.2FT (S35°W 51 LKS)
SCRIBED S3ØBT
A 26" P.PINE BEARS N6ذ27'W 5FT (N6ذW 7 LKS) FACE VISIBLE
IN OPENED BLAZE.
A 9" P.PINE BEARS N71°29'E 13.5FT (N73°E 13.2FT) SCRIBING
VISIBLE. T10S R33E S191S20 VISIBLE.

AN 11" P.PINE BEARS S36°45'E 14.2FT (S35°E 14.2FT) SCRIBING VISIBLE.

A 13" FIR BEARS S52°57'W 24.8FT (S54°W 24.6FT) HEALED BLAZE.

A 12" FIR BEARS N37°54'W, 21.4FT(N35°W 21.6FT) HEALED BLAZE.

FOUND A 3-1/4" ALLMINUM MONUMENT IN A MOUND OF STONE.
A 36" P.PINE STUMP BEARS S23°16'E 22.2FT SCRIBED B.
A 7" P.PINE BEARS N41°36'E 12.4FT (N43°E 12.5FT) HEALED BLAZE.
A 9" FIR BEARS S42°W 3.6FT (S45°W 12.5FT) HEALED BLAZE.

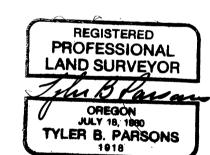

RECORD OF SURVEY for the U.S. FOREST SERVICE

Malheur National Forest Sec 17,18,19 & 20, TIØS, R33, WM. Grant County, OR Sun Cadastral Survey Cont. No. 53-04H1-7-4011 May 22, 1989 PARSONS SURVEYING 1915 S.E. Stone Street Corvallis, OR 97333 (503) 752-7515

Job No. 8722LA

received and FILED AUG 1 0 1989

SHEET 2 OF 2