

- Legend
- Found aluminum or brass cap.
 - Found corner. Set aluminum monument.
 - Set aluminum monument.
 - Record Information, GLO-1881.
 - Record Information, GLO-624.
 - Record Information.
 - Boundary line posted this contract.
 - Corner reference.

NOTE:
THIS SURVEY WAS PERFORMED IN CONNECTION WITH A SURVEY OF SECTIONS 17, 18, 19, 23, 24, 25, 26, 29, 30, 31, 35, 36. THE SURVEY WAS PERFORMED AT THE REQUEST OF THE U.S.D.A. FOREST SERVICE, MALHEUR NATIONAL FOREST UNDER CONTRACT NO. 53-04H1-7-4011, SUN CADASTRAL SURVEY.

NARRATIVE
THE PURPOSE OF THIS SURVEY IS TO MARK BOUNDARY LINES BETWEEN NATIONAL FOREST LAND AND PRIVATELY OWNED LAND IN ADJOINING SECTIONS 12, 13, 14, 18, 19, 23, 24, 25, 26, 29, 30, 31, 35, 36. THIS SURVEY WAS PERFORMED AT THE REQUEST OF U.S.D.A. FOREST SERVICE, MALHEUR NATIONAL FOREST UNDER CONTRACT NO. 53-04H1-7-4011, SUN CADASTRAL SURVEY.

HISTORY - THE SURVEY OF THE EAST LINE AND SUBDIVISION OF THE TOWNSHIP WERE ACCOMPLISHED IN 1881 BY H. GRADON UNDER CONTRACT NO. 385. THE WEST LINE OF SECTION 36 WAS SURVEYED IN 1889 BY DOUGLAS PERSSON (C5 624). CERTAIN OTHER CORNERS OF THESE SECTIONS HAVE BEEN REINDEMENTED FROM ORIGINAL EVIDENCE BY THE COUNTY SURVEYOR.

SURVEY BASIS OF BEARINGS IS A SOLAR OBSERVATION TAKEN AT THE NORTHWEST CORNER OF SECTION 18. CLOSED RANDOM TRAVERSES WERE RUN AROUND THE EXTERTORS OF THE SECTIONS AS REQUIRED FOR SUBDIVISION AND POSTING. CLOSED LOOP RANDOM TRAVERSE WERE RUN THROUGH THE INTERIOR OF THE SECTIONS, GENERALLY ALONG THE PROPERTY BOUNDARY LINES, FOR POSTING AND INTERNAL MONUMENTATION PURPOSES.

SURVEY AND SUBDIVISION OF THE SECTION WAS CONDUCTED ACCORDING TO THE ORIGINAL GOVERNMENT NOTES AND PLAN, AND IN ACCORDANCE WITH THE PRINCIPLES OUTLINED IN THE MANUAL OF SURVEYING INSTRUCTIONS, 1978.

FENCE LINES RUN ALONG THE GENERAL ALIGNMENT OF MANY OF THE BOUNDARY LINES. NO OTHER DEVICES OR MARKS WERE NOTED.

NOTES FOR THIS SURVEY ARE CONTAINED IN FIELD BOOK 7 SUN CADASTRAL SURVEY.
GENERAL NOTES - EQUIPMENT USED - TOPCON GTS-2, ALUMINUM MONUMENTS SET CONSIST OF AN ALUMINUM CAP WITH MONUMENT, RIVETED TO AN ALUMINUM PIPE WITH A FLARED BASE. DIRECTIONS TO BEARING TREES ARE BASED ON A SOLAR OBSERVATION. BEARING TREES MARKED IN THIS SURVEY HAVE A 3/4" BRASS WASHER MARKED "PLS 1981" ATTACHED TO THE BT BLAZE. MEASUREMENTS TO ALL BEARING TREES WERE MADE TO THE CENTER OF THE TREE EXCEPT AS NOTED. "UNLESS NOTED" PINE REFERS TO PONDEROSA OR YELLOW PINE. RECORD INFORMATION IS DENOTED BY ().

CORNER NOTES

J-21
FOUND A 2-1/2" BRASS CAP ON IRON PIPE IN A MOUND OF STONE.
A PINE STUMP BEARS S89°21'W 37.2 FT (S89°W 65 LKS) SCRIBED
A 12" PINE BEARS N61°45'W 47.4 FT (N68°W 70 LKS) SCRIBED S11 & CHAINING NOTCH.
A 12" PINE BEARS S63°13'E 38.8 FT (N62°W 37.5 FT) HEALED SCAR.
A 9" FIR BEARS S20°53'W 12.7 FT (S22°W) HEALED SCAR.
A 18" PINE BEARS N72°34'W 15.0 FT (N72°W) HEALED SCAR.
A 18" PINE BEARS N46°52'E 22.7 FT SCRIBED VISIBLE.

J-22
SET A 2-1/2"X38" ALUMINUM MONUMENT 22" IN THE GROUND IN A MOUND OF STONE.
A 12" PINE BEARS N52°21'W 65.1 FT SCRIBED W1/16S12BT.
A 11" PINE BEARS S83°18'E 65.8 FT SCRIBED W1/16S13BT.

J-23
FOUND NO EVIDENCE OF THE ORIGINAL CORNER. REESTABLISH THIS CORNER BY SINGLE PROPORTION. SET A 2-1/2"X38" ALUMINUM MONUMENT 18" IN THE GROUND IN A MOUND OF STONE.
NEW BTRS:
A 12" PINE BEARS S66°57'E 44.8 FT SCRIBED 1/4S12BT.
A 18" PINE BEARS N46°52'E 64.5 FT SCRIBED 1/4S12BT.

J-25
SET A 2-1/2" BC ON IRON PIPE IN A MOUND OF STONE.
A 14" PINE BEARS N56°31'E 25.8 FT (N57°E 24.8 FT) SCRIBED T10S R32E S12157.
A 12" PINE BEARS N55°42'W 77.8 FT (N55°W 76.8 FT) SCRIBED T10S R32E S12157.
A 18" PINE BEARS S51°18'W 21.6 FT (S53°W 21.6 FT) SCRIBED T10S R32E S12157.
A 18" PINE BEARS S17°25'E 18.6 FT (S16°E 18.4 FT) SCRIBED T10S R32E S12157.

K-21
SET A 2-1/2"X38" ALUMINUM MONUMENT 22" IN THE GROUND IN A MOUND OF STONE.
NEW BTRS:
A 9" PINE BEARS N14°48'W 9.4 FT SCRIBED N1/16S14BT.
A 9" PINE BEARS S23°49'E 26.3 FT SCRIBED N1/16S15BT.

K-22
SET A 2-1/2"X38" ALUMINUM MONUMENT 24" IN THE GROUND.
NEW BTRS:
A 12" PINE BEARS N64°23'E 16.5 FT SCRIBED N1/16S13BT.
A 13" PINE BEARS N34°48'W 52.5 FT SCRIBED N1/16S13BT.


K-25
SET A 2-1/2"X38" ALUMINUM MONUMENT 22" IN THE GROUND.
NEW BEARING TREES:
A 11" PINE BEARS N77°03'W 77.3 FT SCRIBED N1/16S13BT.
A 13" PINE BEARS N42°28'E 54.6 FT SCRIBED N1/16S13BT.

L-21
SET A 2-1/2" ALUMINUM MONUMENT 22" IN THE GROUND.
NEW BTRS:
A 18" PINE BEARS S24°11'E 21.6 FT SCRIBED 1/4S13BT.
A 13" PINE BEARS S72°28'W 62.4 FT SCRIBED 1/4S13BT.

L-23
SET A 2-1/2" ALUMINUM MONUMENT 22" IN THE GROUND.
NEW BTRS:
A 12" PINE BEARS S18°25'E 9.3 FT SCRIBED C1/4S13BT.
A 17" PINE BEARS N41°39'E 6.8 FT SCRIBED C1/4S13BT.

L-25
FOUND 16X11X4 STONE BROKEN IN 2 PIECES, MARKED 1/4. MONUMENT HAS BEEN MOVED FROM THE ORIGINAL POSITION. REESTABLISH THE CORNER AT RECORD DISTANCE AND DIRECTION FROM THE ORIGINAL BT. SET A 2-1/2"X38" ALUMINUM MONUMENT 22" IN THE GROUND IN A MOUND OF STONE AND BURIED THE ORIGINAL STONE ON THE NORTH SIDE.
A 34" PINE STUMP BEARS S20°E 14.9 FT (S22 LKS) SCRIBED 1/4S13BT.
NEW BEARING TREES:
A 12" PINE BEARS S66°22'E 18.1 FT SCRIBED 1/4S13BT.
A 8" PINE BEARS S61°21'W 21.6 FT SCRIBED 1/4S13BT.

Scale: 1 in. = 800 ft.

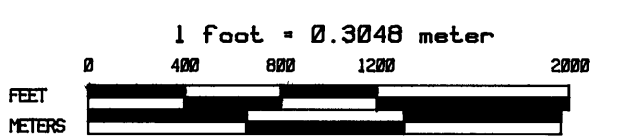

M-25
FOUND A 2-1/2"X38" ALUMINUM MONUMENT 22" IN THE GROUND.
NEW BEARING TREES:
A 12" PINE BEARS S85°52'E 35.8 FT SCRIBED S1/16S18BT.
A 8" PINE BEARS S52°38'W 28.6 FT SCRIBED S1/16S18BT.

N-21
FOUND NO EVIDENCE OF THE ORIGINAL POST. REESTABLISH THIS CORNER FROM THE FOUR FOUND ORIGINAL BEARING TREES. SET A 2-1/2" ALUMINUM MONUMENT 22" IN THE GROUND IN A MOUND OF STONE.
A BURNED PINE STUMP BEARS S77°28'W 31.8 FT TO FACE (S75°W 47 LKS) FACE A CHAINING NOTCH VISIBLE.
A BURNED PINE STUMP BEARS N74°05'E 21.8 FT TO FACE (N64°W 32 LKS) FACE A CHAINING NOTCH VISIBLE.
A PINE STUMP BEARS N37°14'E 36.9 FT (N35°E 150 LKS).
A 10" PINE BEARS S42°41'E 72.9 FT (S40°E 118 LKS) HEALED SCAR.
NEW BTRS:
A 12" PINE BEARS S55°24'W 13.9 FT SCRIBED T10S R32E S231524.
A 8" PINE BEARS N45°07'W 42.4 FT SCRIBED T10S R32E S231524.
A 13" PINE BEARS N46°30'E 28.3 FT SCRIBED T10S R32E S231524.
A 9" PINE BEARS S88°50'E 22.7 FT SCRIBED T10S R32E S231524.

N-23
FOUND A 2-1/2" BRASS CAP ON IRON PIPE IN A MOUND OF STONE.
A 48" PINE BEARS S15°52'W 88.9 FT (S15°W 128 LKS) BURNED FACE.
A 18" PINE BEARS N48°16'E 159.9 FT (N48°E 145.7 FT) 1/4S13BT.

N-25
FOUND A 2-1/2" BRASS CAP ON IRON PIPE IN A MOUND OF STONE.
A 11" PINE BEARS N33°47'E 13.8 FT (N33°E 13.5 FT) SCRIBED T10S R32E S231524.
A 13" PINE BEARS S81°06'E 23.8 FT (S82°E 24.1 FT) SCRIBED T10S R32E S231524.
A 8" PINE BEARS S25°18'W 79.7 FT (S24°W 79.7 FT) SCRIBED T10S R32E S231524.

P-21
FOUND A 12X8X6 UNMARKED STONE IN A MOUND OF STONE. SET A 2-1/2"X38" ALUMINUM MONUMENT 18" IN THE GROUND IN A MOUND OF STONE & BURIED THE ORIGINAL STONE ON THE NORTH SIDE.
ROOTHOLE OF A DOUBLE PINE BEARS N64°44'W 41.6 FT (N68°W 58 LKS) CHAINING NOTCH.
ROOTHOLE OF A PINE BEARS S52°28'E 36.6 FT (S57°E 55 LKS) BLAZE & CHAINING NOTCH.
NEW BTRS:
A 12" PINE BEARS N77°27'W 21.3 FT SCRIBED 1/4S23BT.
A 8" PINE BEARS S33°17'E 15.1 FT SCRIBED 1/4S24BT.

P-23
SET A 2-1/2"X38" ALUMINUM MONUMENT 18" IN THE GROUND.
NEW BTRS:
A 12" PINE BEARS N89°32'W 31.1 FT SCRIBED C1/4S24BT.
A 9" PINE BEARS S47°32'W 17.9 FT SCRIBED C1/4S24BT.

P-25
FOUND A 11X18X6 STONE MARKED 1/4 IN AN EAST/WEST FENCE LINE. SET A 2-1/2"X38" ALUMINUM MONUMENT 18" IN THE GROUND IN A MOUND OF STONE AND BURIED THE ORIGINAL STONE ON THE NORTH SIDE.
NEW BEARING TREES:
A 18" PINE BEARS S51°19'W 108.8 FT SCRIBED 1/4S24BT.
A 1-1/2" ALUMINUM CAP ON REBAR BEARS N70°07'E 33.52 FT MARKED RH 1/4S1918.
NEW BTRS:
A 12" PINE BEARS S81°06'E 65.8 FT SCRIBED C1/4S24BT.
A 9" PINE BEARS N89°55'E 181.8 FT SCRIBED C1/4S24BT.

P-27
SET A 2-1/2"X38" ALUMINUM MONUMENT 18" ABOVE IN A MOUND OF STONE.
NEW BTRS:
A 12" PINE BEARS S81°06'E 65.8 FT SCRIBED C1/4S24BT.
A 9" PINE BEARS N89°55'E 181.8 FT SCRIBED C1/4S24BT.

R-21
FOUND A 12X8X6 STONE, 2 GROOVES & 1 GROOVE ON APPROPRIATE FACES. N64°W 37 FEET FROM THE CORNER POSITION DETERMINED FROM A ORIGINAL BEARING TREES. REESTABLISH THIS CORNER FROM THE ORIGINAL BTRS. SET A 2-1/2"X38" ALUMINUM MONUMENT 22" IN THE GROUND IN A MOUND OF STONE & BURIED THE ORIGINAL STONE ON THE NORTH SIDE.
A 14" PINE STUMP BEARS N68°E 18.1 FT (N65°E 27 LKS), NO MARKS REMAINING.
A 12" PINE STUMP BEARS S75°28'E 82.6 FT (S78°E 124 LKS), S25BT & CHAINING NOTCH VISIBLE ON DETACHED FRAGMENT.
A 36" PINE STUMP BEARS S47°34'W 54.8 FT (S49°W 81 LKS), NO MARKS REMAINING.
A 18" PINE STUMP BEARS N52°15'W 48.4 FT (N55°W 72 LKS), POSSIBLE CHAINING NOTCH.
NEW BTRS:
A 12" PINE BEARS N51°15'W 23.8 FT SCRIBED T10S R32E S231524.
A 9" PINE BEARS N48°E 37.7 FT SCRIBED T10S R32E S231524.
A 13" PINE BEARS S20°E 45.1 FT SCRIBED T10S R32E S231524.
A 12" PINE BEARS S44°59'W 17.3 FT SCRIBED T10S R32E S231524.

R-23
FOUND NO EVIDENCE OF THE ORIGINAL CORNER. REESTABLISH THIS CORNER BY SINGLE PROPORTION. SET A 2-1/2"X38" ALUMINUM MONUMENT 22" IN THE GROUND.
NEW BTRS:
A 12" PINE BEARS S14°58'W 17.8 FT SCRIBED 1/4S25BT.
A 9" PINE BEARS N21°12'E 39.8 FT SCRIBED 1/4S24BT.

R-24
SET A 2-1/2"X38" ALUMINUM MONUMENT 28" IN THE GROUND IN A MOUND OF STONE.
NEW BTRS:
A 12" PINE BEARS N3°22'W 12.8 FT SCRIBED E1/16S24BT.
A 18" PINE BEARS S12°14'E 34.6 FT SCRIBED E1/16S25BT.

R-25
FOUND A 2-1/2" BRASS CAP ON IRON PIPE IN A MOUND OF STONE.
A 18" PINE BEARS S70°14'W 51.9 FT (S68°W 52 FT) SCRIBED T10S R32E S241519.
A 34" PINE BEARS S20°E 14.9 FT (S22 LKS) SCRIBED T10S R32E S241519.
A 8" PINE BEARS S61°22'E 18.1 FT SCRIBED 1/4S13BT.

T10S R32E S241519 1989

T10S R32E S241519 1989

Surveyor's Certificate

I, TYLER B. PARSONS, a Registered Land Surveyor in the State of Oregon, do hereby certify that this plat and the notes hereon or attached, are a correct representation of a survey I performed at the request of the U.S.D.A. Forest Service during the period May 28, 1989 to June 9, 1989 in accordance with the statutes of the State of Oregon and the articles of my contract.

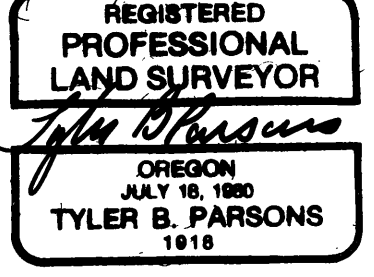

RECORD OF SURVEY for the U.S. FOREST SERVICE

Malheur National Forest
Sec 13, 24, & 25, T10S, R32E, W.M.
Grant County, OR
Sun Cadastal Survey
Cont. No. 53-04H1-7-4011
June 10, 1989
PARSONS SURVEYING
1915 S.E. Stone Street
Corvallis, OR 97333
(503) 752-7515
Job No. 8722LB

RECEIVED AND FILED

AUG 10 1989

