

RECORD OF SURVEY

for

LAVELLE HOLMES

Section 20, T 10 S, R 33 E, W.M.
Grant County, Oregon

May 23, 1989


Scale: 1" = 100'

The purpose of this survey is to mark a portion of the East line of the West half of Section 20, as defined by the Public Land Survey System. This portion of the line is a boundary line between contiguous private owners. The client requested that two points be established to show the alignment of the property line from the County Road to the Middle Fork of the John Day River.

Basis of Bearings is a solar observation taken at the northwest corner of Section 19. This survey is in conjunction with a survey for the Malheur National Forest, which is in progress. The center quarter section corner shown was established as a part of the survey for the National Forest on May 17, 1989. The quarter section corner to Sections 20 & 29 was remonumented from original evidence as a part of County Survey #624.

Monuments to mark this line were established approximately 70 feet north of County Road 20, and approximately 50 feet north of the Middle Fork of the John Day River.

Reference: CS 1094.

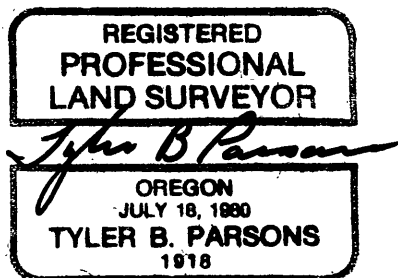

PARSONS SURVEYING
1915 S.E. Stone Street
Corvallis, OR 97333
(503) 752-7515

Project No. 8911

RECEIVED AND
FILED

AUG 10 1989

OFFICE OF COUNTY SURVEYOR
Robert P. [Signature]
ANNE

