


Chiseled cross on N. edge of concrete sidewalk in line with the E. building line of the O.K. Garage.


See note

O.K. GARAGE

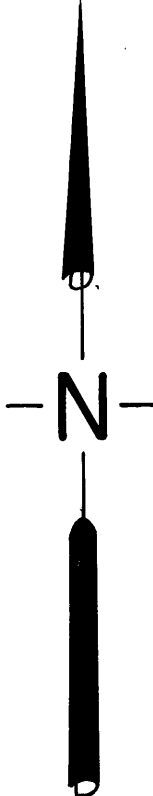

BASIS OF BEARINGS

Record bearing for N. side of Main Street, using line between (A) & (B).

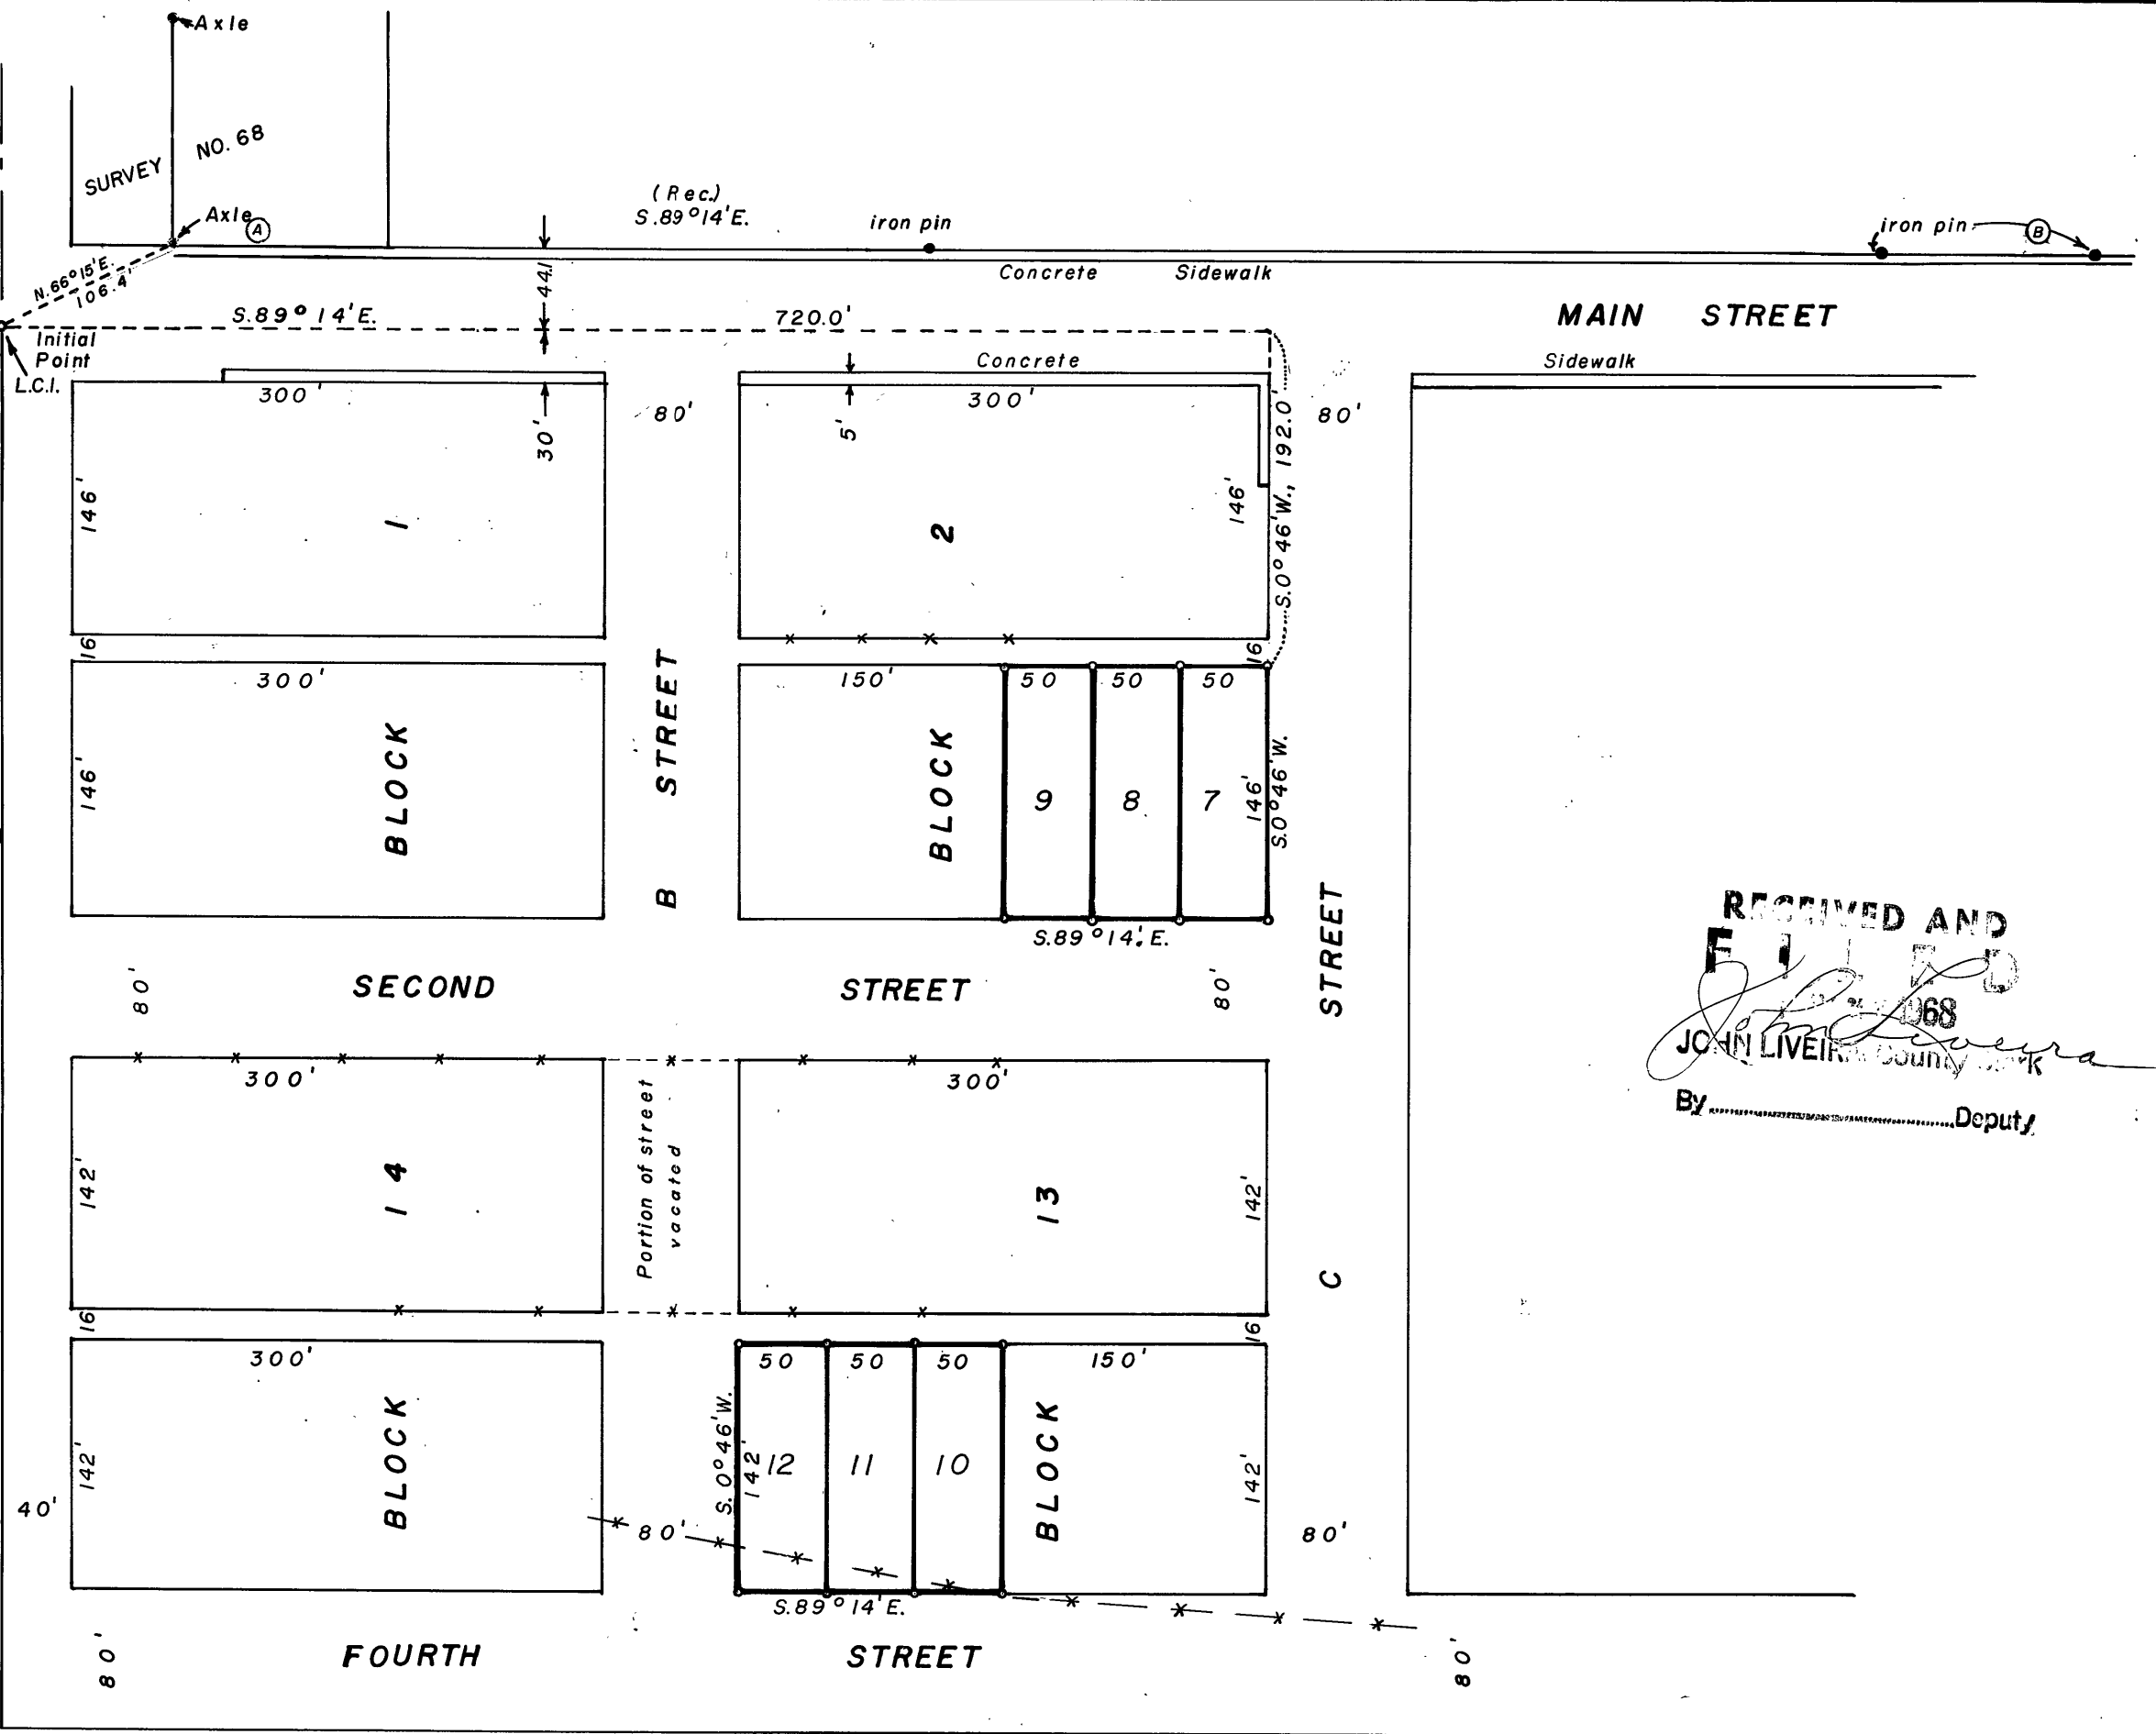

RECEIVED AND
FILED
JUL 12 1968
JOHN LIVEITH COUNTY CLERK
By _____ Deputy

REGISTERED
OREGON
LAND SURVEYOR
Robert D. Bagett
JULY 12, 1963
ROBERT D. BAGETT
598

LEGEND
• Monuments found.
○ Monuments set. (1/2" X 2.4" iron pipe)
-- Fence.

NOTE:
Set 1 1/8" x 30" iron pin, marked
L.C.I. I.P. on top, L.S. 598 on side.
See field notes of this survey.

BAGETT & GRIFFITH SURVEYING John Day, Oregon Map of Survey		
LOTS 7, 8, 9, BLK. 2 & LOTS 10, 11, 12, BLK. 13 L.C.I. ADDITION LONG CREEK, OREGON		
SURVEYED FOR	MAUDE JOHNSON	
SURVEYED BY	R.D.B. & D.I.G.	5/68
Scale: 1" = 100'	Drawn by R.D.B.	5/68

Survey Map # 110

Survey # 110