


OREGON
JULY 12, 1963
ROBERT D. BAGETT
598

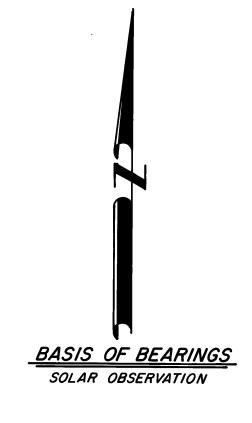

REFERENCES

Plat of Cleaver & Cozarts Add.

Record Map of Survey No.'s 333,359,491

Deed Record Book 137 Page 536

NARRATIVE: This survey was performed at the request of Dave Morris. The purpose of this survey was to locate and monument the NW & NE corners of the S½ of lot 12 and the south line of lot 11, of block 6, Cleaver & Cozarts Addition to Prairie City.

A search was made of the available records pertaining to this survey. Field measurements were made to locate existing monuments. New monuments were set in accordance with the evidence found as shown hereon.

<u>LEGEND</u>

- Found %" iron pin of record
- O Set %"x30" iron pin with attached yellow plastic cap marked BGA SURVEY MARKER.
-) Record bearing and distance
- x-x Fence line

BAGETT, GRIFFITH & ASSOCIATES

John Day, Oregon

MAP OF SURVEY
OF LOT II & THE S% OF LOT 12 BLOCK 6 IN
CLEAVER & COZARTS ADD. TO PRAIRIE CITY

GRANT COUNTY, OREGON

SURVEYED FOR DAVE MORRIS

SURVEYED BY R.D.B. & J.L.W. 8/15/89

Scale: 1"= 100' Drawn by: J.L.W.

8/18/89