


BASIS OF BEARINGS:

WEST LINE NW 1/4 PER
ROS MYERS 8 SEPT 86
MAGNETIC DECL. 20 E.

NATIONAL FOREST LANDS

SEC. 10 EXC. E1/2, SE1/4; SEC. 12 EXC. SW1/4, NE1/4;
SEC. 1 EXC. SW1/4, SW1/4; ALL IN T.12S, R.34E., W.

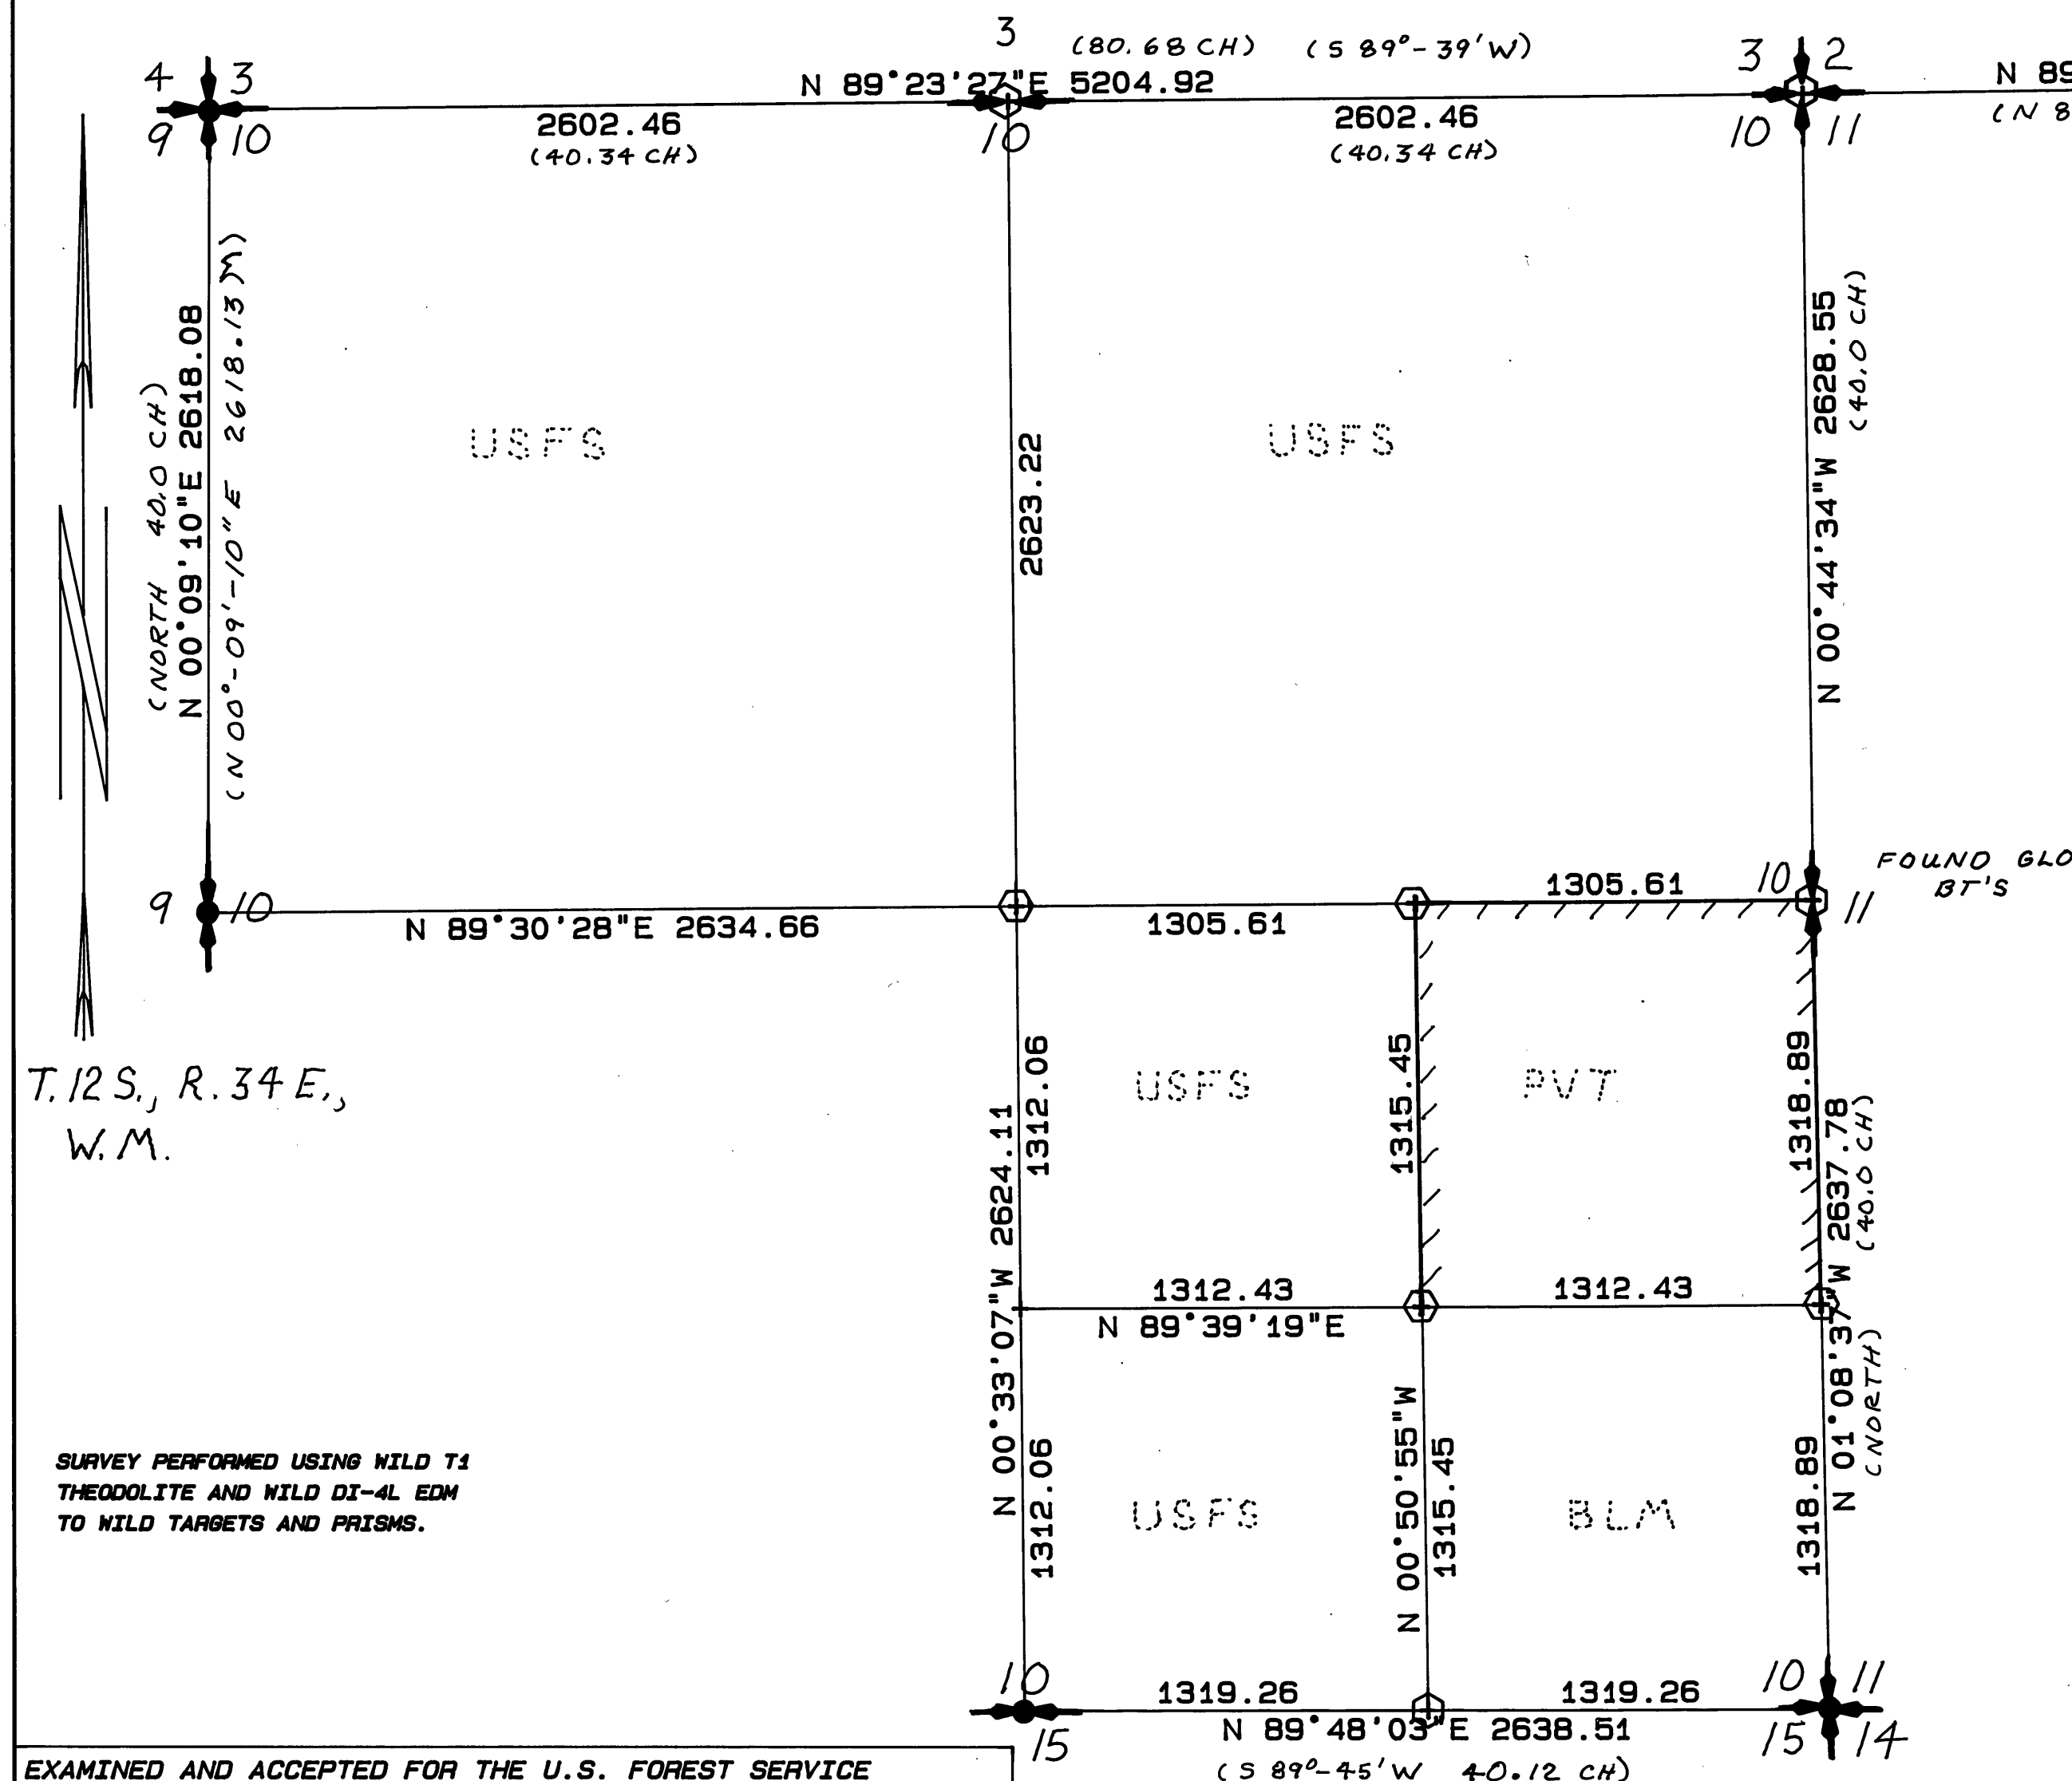

HISTORY OF SURVEYS

TOWNSHIP LINES AND INTERIORS ESTABLISHED BY
H. D. GRADON AND B. ROBB UNDER GLO CONTRACT
NUMBER 383 DATED MARCH 26, 1881
WEST LINE SEC. 10 RESURVEYED BY
LELAND L. MYERS PER USFS CONTRACT 53-04H1-4-9667M
DATED SEPT. 8, 1986.
NORTH LINE NW1/4 SEC. 12 RESURVEYED BY
HOWARD L. PERRY PER USFS CONTRACT 53-04H1-1-8294M
DATED JULY 26, 1982

LEGEND

- FOUND MONUMENT OF RECORD
- SET 2.5 INCH DIA. BY 30 INCH ALUM. MON.
- ||||| PROPERTY LINE ESTABLISHED AND POSTED
- () SURVEY DATA OF RECORD

COUNTY SURVEYOR'S OFFICE

FILED FOR RECORD THIS 1st DAY OF DEC. 1989.
AS SURVEY NUMBER 1103
RECORDS OF GRANT COUNTY, STATE OF OREGON.

DEPUTY SURVEYOR

COUNTY SURVEYOR

SURVEYOR'S CERTIFICATE

I, EDWIN A. STRYKER, REGISTERED LAND SURVEYOR IN THE
STATE OF OREGON, HEREBY CERTIFY THAT THIS PLAT AND THE
NOTES HEREON, OR ATTACHED, ARE A TRUE AND CORRECT
REPRESENTATION OF THE SURVEY I MADE IN MAY-JULY 1989,
AT THE REQUEST OF THE USDA FOREST SERVICE IN ACCORDANCE
WITH THE STATUTES OF THE STATE OF OREGON AND THE
ARTICLES OF MY CONTRACT NUMBER 53-04KK-8-02420.

REGISTERED
PROFESSIONAL
LAND SURVEYOR

Edwin A. Stryker
OREGON
JULY 15, 1983
EDWIN A. STRYKER
2060

STRYKER-KIMBELL ASSOCIATES

RT 1 BOX 316 LEWIS CREEK ROAD
SUMMERVILLE, ORE 97876
(503) 534-6905

DRAWN HP7575A	JOB NO 0488101234	DATED 8-14-89
CHECKED BY EAS	SCALE 1 in. = 500	SHEET 1 OF 4