


BASIS OF BEARINGS
WEST LINE NW 1/4 SEC 12
PER ROS MYERS FILED 8 SEPT. 1986


T. 12 S., R. 34 E.,
W.M.

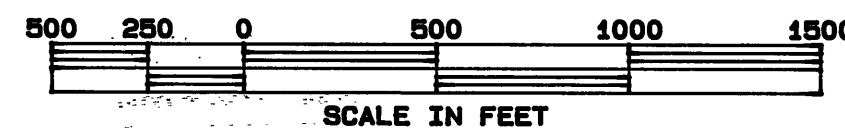

RECEIVED AND
FILED

DEC 1 1989

OFFICE OF COUNTY SURVEYOR
Attest: *[Signature]*

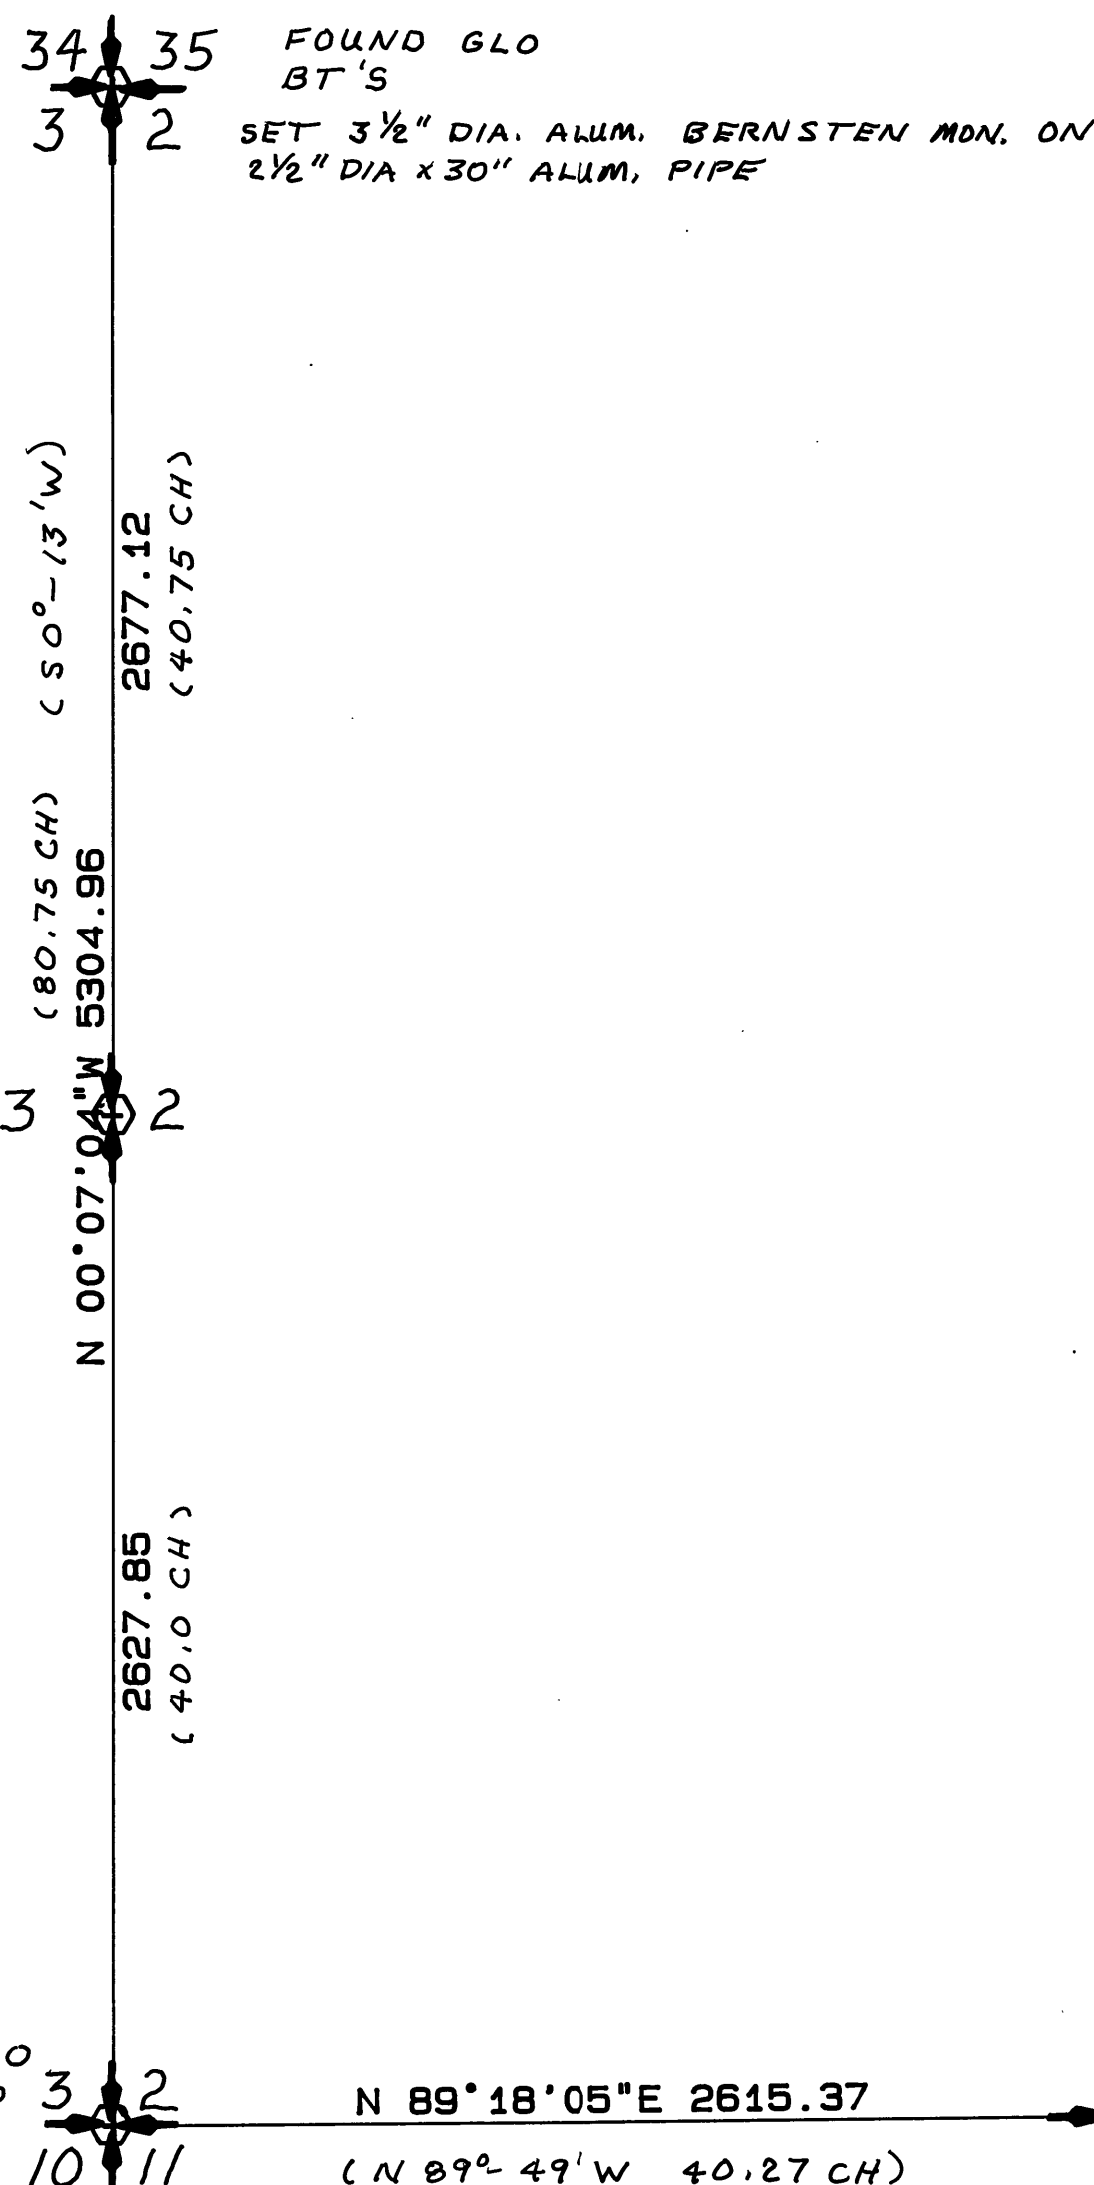

LEGEND

- FOUND MONUMENT OF RECORD
- SET 2.5 BY 30 INCH ALUM. MONUMENT
- ||||| PROPERTY LINE ESTABLISHED AND POSTED
- () SURVEY DATA OF RECORD

DIXIE CADASTRAL SURVEY

CONTRACT NO.: 53-04KK-8-02420

CERTIFIED LAND CORNER RECORDATION FORMS FOR ALL
LAND CORNERS FOUND OR SET HAVE BEEN FILED WITH
THE GRANT COUNTY SURVEYOR'S OFFICE.

REGISTERED
PROFESSIONAL
LAND SURVEYOR

Edwin A. Stryker
OREGON
JULY 15, 1983
EDWIN A. STRYKER
2060

STRYKER-KIMBELL ASSOCIATES

RT 1 BOX 316 LEWIS CREEK ROAD
SUMMERVILLE, ORE 97876
(503) 534-6905

DRAWN HP7575A	JOB NO 0488101234	DATED 8-14-89
CHECKED BY EAS	SCALE 1 in. = 500	SHEET 2 OF 4