
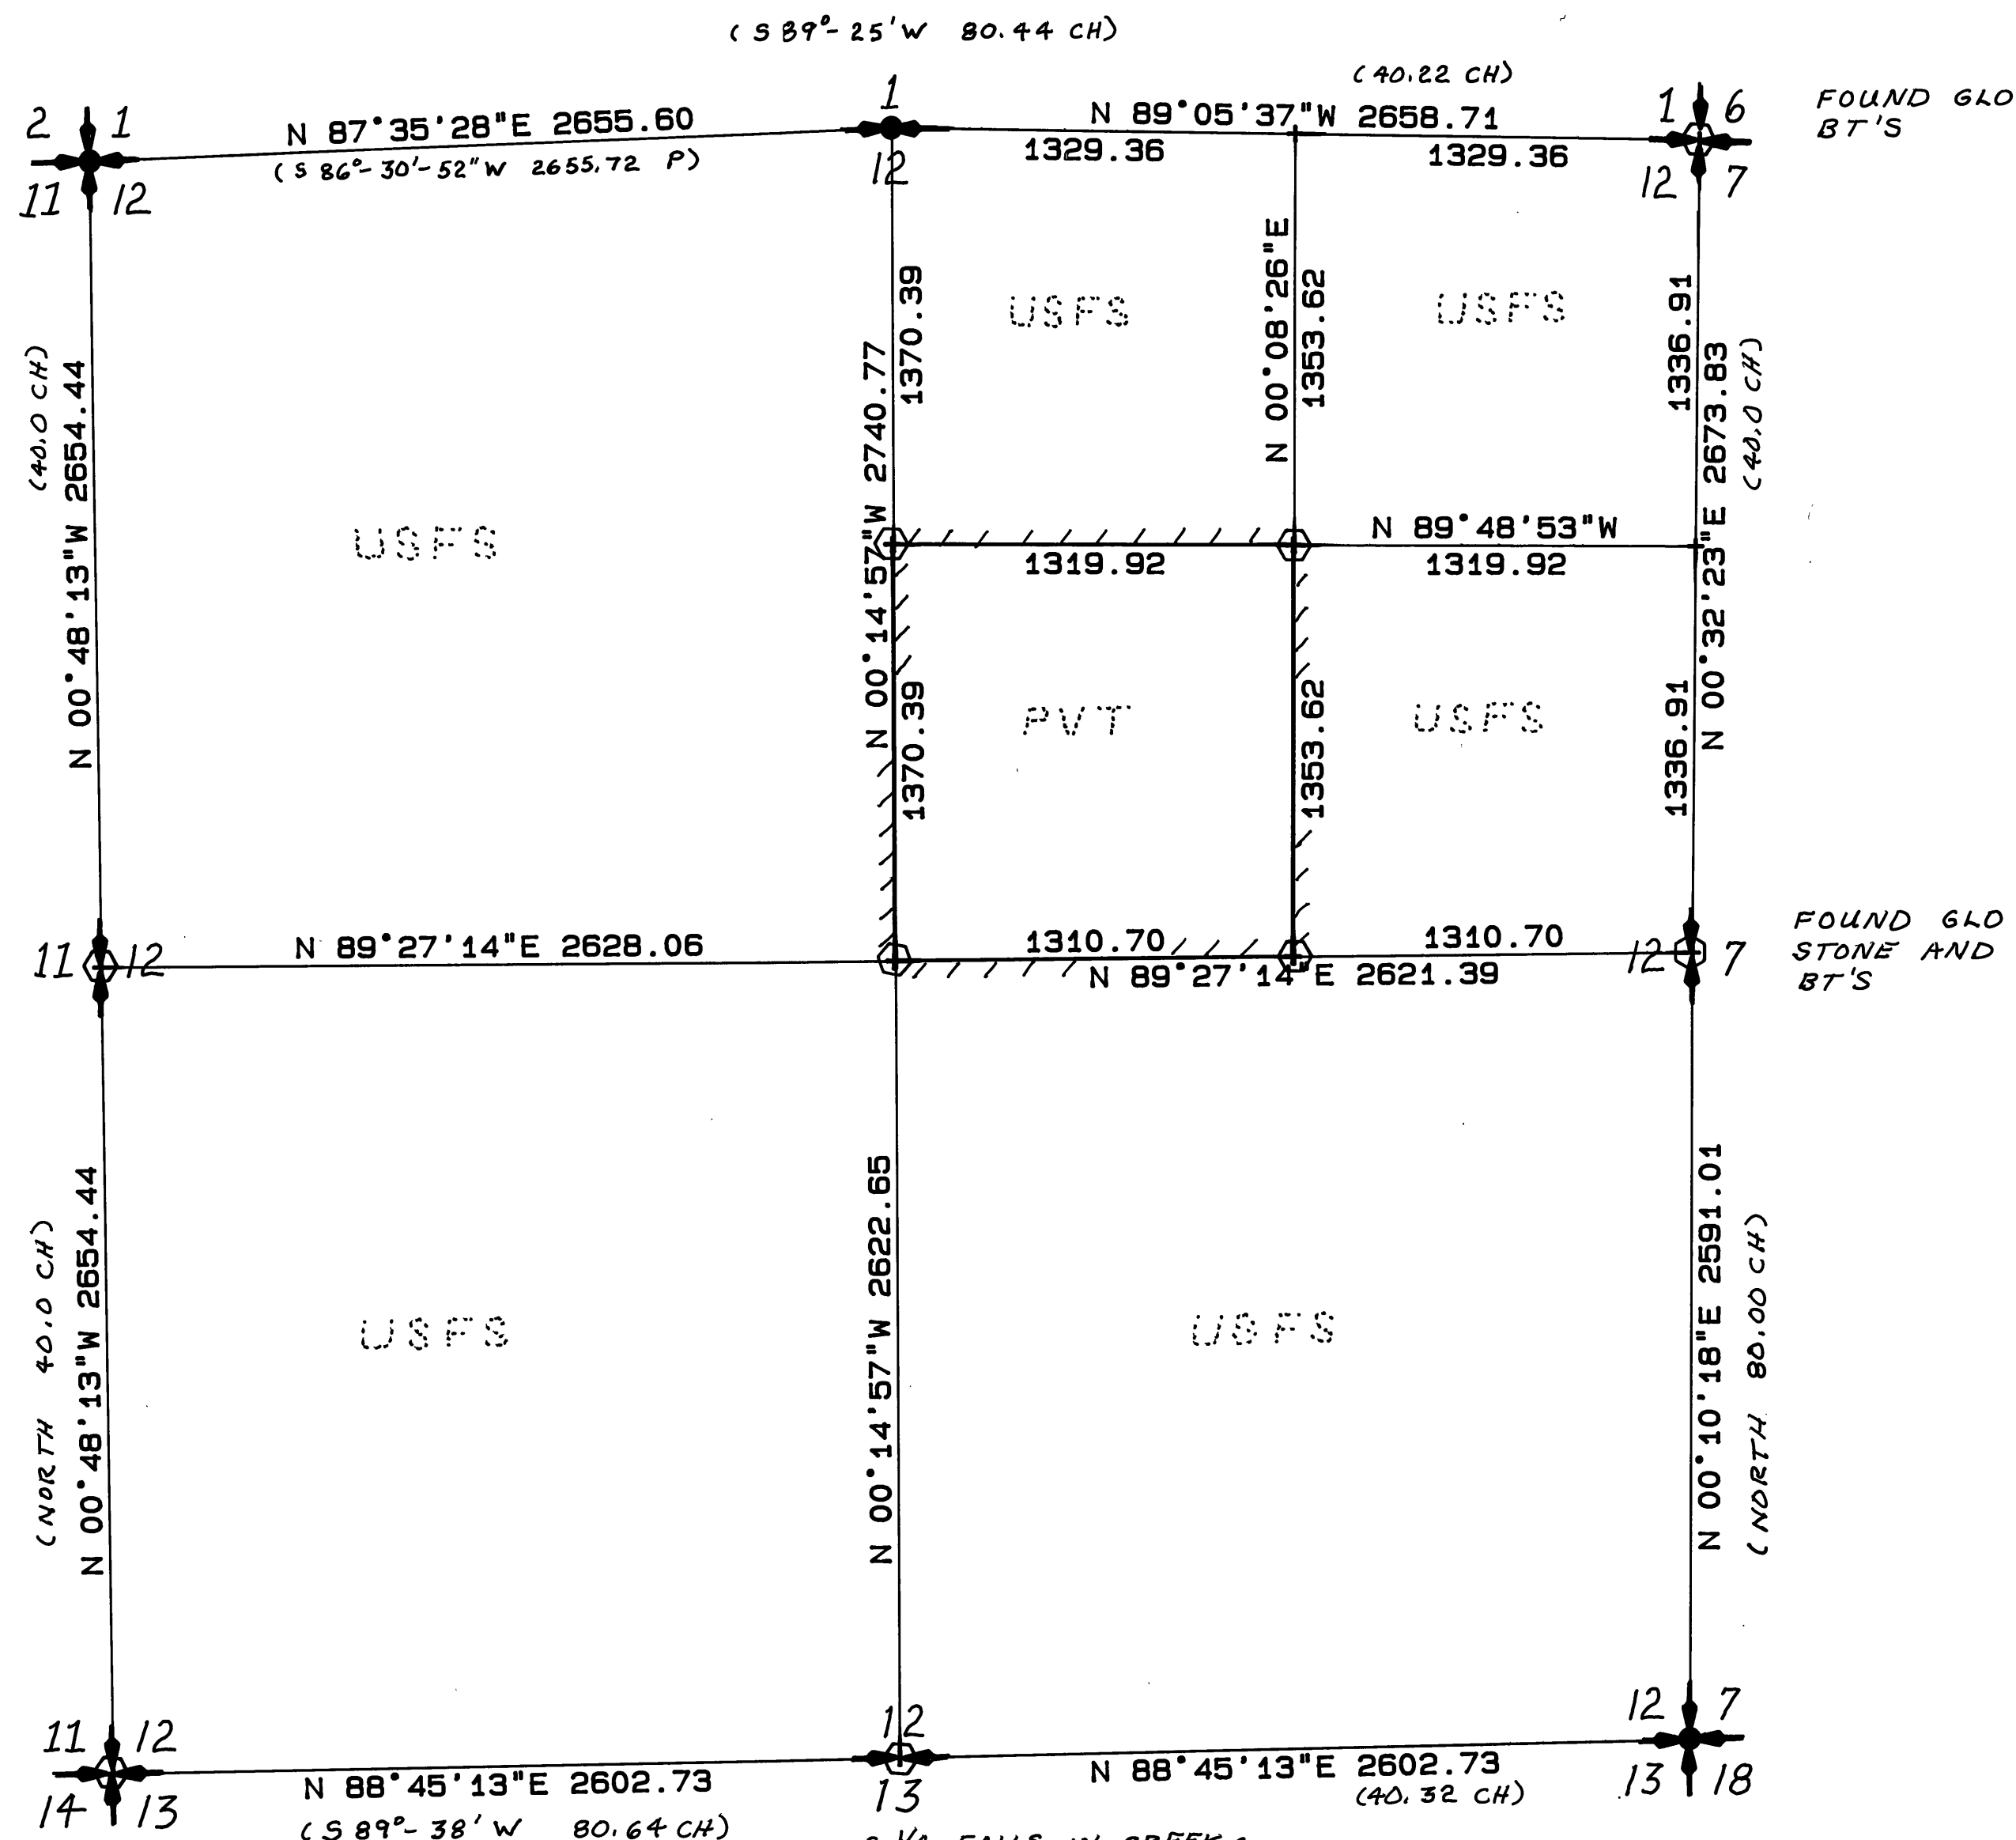



BASIS OF BEARINGS
SOLAR OBSERVATION NEAR
SOUTHWEST SEC. CORNER SEC 1

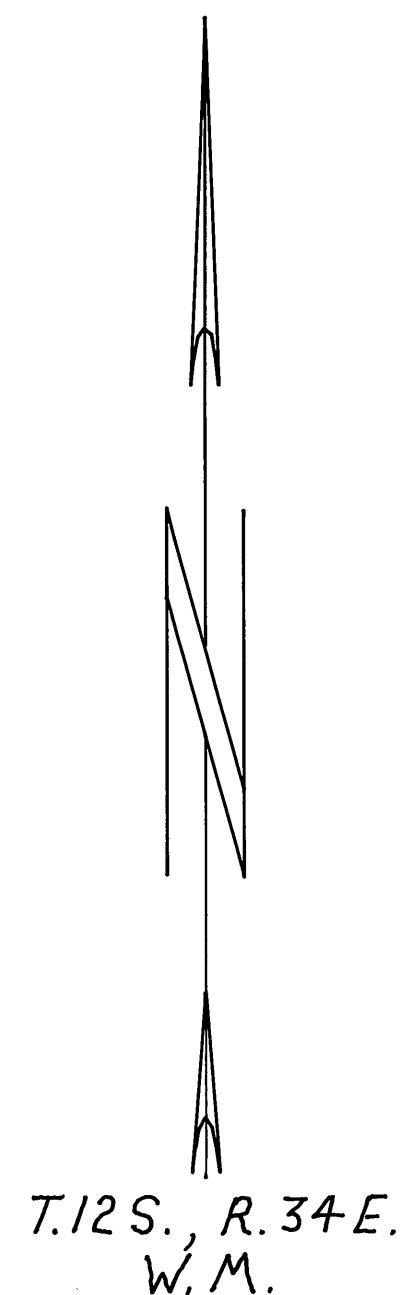

RECEIVED AND
FILED

DEC 1 1989

OFFICE OF COUNTY SURVEYOR
Attest: *[Signature]*

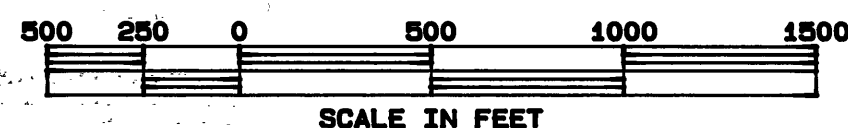

SCALE IN FEET


LEGEND

- FOUND MONUMENT OF RECORD
- SET 2.5 BY 30 INCH ALUM. MONUMENT
- ||||| PROPERTY LINE ESTABLISHED AND POSTED
- () SURVEY DATA OF RECORD

DIXIE CADASTRAL SURVEY

CONTRACT NO.: 53-04KK-8-02420

CERTIFIED LAND CORNER RECORDATION FORMS FOR ALL
LAND CORNERS FOUND OR SET HAVE BEEN FILED WITH
THE GRANT COUNTY SURVEYOR'S OFFICE.

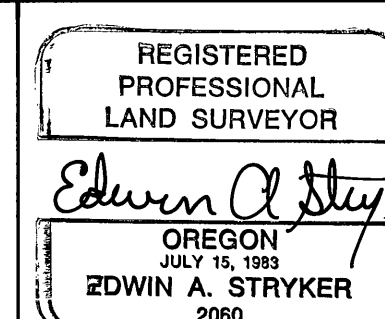

STRYKER-KIMBELL ASSOCIATES

RT 1 BOX 316 LEWIS CREEK ROAD
SUMMERVILLE, ORE 97876
(503) 534-6905

DRAWN HP7575A	JOB NO 0488101234	DATED 8-14-89
CHECKED BY EAS	SCALE 1 in. = 500	SHEET 3 OF 4