


RECEIVED AND
FILED

DEC 1 1989

OFFICE OF COUNTY SURVEYOR
Attest: *[Signature]*

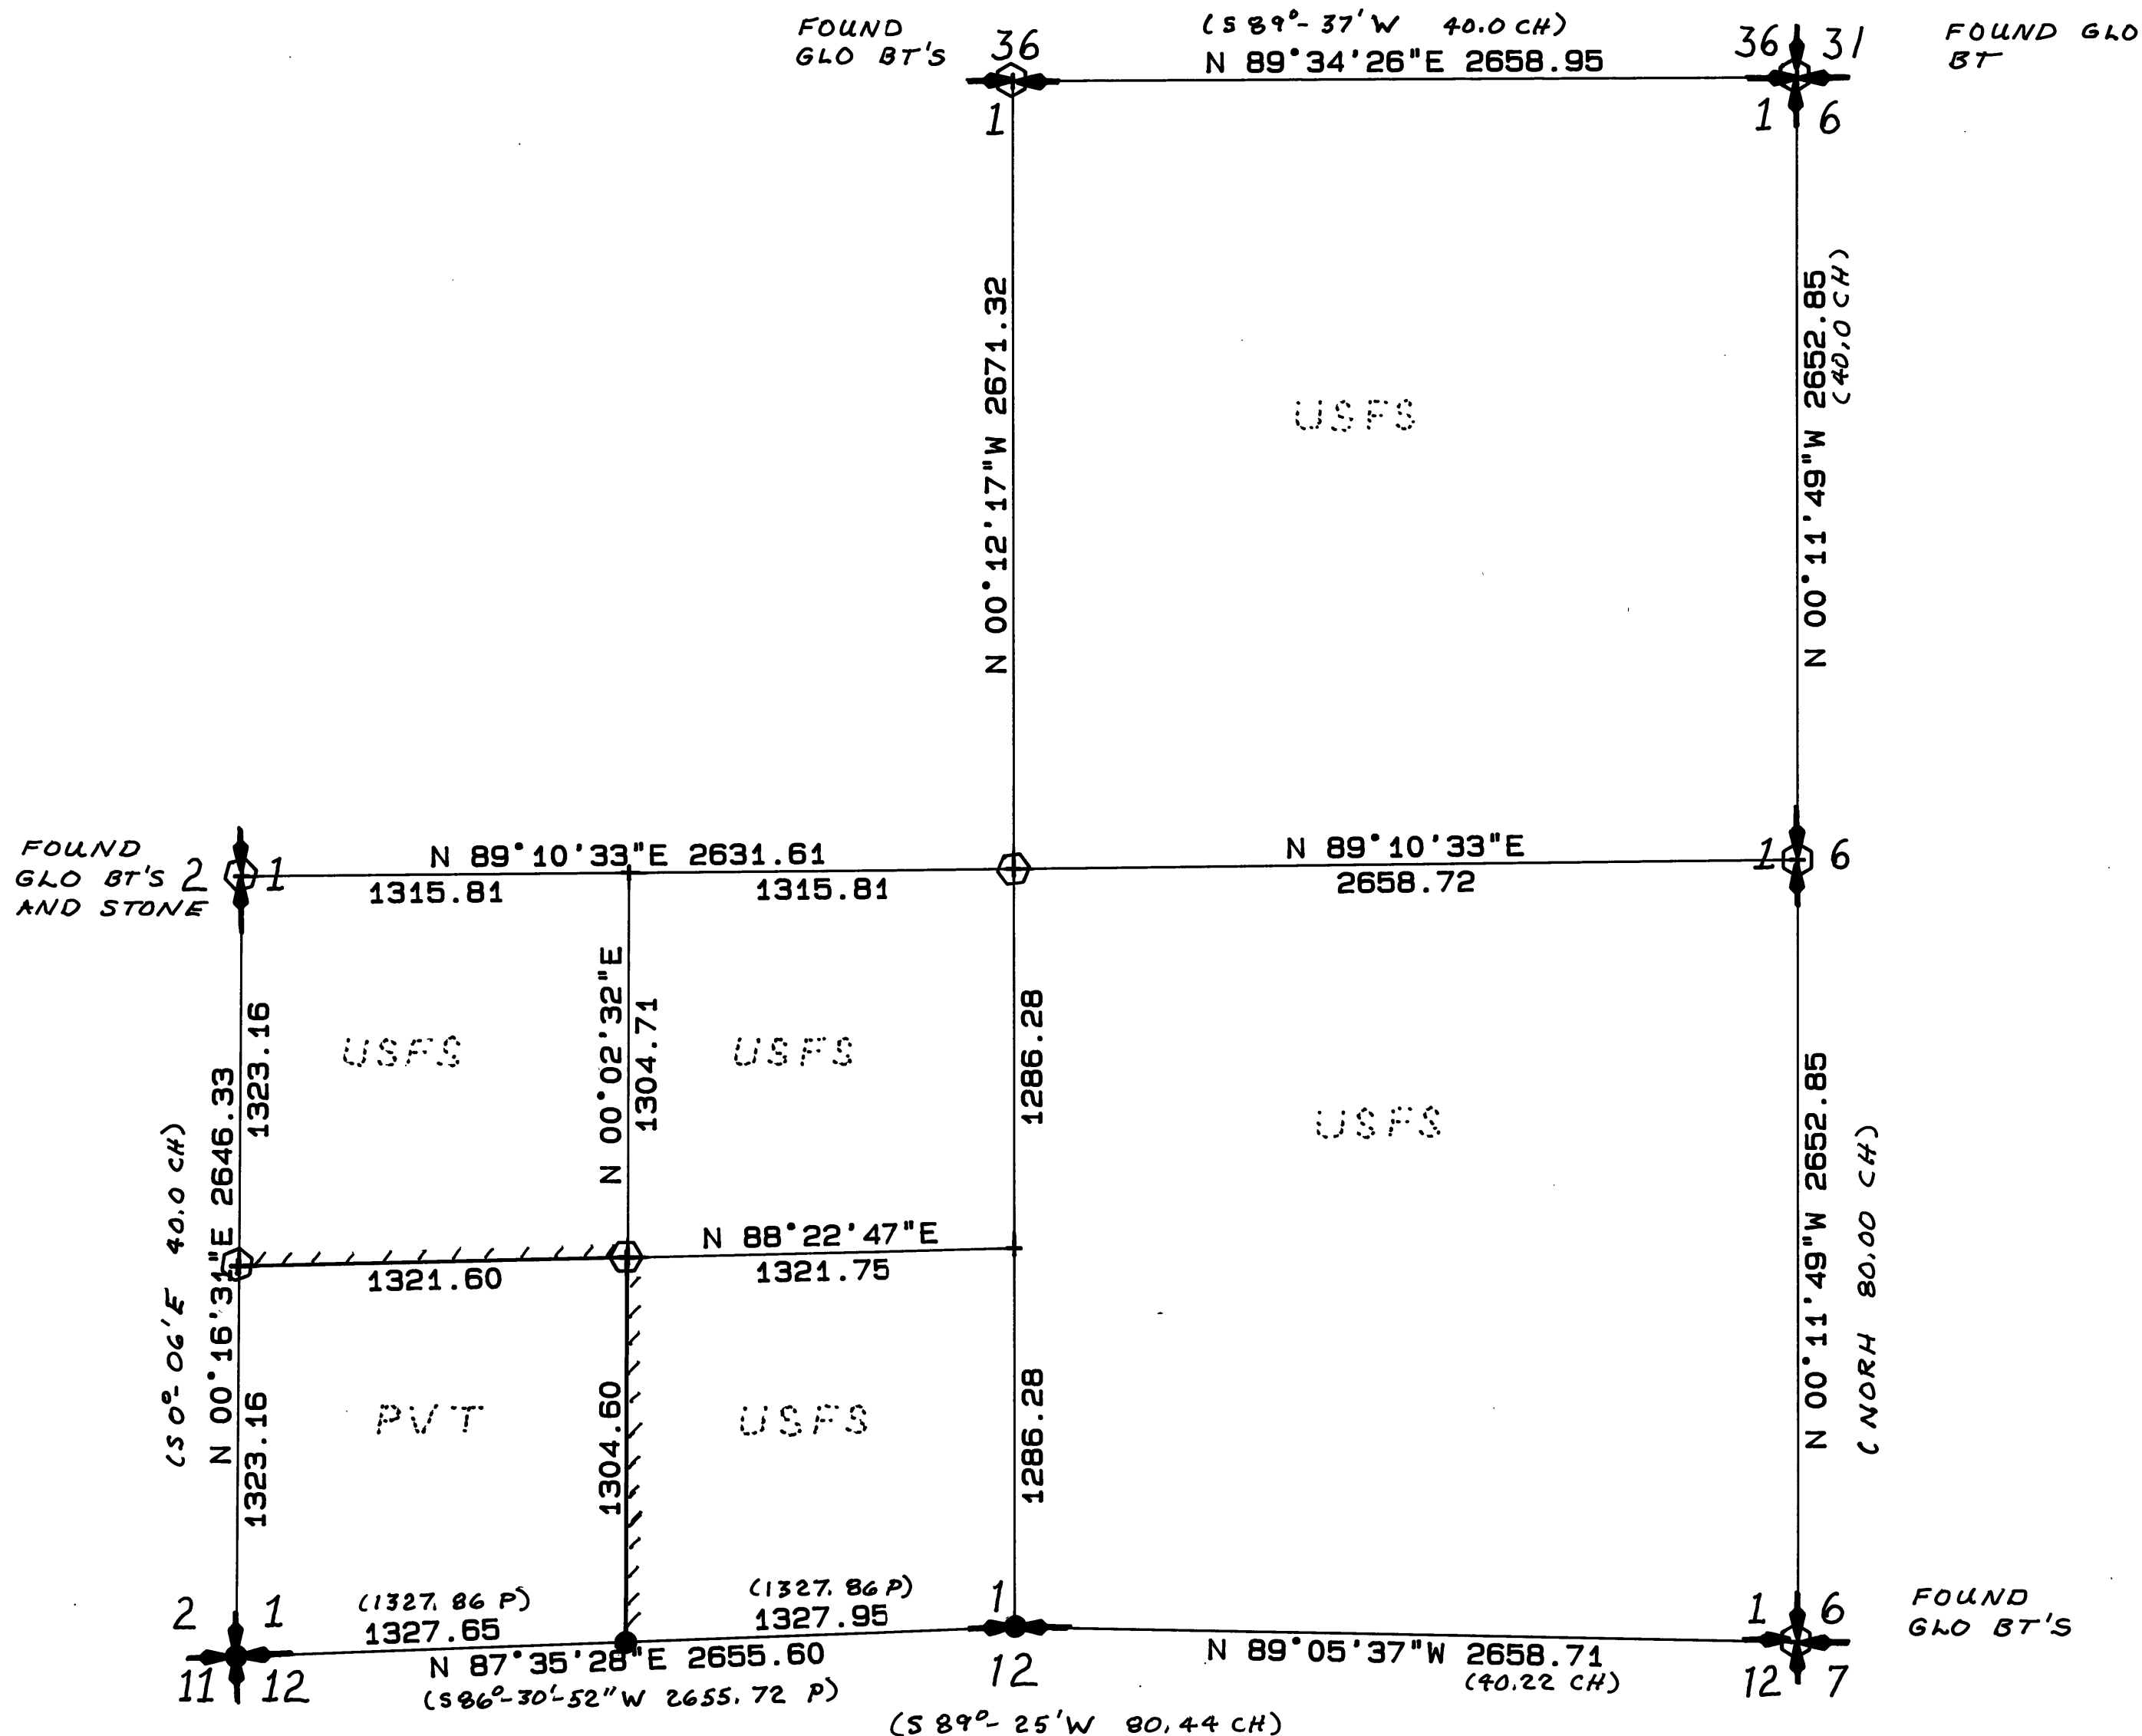

FOUND MONUMENT OF RECORD
SET 2.5 BY 30 INCH ALUM. MONUMENT
PROPERTY LINE ESTABLISHED AND POSTED
() SURVEY DATA OF RECORD

CONTRACT NO.: 53-04KK-8-02420

**CERTIFIED LAND CORNER RECORDATION FORMS FOR ALL
LAND CORNERS FOUND OR SET HAVE BEEN FILED WITH
THE GRANT COUNTY SURVEYOR'S OFFICE.**

REGISTERED
PROFESSIONAL
LAND SURVEYOR

Edwin A. Stryker

OREGON
JULY 15, 1983
EDWIN A. STRYKER
2060

RT 1 BOX 316 LEWIS CREEK ROAD
SUMMERVILLE, ORE 97876
(503) 534-6905

DRAWN HP7575A

JOB NO 0488101234

DATED 8-14-89

CHECKED BY EAS

SCALE 1 in. = 500

SHEET 4 OF 4