

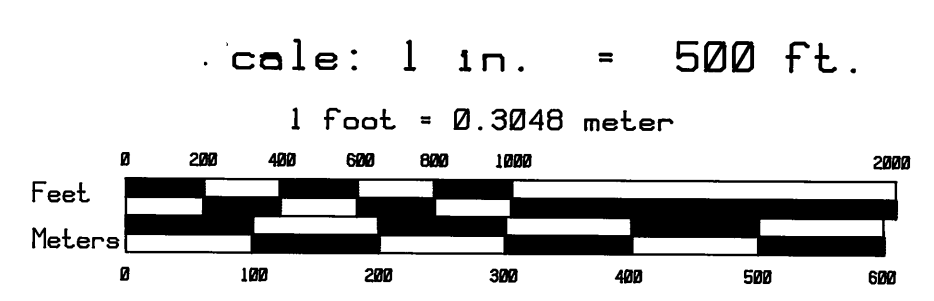
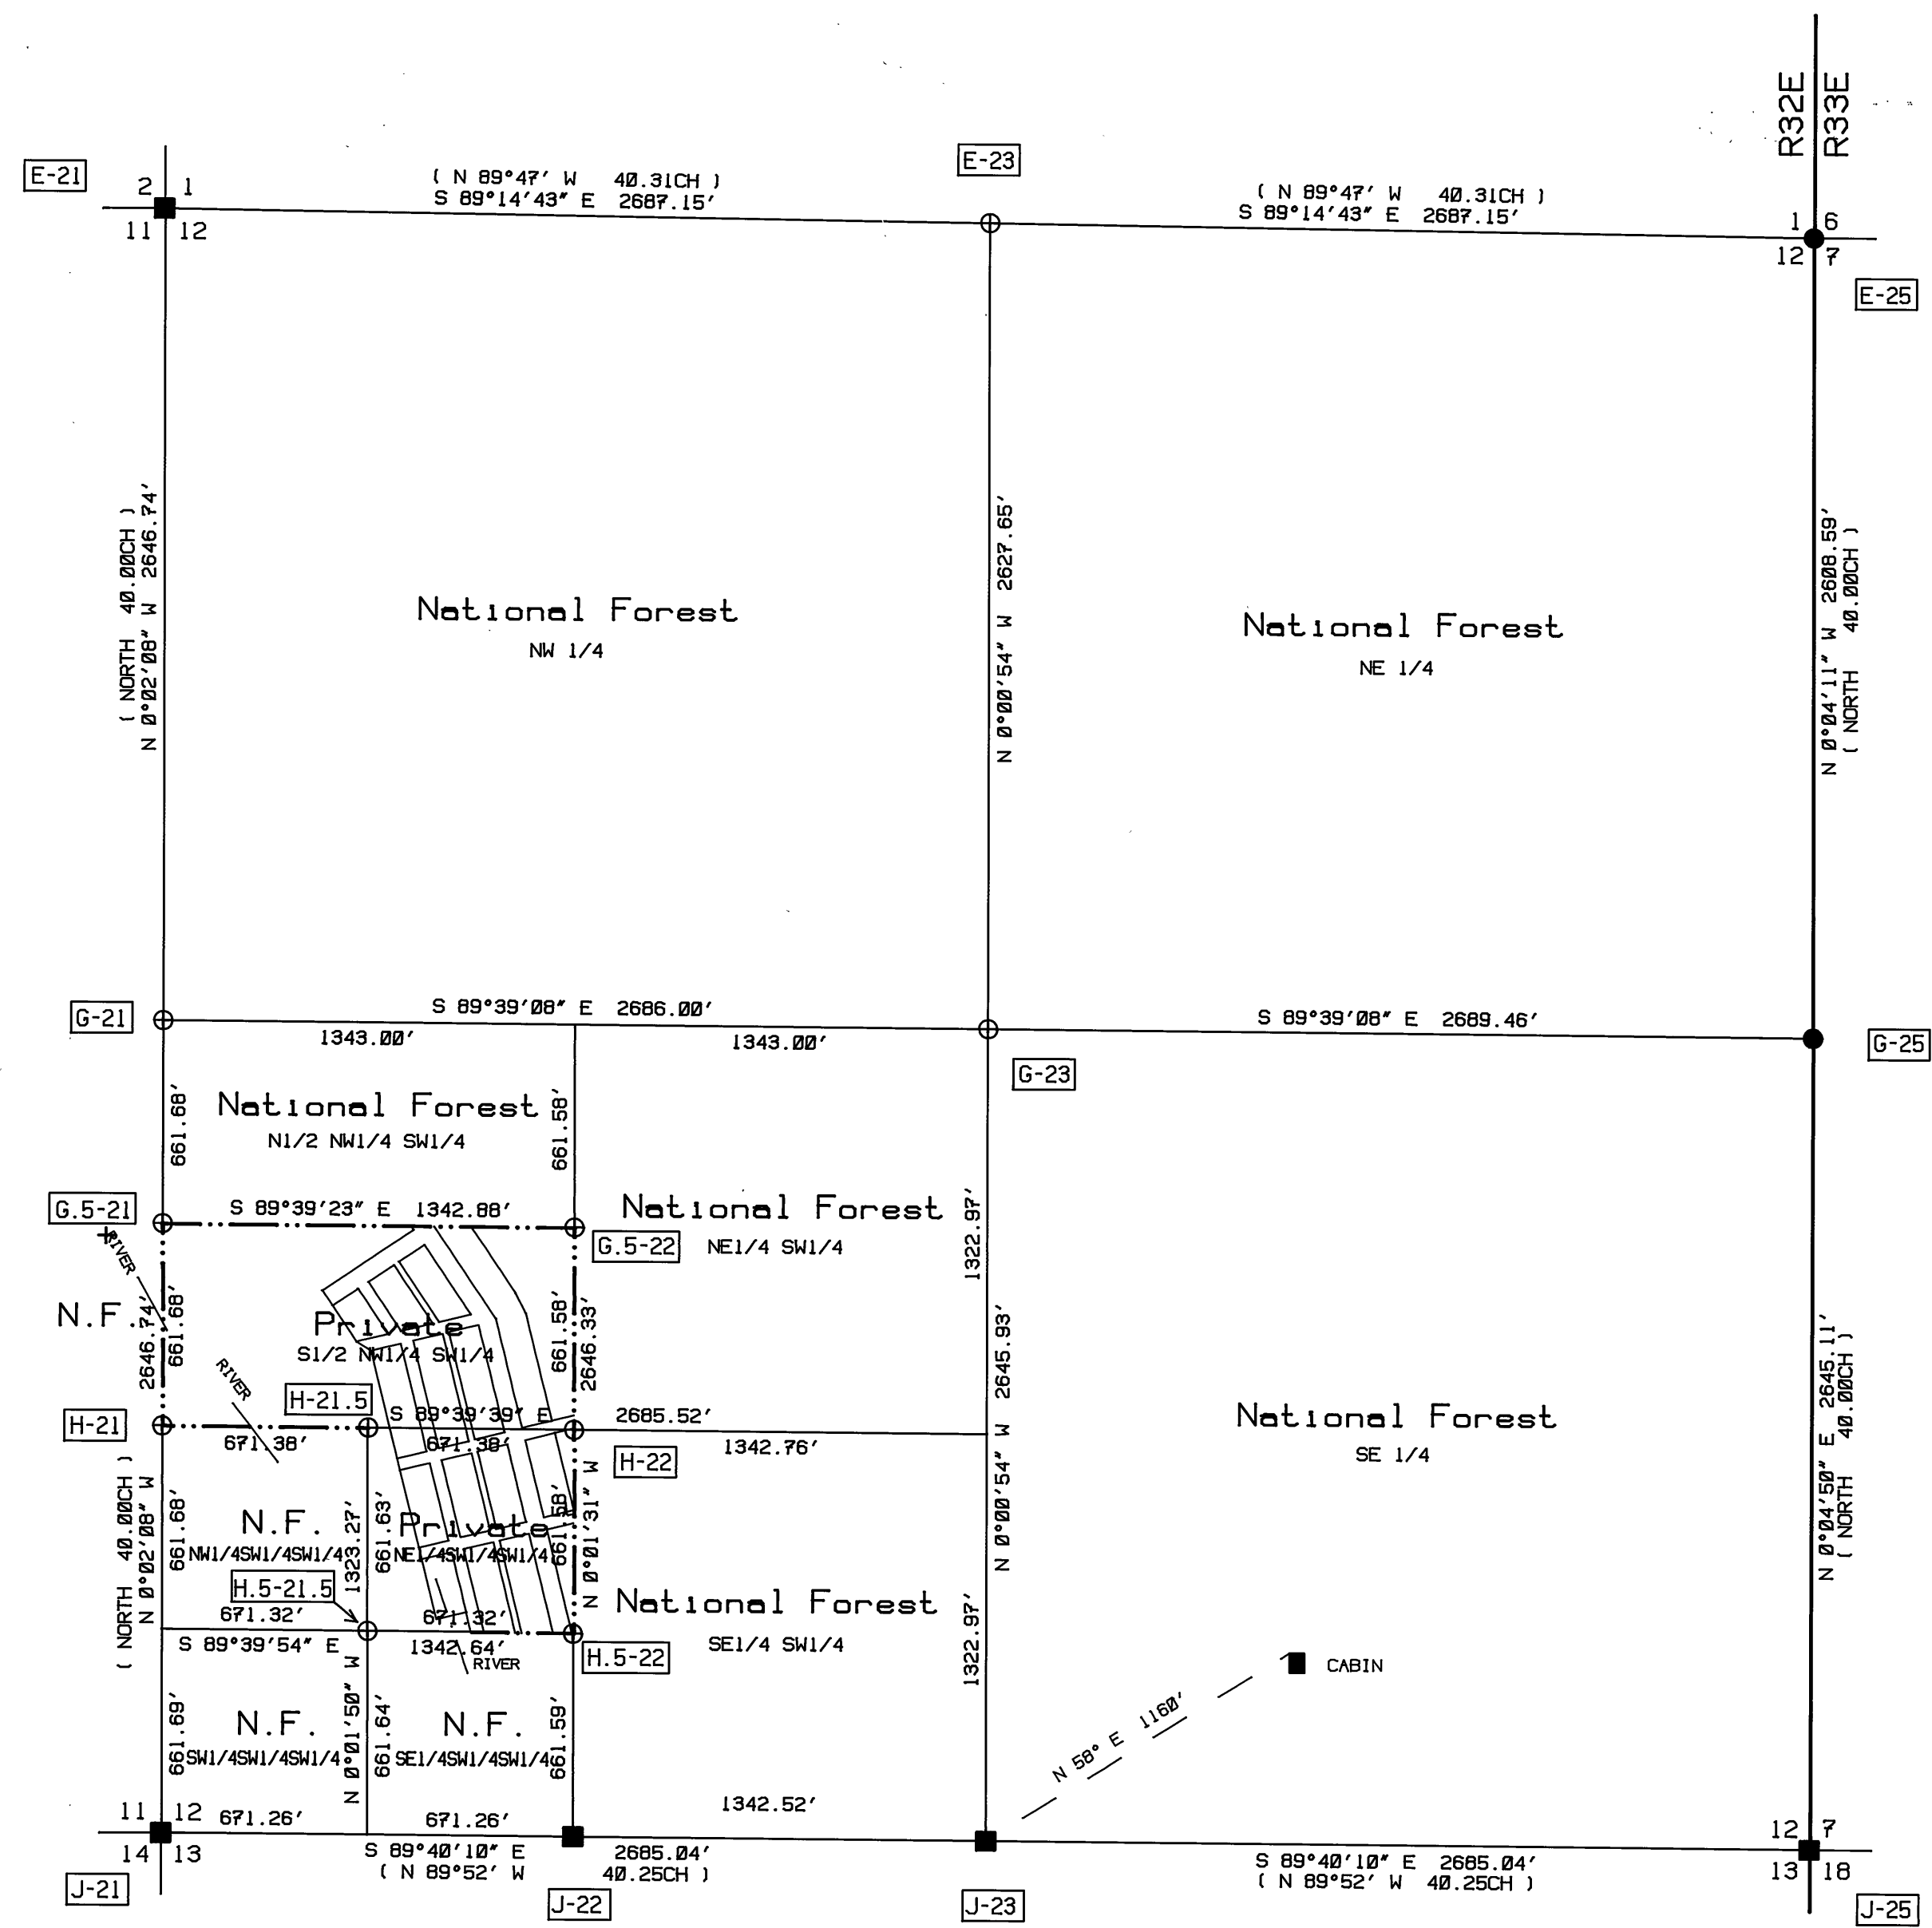
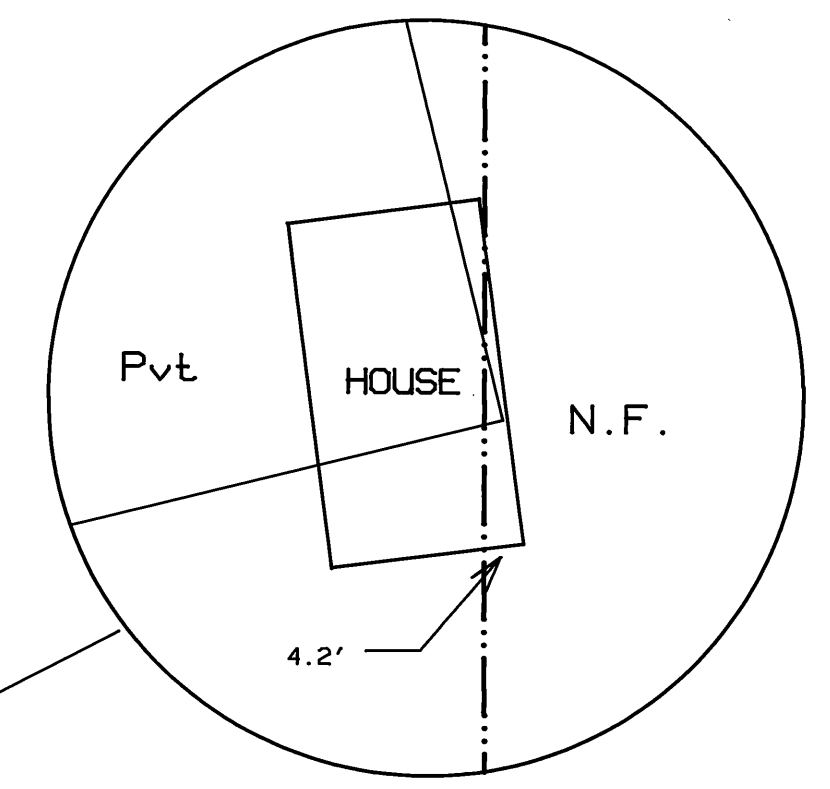


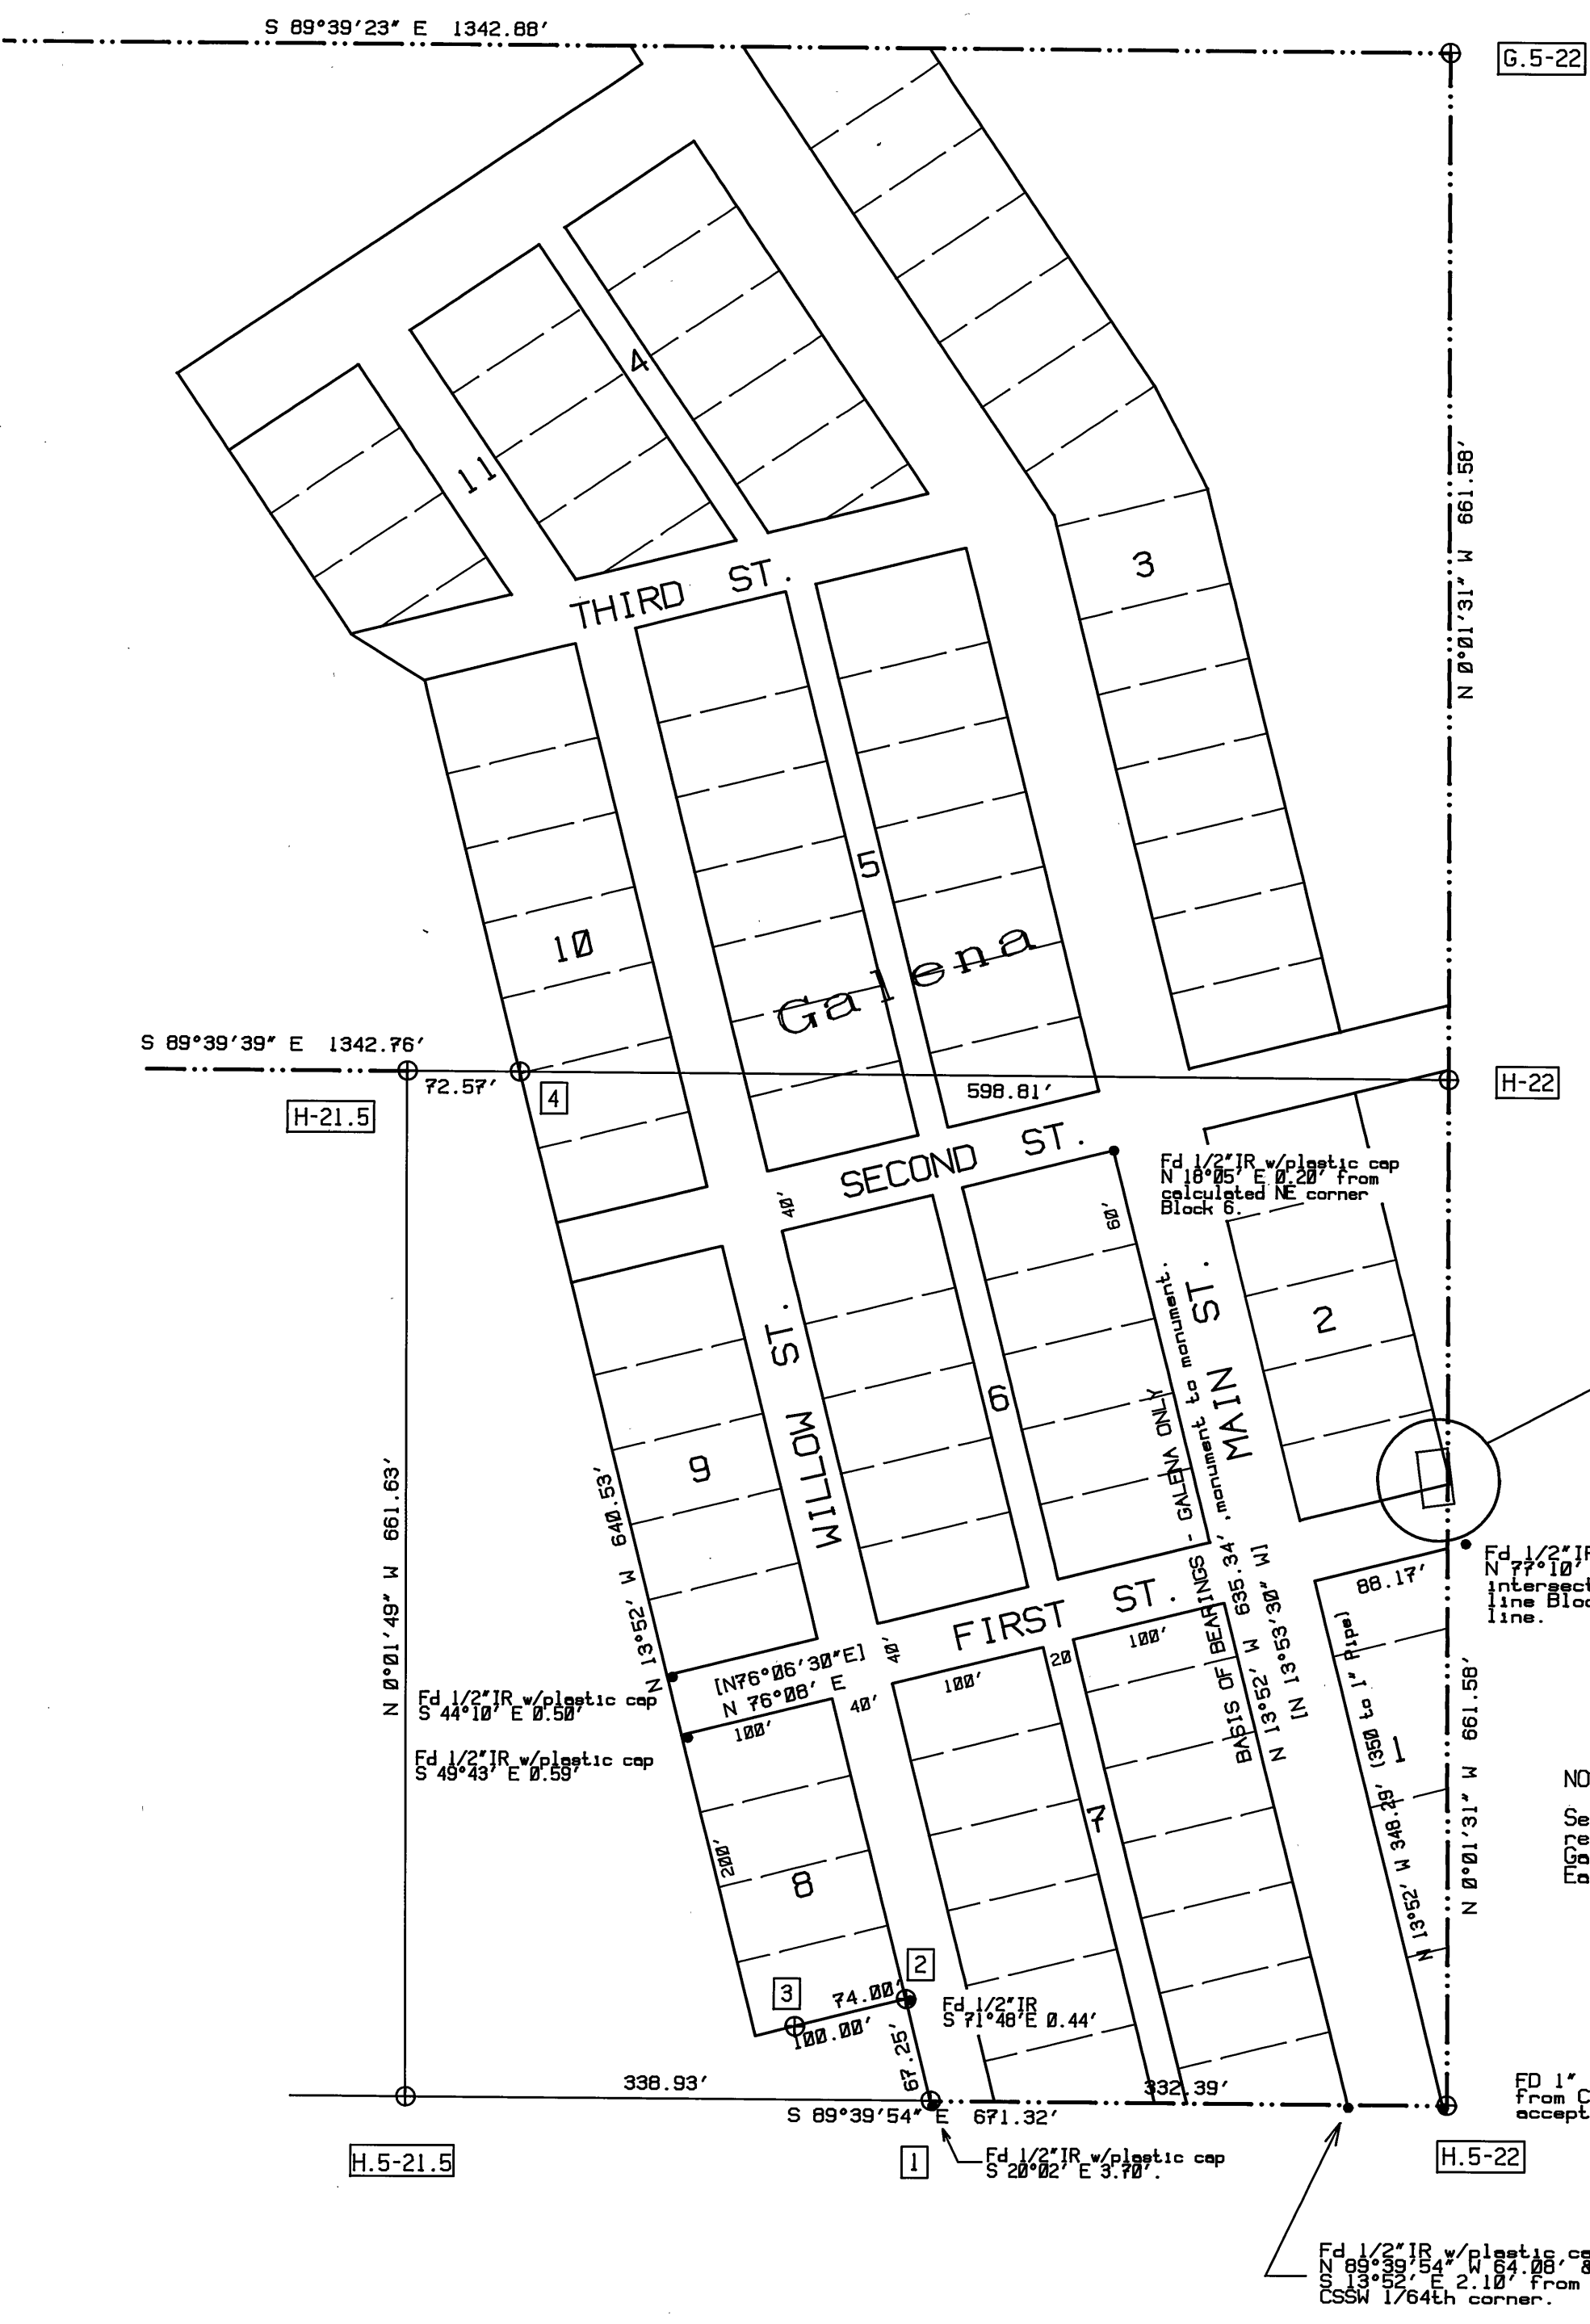

- Legend
- Found aluminum or brass cap.
 - Found corner. Set 2-1/2x30" aluminum monument.
 - Set 2-1/2x30" aluminum monument.
 - () Record Information, GLO 1881.
 - [] Record Information, CS 365.
 - ([]) Record Information.
 - Boundary line posted this contract.
 - [C-15] Corner reference.

Surveyor's Certificate

I, TYLER B. PARSONS, a Registered Land Surveyor in the State of Oregon, do hereby certify that this plot and the notes hereon or attached, are a correct representation of a survey performed at the request of the U.S. Forest Service during the period August 29 to September 9, 1989 in accordance with the statutes of the State of Oregon and the articles of my contract.

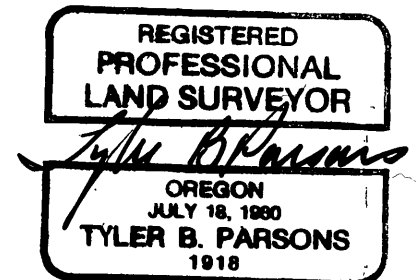

NOTE:
See Narrative for additional information regarding the establishment of lines in Galena, and discrepancies regarding the East and South lines.

RECORD OF SURVEY
for the
U.S. FOREST SERVICE

Malheur National Forest
Sec 12, T10S, R32E, W.M.
Grant County, OR
Sun Cadastral Survey
Cont. No. 53-04H1-7-4011
September 11, 1989
PARSONS SURVEYING
1915 S.E. Stone Street
Corvallis, OR 97333
(503) 752-7515
Job No. 8722LC

RECEIVED AND
FILED
NOV 21 1989
OFFICE OF COUNTY SURVEYORS
ASTORIA

Separate Narrative Attached