

LEGEND

- Found %" iron pin of record.
- Set %"x30" iron pin with attached yellow plastic cap marked BGA SURVEY MARKER.
- Record bearing and distance.
- Found monument from Recorded Survey No. Survey No. appears in box.

NARRATIVE: This survey was performed at the request of Don Lundbom. The purpose of this survey was to create the 15 foot and 22 foot wide strips of land lying west of Mr. Lundbom's land as shown hereon. Mr. Lundbom intends to acquire this strip of land.

A search was made of the available records pertaining to this survey. Field measurements were made to locate existing monuments. New monuments were set in accordance with the evidence found and at locations approved by Mr. Lundbom.

This survey was performed with a theodolite and electronic distance measuring equiptment.


I held the found monuments along the west line of Mr. Lundbom's tract as set in Survey No. 285 and the monuments along the access easement set in Survey No. 1087 to control this survey.

The found monuments along the highway indicate that the high-way right of way line, as established in Survey No. 932 for the Oregon Dept. of Transportation, is 0.3 feet northerly of the old highway right of way line as established in Survey No. 285 & 389. This is due to the difference in survey field measurements in the tie from the SE corner of section 22. The difference is within accepted tolerances. I set the pin on the right of way line as established in Survey No. 285 & 389 for the purpose of this survey.

REGISTERED PROFESSIONAL LAND SURVEYOR

ROBERT D. BAGETT.

received and file o WW 271930

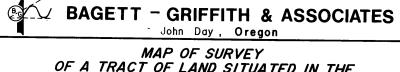

MAP OF SURVEY
OF A TRACT OF LAND SITUATED IN THE
SE14SE14 OF SECTION 22, TI3S, R3IE, W.M.

Drawn by: J.L.W.

10/17/89

GRANT COUNTY, OREGON SURVEYED FOR DON LUNDBOM SURVEYED BY R.D.B. & J.L.W.

Scale: /"=20"