


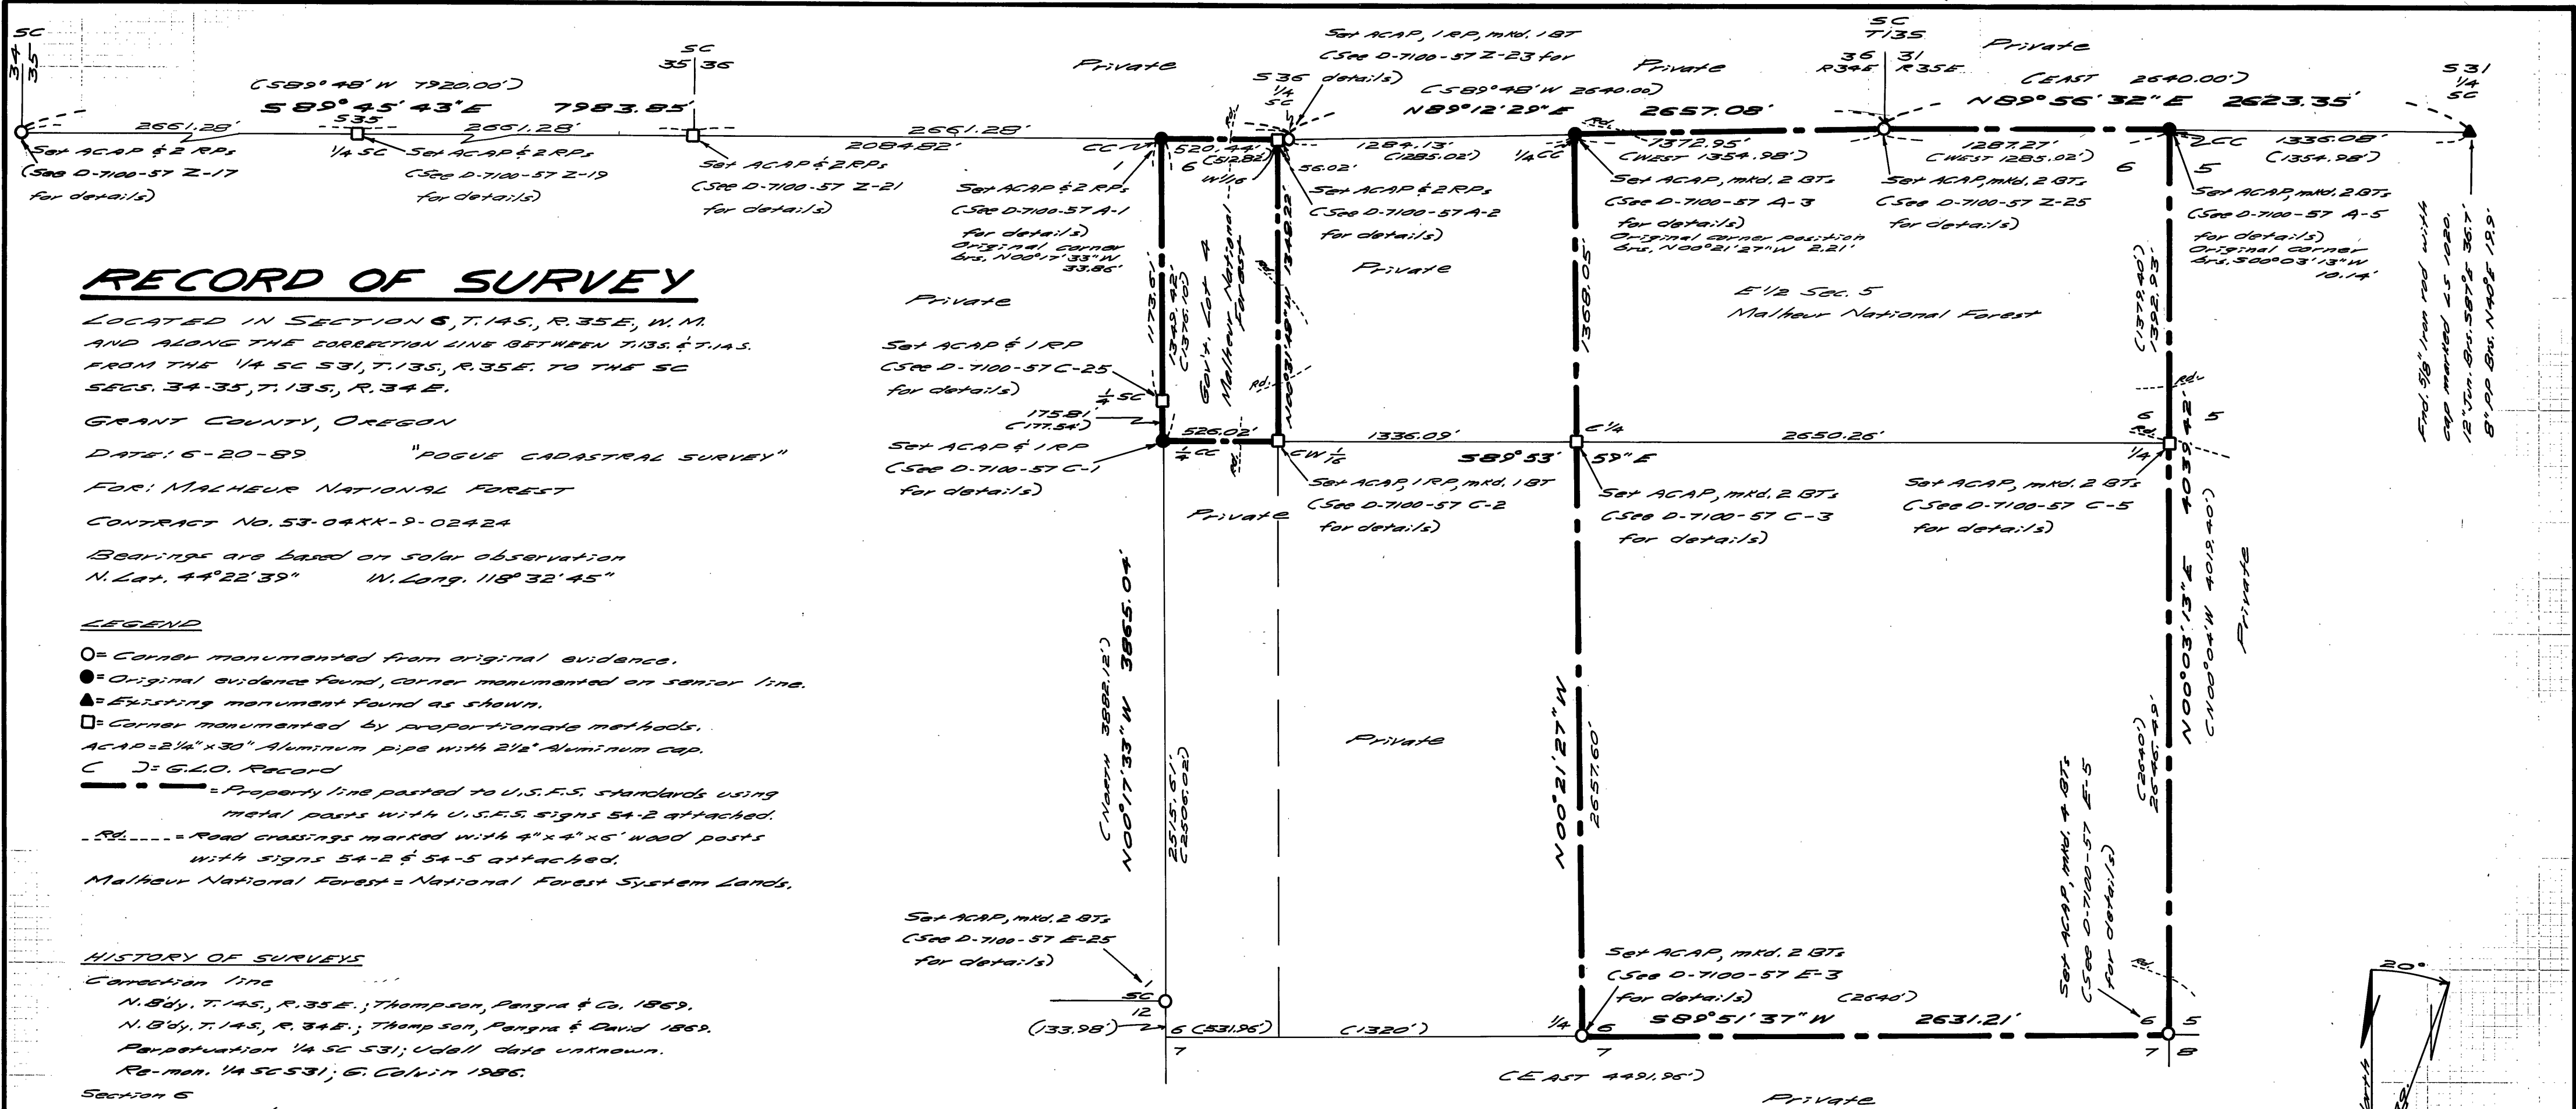

RECORD OF SURVEY

LOCATED IN SECTION 6, T.14S, R.35E, W.11.
AND ALONG THE CORRECTION LINE BETWEEN T.13S. & T.14S.
FROM THE 1/4 SC 531, T.13S, R.35E. TO THE SC
SECS. 34-35, T.13S, R.34E.

GRANT COUNTY, OREGON
DATE: 6-20-89 "POQUE CADASTRAL SURVEY"
FOR: MALHEUR NATIONAL FOREST
CONTRACT NO. 53-04XK-9-02424

Bearings are based on solar observation
N. Lat. 44°22'39" W. Long. 118°32'45"

- LEGEND**
- = Corner monumented from original evidence.
 - = Original evidence found, corner monumented on senior line.
 - ▲ = Existing monument found as shown.
 - = Corner monumented by proportionate methods.
 - ACAP = 2 1/4" x 30" Aluminum pipe with 2 1/2" Aluminum cap.
 - C = G.L.O. Record
 - = Property line pasted to U.S.F.S. standards using metal posts with U.S.F.S. signs 54-2 attached.
 - RD = Road crossings marked with 4" x 4" x 6" wood posts with signs 54-2 & 54-5 attached.
 - Malheur National Forest = National Forest System Lands.

HISTORY OF SURVEYS

Correction line
N. 84y, T.14S, R.35E.; Thompson, Pangra & Co. 1869.
N. 84y, T.14S, R.34E.; Thompson, Pangra & David 1869.
Perpetuation 1/4 SC 531; Udell date unknown.
Re-man. 1/4 SC 531; G. Colvin 1986.

Section 6
W. 84y; Robb & Luckland 1880; George Campbell 1901
E. & S. 84y.; George Campbell 1901

GENERAL NOTES

All monuments and bearing trees established in this survey are marked as per B.L.M. Manual of Surveying Instructions, 1973, unless otherwise noted. All field notes for this survey are on file in the office of George Colvin.

All corners monumented have a Certified Record of Land Corner Monumentation, Form (D-7100-57) on file in the County Surveyor's Office along with this plat. The plat identifies the alpha-numeric index file number of the D-7100-57 for each corner, which by reference is made a part of this plat.

New BTs are marked with brass discs marked 251020 nailed on BT blaze. Measurements to BTs are taken to side center at root crown. Bearings to BTs were taken with a magnetic compass with declination set at 20° East.

All RPs have a steel guard post set within 6" of the RP with signs 54-9 attached.

I, George Colvin, Registered Land Surveyor in the State of Oregon, do hereby certify that this plat and the notes thereon are a correct representation of a survey I performed in Dec. 1988, May & June 1989 for the U.S. Forest Service in accordance with the statutes of the State of Oregon and the articles of my contract.

George Colvin
George Colvin ORPLS 1020

NARRATIVE

The purpose of this survey was to mark the corners and post the boundary between Private and National Forest System Lands. Control was established by a random closed traverse with a precision of 1/15,000. Pasting was accomplished by offsetting from the random traverse to true line and by pasting on true line between intervisible monuments. Where random spacing was inadequate, points on line were set to offset to true line from. The only questionable area in this survey was at the 1/4 SC Sec. 35 where as the correction line makes an unusually large angle. A marked stone was found at said 1/4 reasonably close to record size at the edge of a 2' dia. stone mound. The center stone fit record measurement but was not marked. The stone mound was well sodded with some of the exterior stones completely buried under the sod. I held the center of the mound as the corner position. There are very few other stones in the area. The corner position accepted was further verified by the alignment of the N 1/4 CC Sec. 5 and the SC Secs. 35-31 (Township corner) agreeing very closely with said corner position. Search had to be conducted 1 1/2 mi. West of the 1/4 SC Sec. 35 to recover original evidence for establishment of the correction line T.13S. & T.14S. Alignment. No other unusual conditions were encountered. Survey was completed in June, 1989.

Instrumentation:
Wild T-15 Theodolite
Topcon DM-51 EDM
Topcon GTS-3B
50' & 100' Steel Band Tapes

Personnel:
George Colvin
Bobbie Colvin

APPROVALS

Examined and accepted for the U.S. Forest Service this 7th day of July, 1989.

SE ALBERT G.O.R.


I certify that this survey was performed at the request of the Malheur National Forest Supervisor.

Michael J. Colvin 7-12-89
Forest Supervisor Date

RECEIVED AND FILED

NOV 9 1989

OFFICE OF COUNTY SURVEYOR
J. W. WATSON

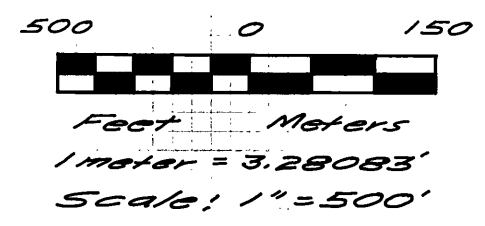

REGISTERED
PROFESSIONAL
LAND SURVEYOR

George Colvin
OREGON
FEBRUARY 14, 1975
GEORGE W. COLVIN, JR.
1020

GEORGE COLVIN
LAND SURVEYOR
20602 COVENTRY CIRCLE
BEND, OREGON 97702
PHONE: (503) 382-2039