
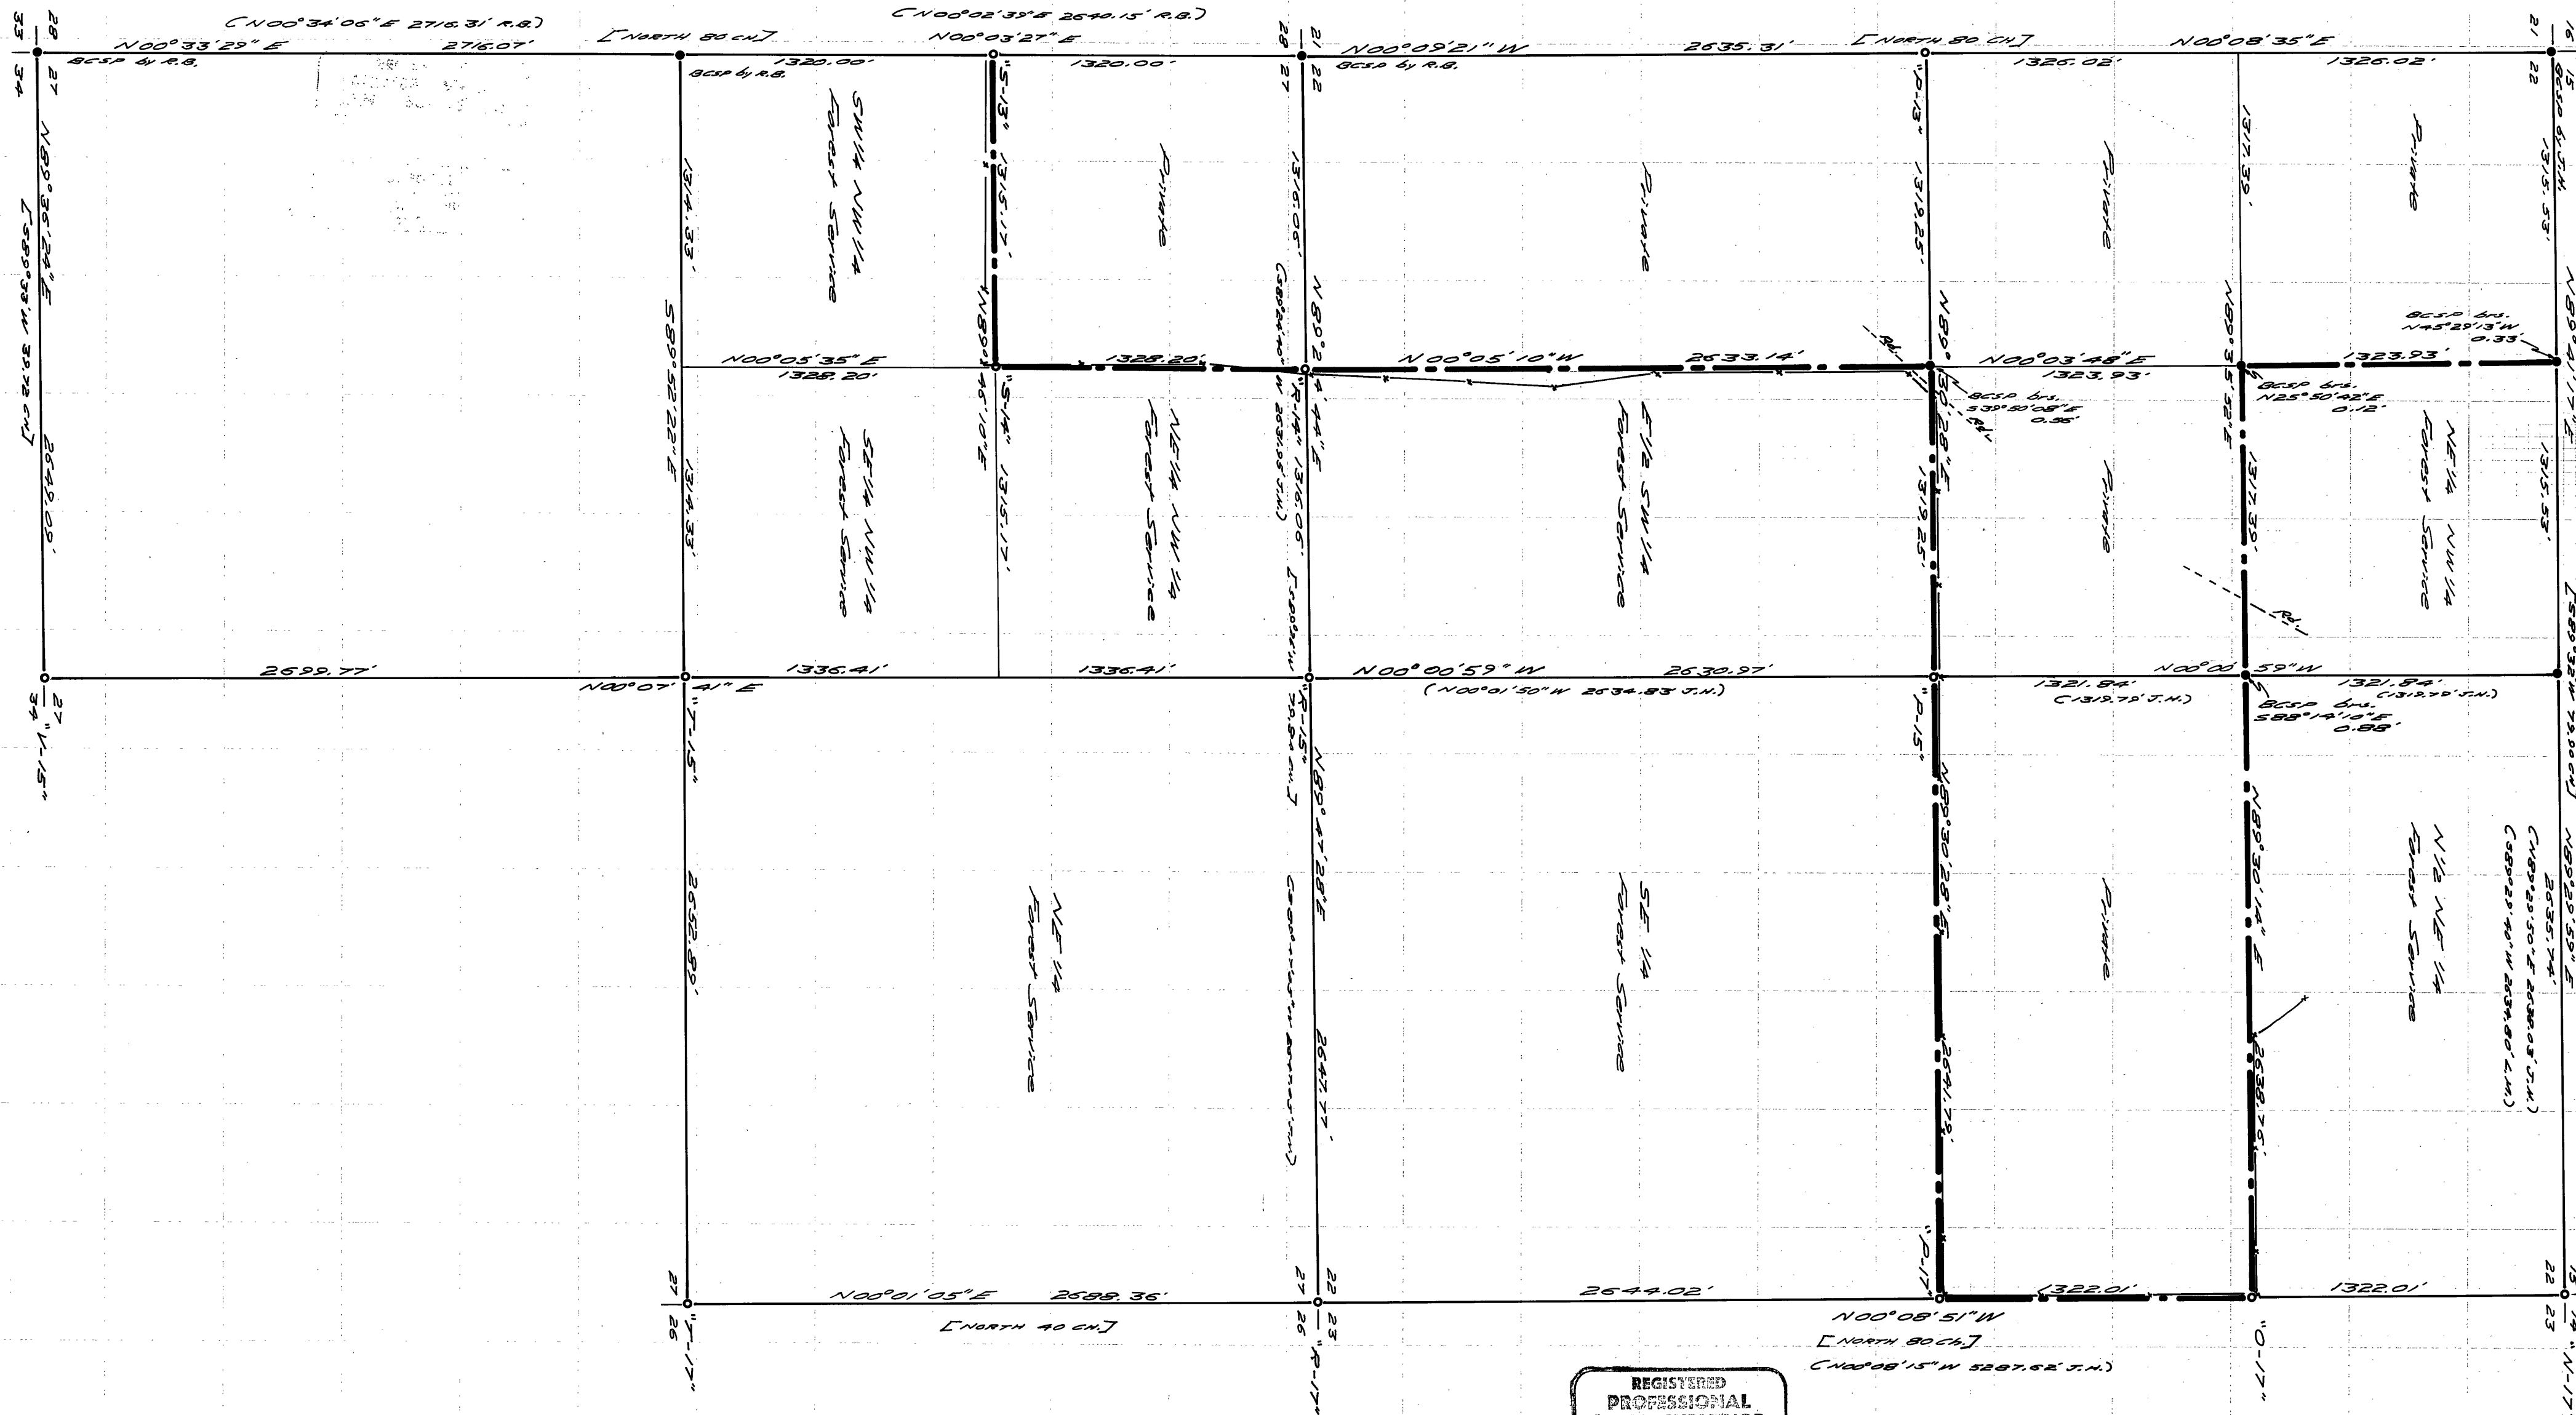


REGISTERED
PROFESSIONAL
LAND SURVEYOR

OREGON
FEBRUARY 14, 1975
GEORGE W. COLVIN, JR.
1020

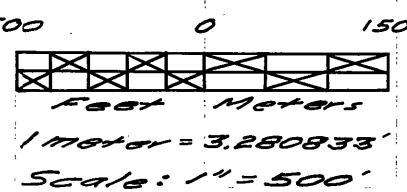

RECEIVED AND
FILED
DEC 1 1989

OFFICE OF COUNTY SURVEYOR

SECTIONS 22 & 27, T.11S., R.35E., W.1M.

BATES CADASTRAL SURVEY

RECORD MAP OF SURVEY NO. 1116 SHEET 2 OF 4