



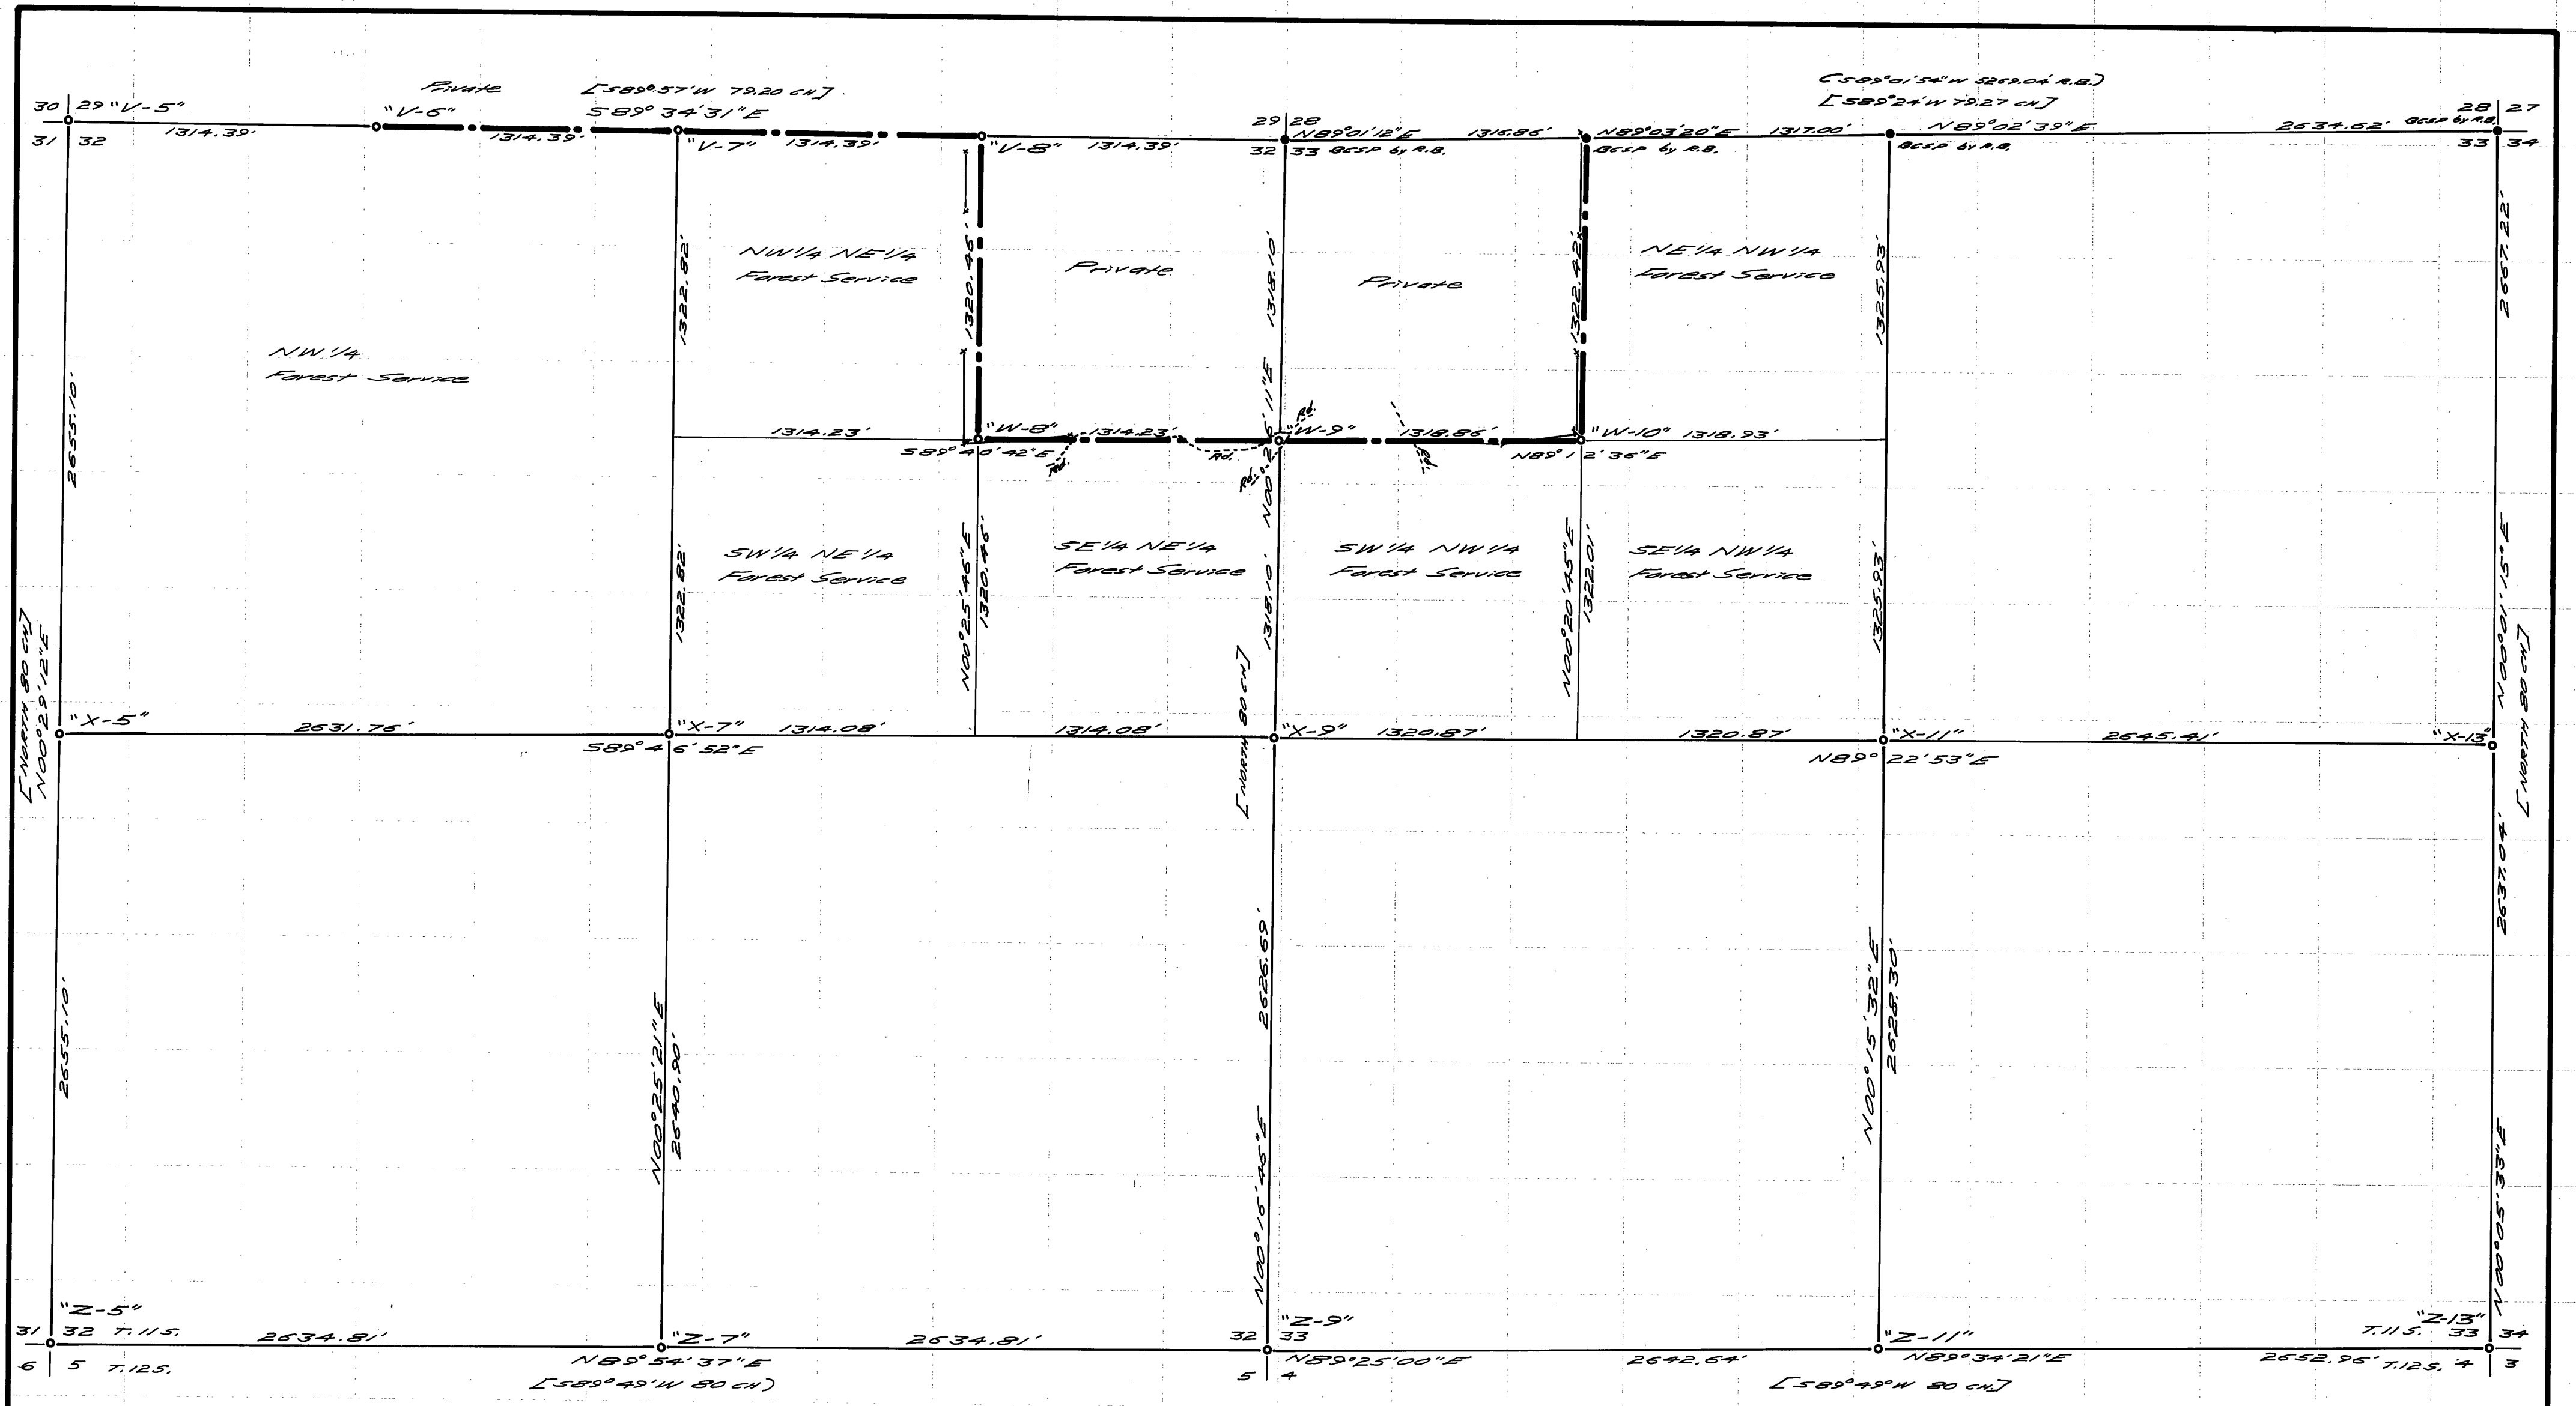

RECEIVED AND
FILED
DEC 1 1989
OFFICE OF COUNTY SURVEYOR
CLATSOP COUNTY
ASTORIA, OREGON

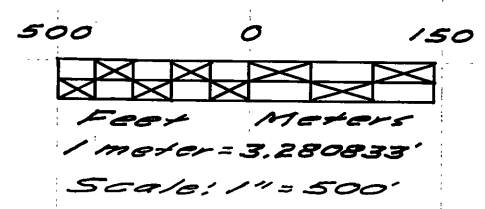

REGISTERED
PROFESSIONAL
LAND SURVEYOR
George W. Colvin, Jr.
OREGON
FEBRUARY 14, 1975
GEORGE W. COLVIN, JR.
1970

SECTIONS 32 & 33, T.115, R.35E, W.11.