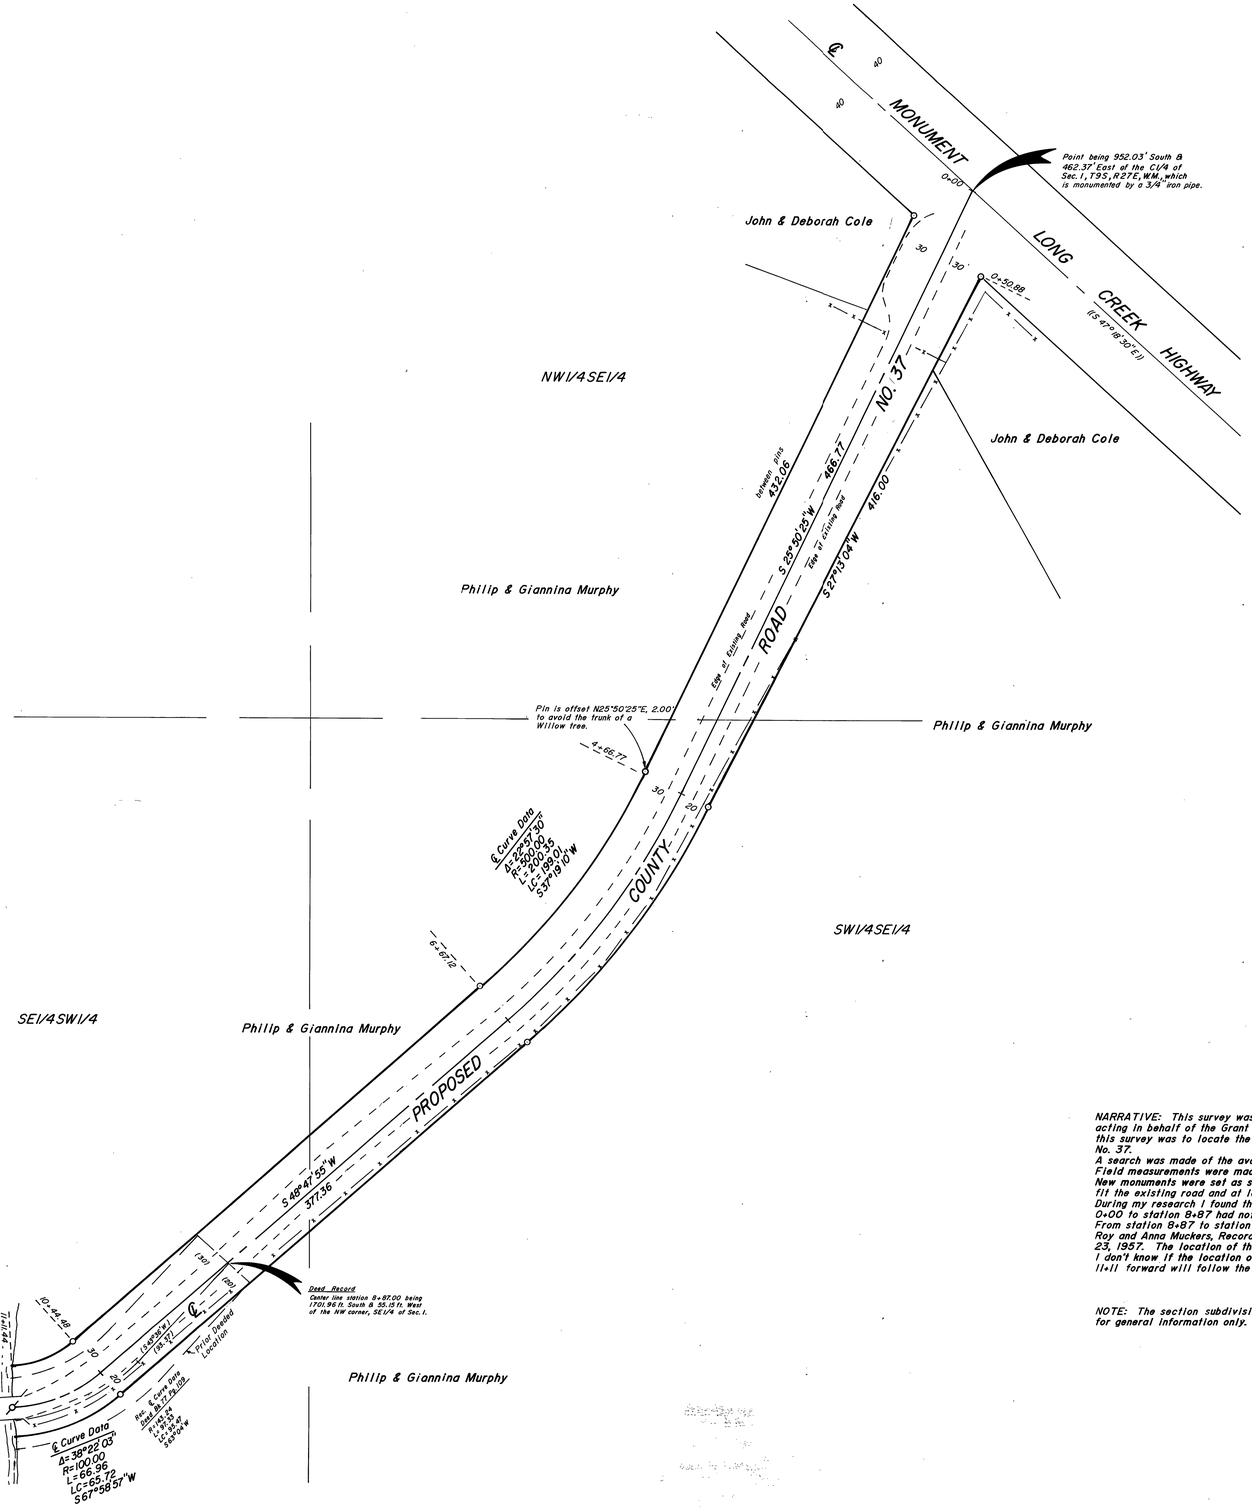

BASIS OF BEARINGS
SOLAR OBSERVATION

LEGEND

- ⌀ Set railroad spike
- ○ Set 5/8"x30" iron pin with attached yellow plastic cap marked BGA SURVEY MARKER.
- x——x Fence line.
- (( )) Record bearing from Highway Drawing No. 5B-25-17
- ( ) Record bearing and distance from Deed Book 77 Page 109.

REFERENCES

Deed Record Book 77 Page 109
96 359
96 521
119 449
138 927
Highway Drawing No. 5B-25-17

NARRATIVE: This survey was performed at the request of Ab Bezona, acting in behalf of the Grant County Road Department. The purpose of this survey was to locate the right of way for a portion of County Road No. 37.
A search was made of the available records pertaining to this survey. Field measurements were made to locate the existing road and fences. New monuments were set as shown hereon at positions determined to fit the existing road and at locations approved by Mr. Bezona.
During my research I found that the portion of this road from station 0+00 to station 8+87 had not been deeded or dedicated to the County. From station 8+87 to station 25+18.20 the county recieved a deed from Roy and Anna Muckers, Recorded in Deeds Book 77, Page 109, on May 23, 1957. The location of the first part of this deed is shown hereon. I don't know if the location of the remainder of this road from station 11+11 forward will follow the deeded location.

NOTE: The section subdivisional lines shown are protracted for general information only.

REGISTERED PROFESSIONAL LAND SURVEYOR
OREGON
JULY 12, 1985
ROBERT D. BAGETT
598

RECEIVED AND FILED
DEC 11 1989
COUNTY SURVEYOR, GRANT COUNTY, OREGON

BAGETT - GRIFFITH & ASSOCIATES
John Day, Oregon

MAP OF SURVEY
A PORTION OF COUNTY ROAD NO. 37
SITUATED IN THE W½SE¼ & SE¼SW¼ OF SECTION 1, T9S, R27E, W.M.
GRANT COUNTY, OREGON

SURVEYED FOR	GRANT COUNTY ROAD DEPARTMENT	
SURVEYED BY	R.D.B. & J.L.W.	11/10/89
Scale: 1"= 50'	Drawn by: J.L.W.	

RECORD MAP OF SURVEY NO. 1119