SURVEY OF MALHEUR NATIONAL FOREST BOUNDARY LINES IN SECTIONS 4 AND 5 TOWNSHIP IG SOUTH, RANGE 31 EAST, W.M., AND SECTION 32, TOWNSHIP IS SOUTH, RANGE 31 EAST, W.M., GRANT COUNTY, OREGON. W.D. 88-628~G


GULCH CADASTRAL SURVEY CONTRACT NO. 53-04KK-8-02399 MALHEUR NATIONAL FOREST BEAR VALLEY RANGER DISTRICT

SURVEY FOR

U.S.D.A. FOREST SERVICE MALHEUR NATIONAL FOREST 139 N.E. DAYTON STREET JOHN DAY, OREGON 97845 E503 J 575 - 1731 AA

SURVEY BY

ARMSTRONG SURVEYING & ENGINEERING, INC. 378 EAST SECOND STREET PRINEVILLE, OREGON 97754 

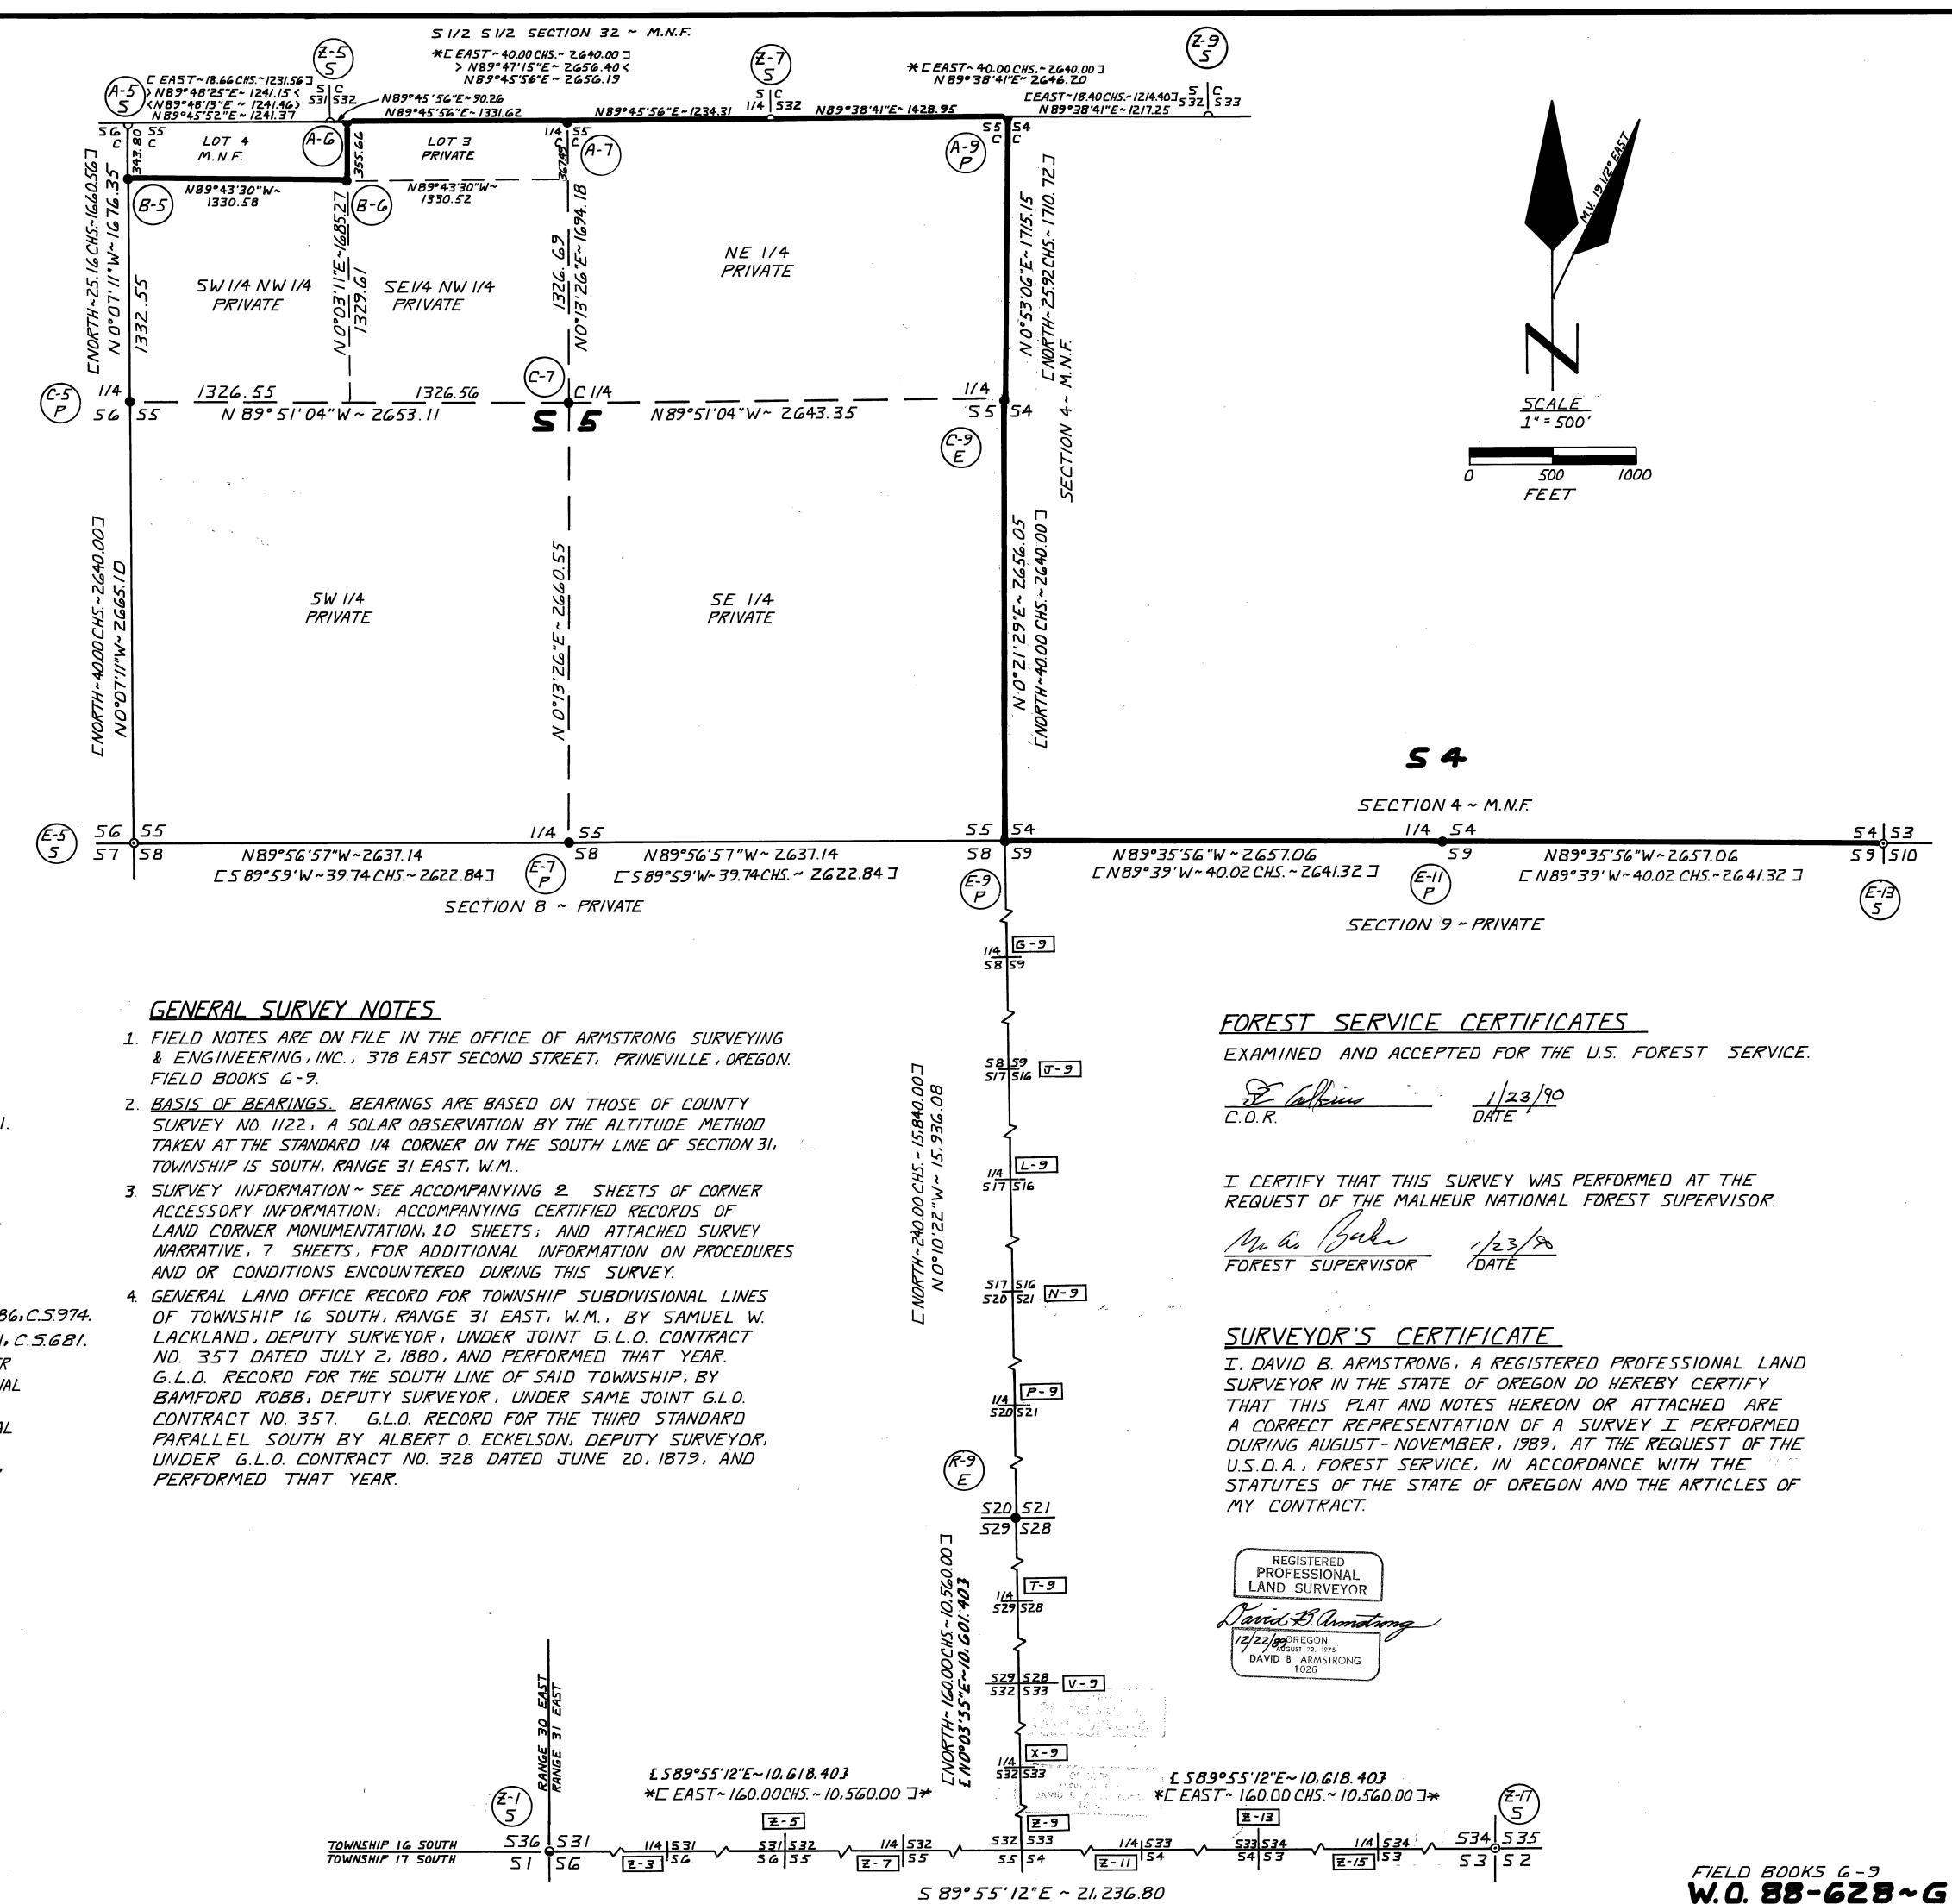

## LEGEND

- SET Z I/Z" O.D. X 30" LONG ALUMINUM PIPE WITH A Z I/Z" ALUMINUM CAP MARKED AS PER CORNER DIAGRAM SHOWN ON CORNER SUMMARY.
- O FOUND 2 1/2"BRASS CAP MARKED AS PER CORNER DIAGRAM SHOWN ON CORNER SUMMARY BY ROBERT D. BAGETT, LS 598 ,IN 1981.
- FOUND 2 1/2" BRASS CAP MARKED AS PER CORNER DIAGRAM SHOWN ON CORNER SUMMARY BY ROBERT D. BAGETT, L5 598, IN 1983.
- FOUND 3 1/4" ALUMINUM CAP MARKED AS PER CORNER DIAGRAM SHOWN ON CORNER SUMMARY BY LELAND L. MYERS, LS 699, IN 1986.
- T RECORD SURVEY INFORMATION BY SAMUEL W. LACKLAND, IN 1880.
- \*[ ] RECORD SURVEY INFORMATION BY ALBERT O. ECKELSON, IN 1879. \*[ ]\* RECORD SURVEY INFORMATION BY BAMFORD ROBB, IN 1880.
- RECORD SURVEY INFORMATION BY DOUGLAS M. FERGUSON, LS 848, IN 1986, C.S.974. RECORD SURVEY INFORMATION BY ROBERT D. BAGETT, LS 598, IN 1981, C.S.681.
- ---- INDICATES MALHEUR NATIONAL FOREST BOUNDARY LINE POSTED UNDER THIS CONTRACT WITH G FOOT LONG STEEL FENCE POSTS WITH NATIONAL FOREST BOUNDARY SIGNS [54-2] ATTACHED.
- CORNER MONUMENT NUMBER ~ SEE CORNER SUMMARY FOR ADDITIONAL INFORMATION.
- CORNER METHOD OF RE-ESTABLISHMENT OR REMONUMENTATION FOR CORNERS ORIGINALLY ESTABLISHED BY THE G.L.O.. E ~ ORIGINAL EVIDENCE
  - P ~ PROPORTIONATE METHOD BY SURVEY S ~ OTHER REGISTERED LAND SURVEYOR
- CORNER SEARCH ~ SEARCHED FOR NOT FOUND. **I** ] DISTANCE AND BEARING COMPUTED FOR SURVEY POSITION COMPARISON ONLY; NOT ADJUSTED FOR LATITUDINAL CURVE

ALONG TOWNSHIP LINE AND ASSUMING CORNERS T-9, V-9, X-9, AND Z-3 TO Z-15 ARE LOST.

RECORDATION

C. 5. 1123

RECEIVED AND FILED FEB 1 3 1990

RECORD MAP OF SURVEY NO. 1123