


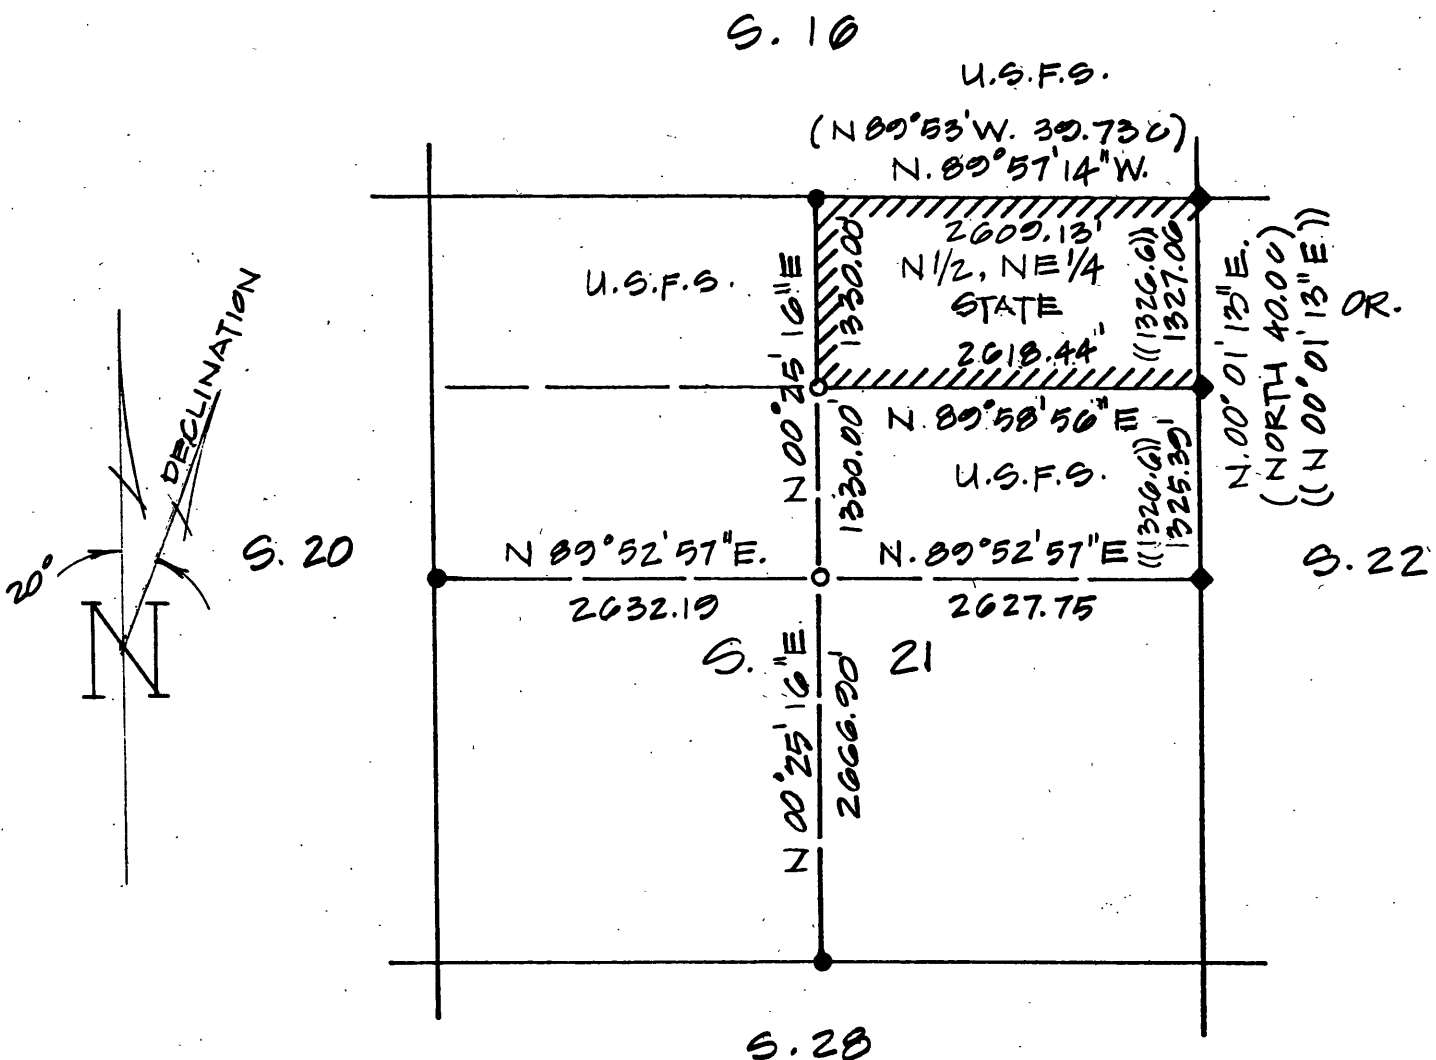


NOTES:

1. PREVIOUS SURVEYS.
A-THE G.L.O. SURVEY WAS DONE BY S.W. LACKLAND UNDER CONTRACT NO. 384, DATED MARCH 29, 1881
B-THE CORNERS FOUND ON THE EAST BOUNDARY OF SECTION 21 WERE MONUMENTED AS PART OF GRANT COUNTY SURVEY NO. 707 BY CHARLES PALMER, P.L.S. 1207, IN 1981.
2. THE BEARINGS ARE BASED ON GRANT COUNTY SURVEY NO. 707.
3. SEE "SURVEY NARRATIVE" AND THE "CERTIFIED RECORDS OF LAND CORNER MONUMENTATION" FILED AS PART OF THIS SURVEY FOR FUTURE INFORMATION.
4. THE FIELD BOOK IS ON FILE IN THE OFFICE OF M.A. PALMER AND SONS INC.

LEGEND:

- ALUM. CAP. FOUND
- G.L.O. CORNER FOUND, SET ALUM. CAP
- CORNER ESTABLISHED, SET ALUM. CAP
- ////// FOREST BOUNDARY POSTED
- U.S.F.S. U.S.F.S. LANDS
- STATE STATE OF OREGON LANDS
- () G.L.O., DATA OF RECORD
- (()) GRANT COUNTY SURVEY NO. 707, DATA OF RECORD.
- CHAINS, 1 C. = 66 FT.

SHEET INDEX	
NO.	TITLE
1	SURVEY PLAT
2	COR. RECORDS, CERT. APPROVALS, RECORDATION

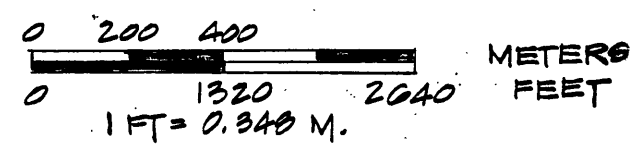

REGISTERED PROFESSIONAL LAND SURVEYOR <i>Chris T. Palmer</i> OREGON SEPTEMBER 23, 1977 CHRIS T. PALMER 1288	FORKS CADASTRAL SURVEY "SHAKE" CONTRACT NO. 53-04KK-9-02475 SURVEY PLAT PORTION OF SEC. 21, T15S, R28E, W.M., GRANT COUNTY, OREGON		
	Scale: 1" = 1320'	Date: SEPT. 1989	Job: 1184
	Dsn:	M.A. PALMER & SONS, INC. ENGINEERING & SURVEYING 254 N. Alder - Box 61 Burns, Oregon 97720	
	Drm: CTP.	Sht. No. 1	
Ckd: CTP.	of 2		

MOS #1176