


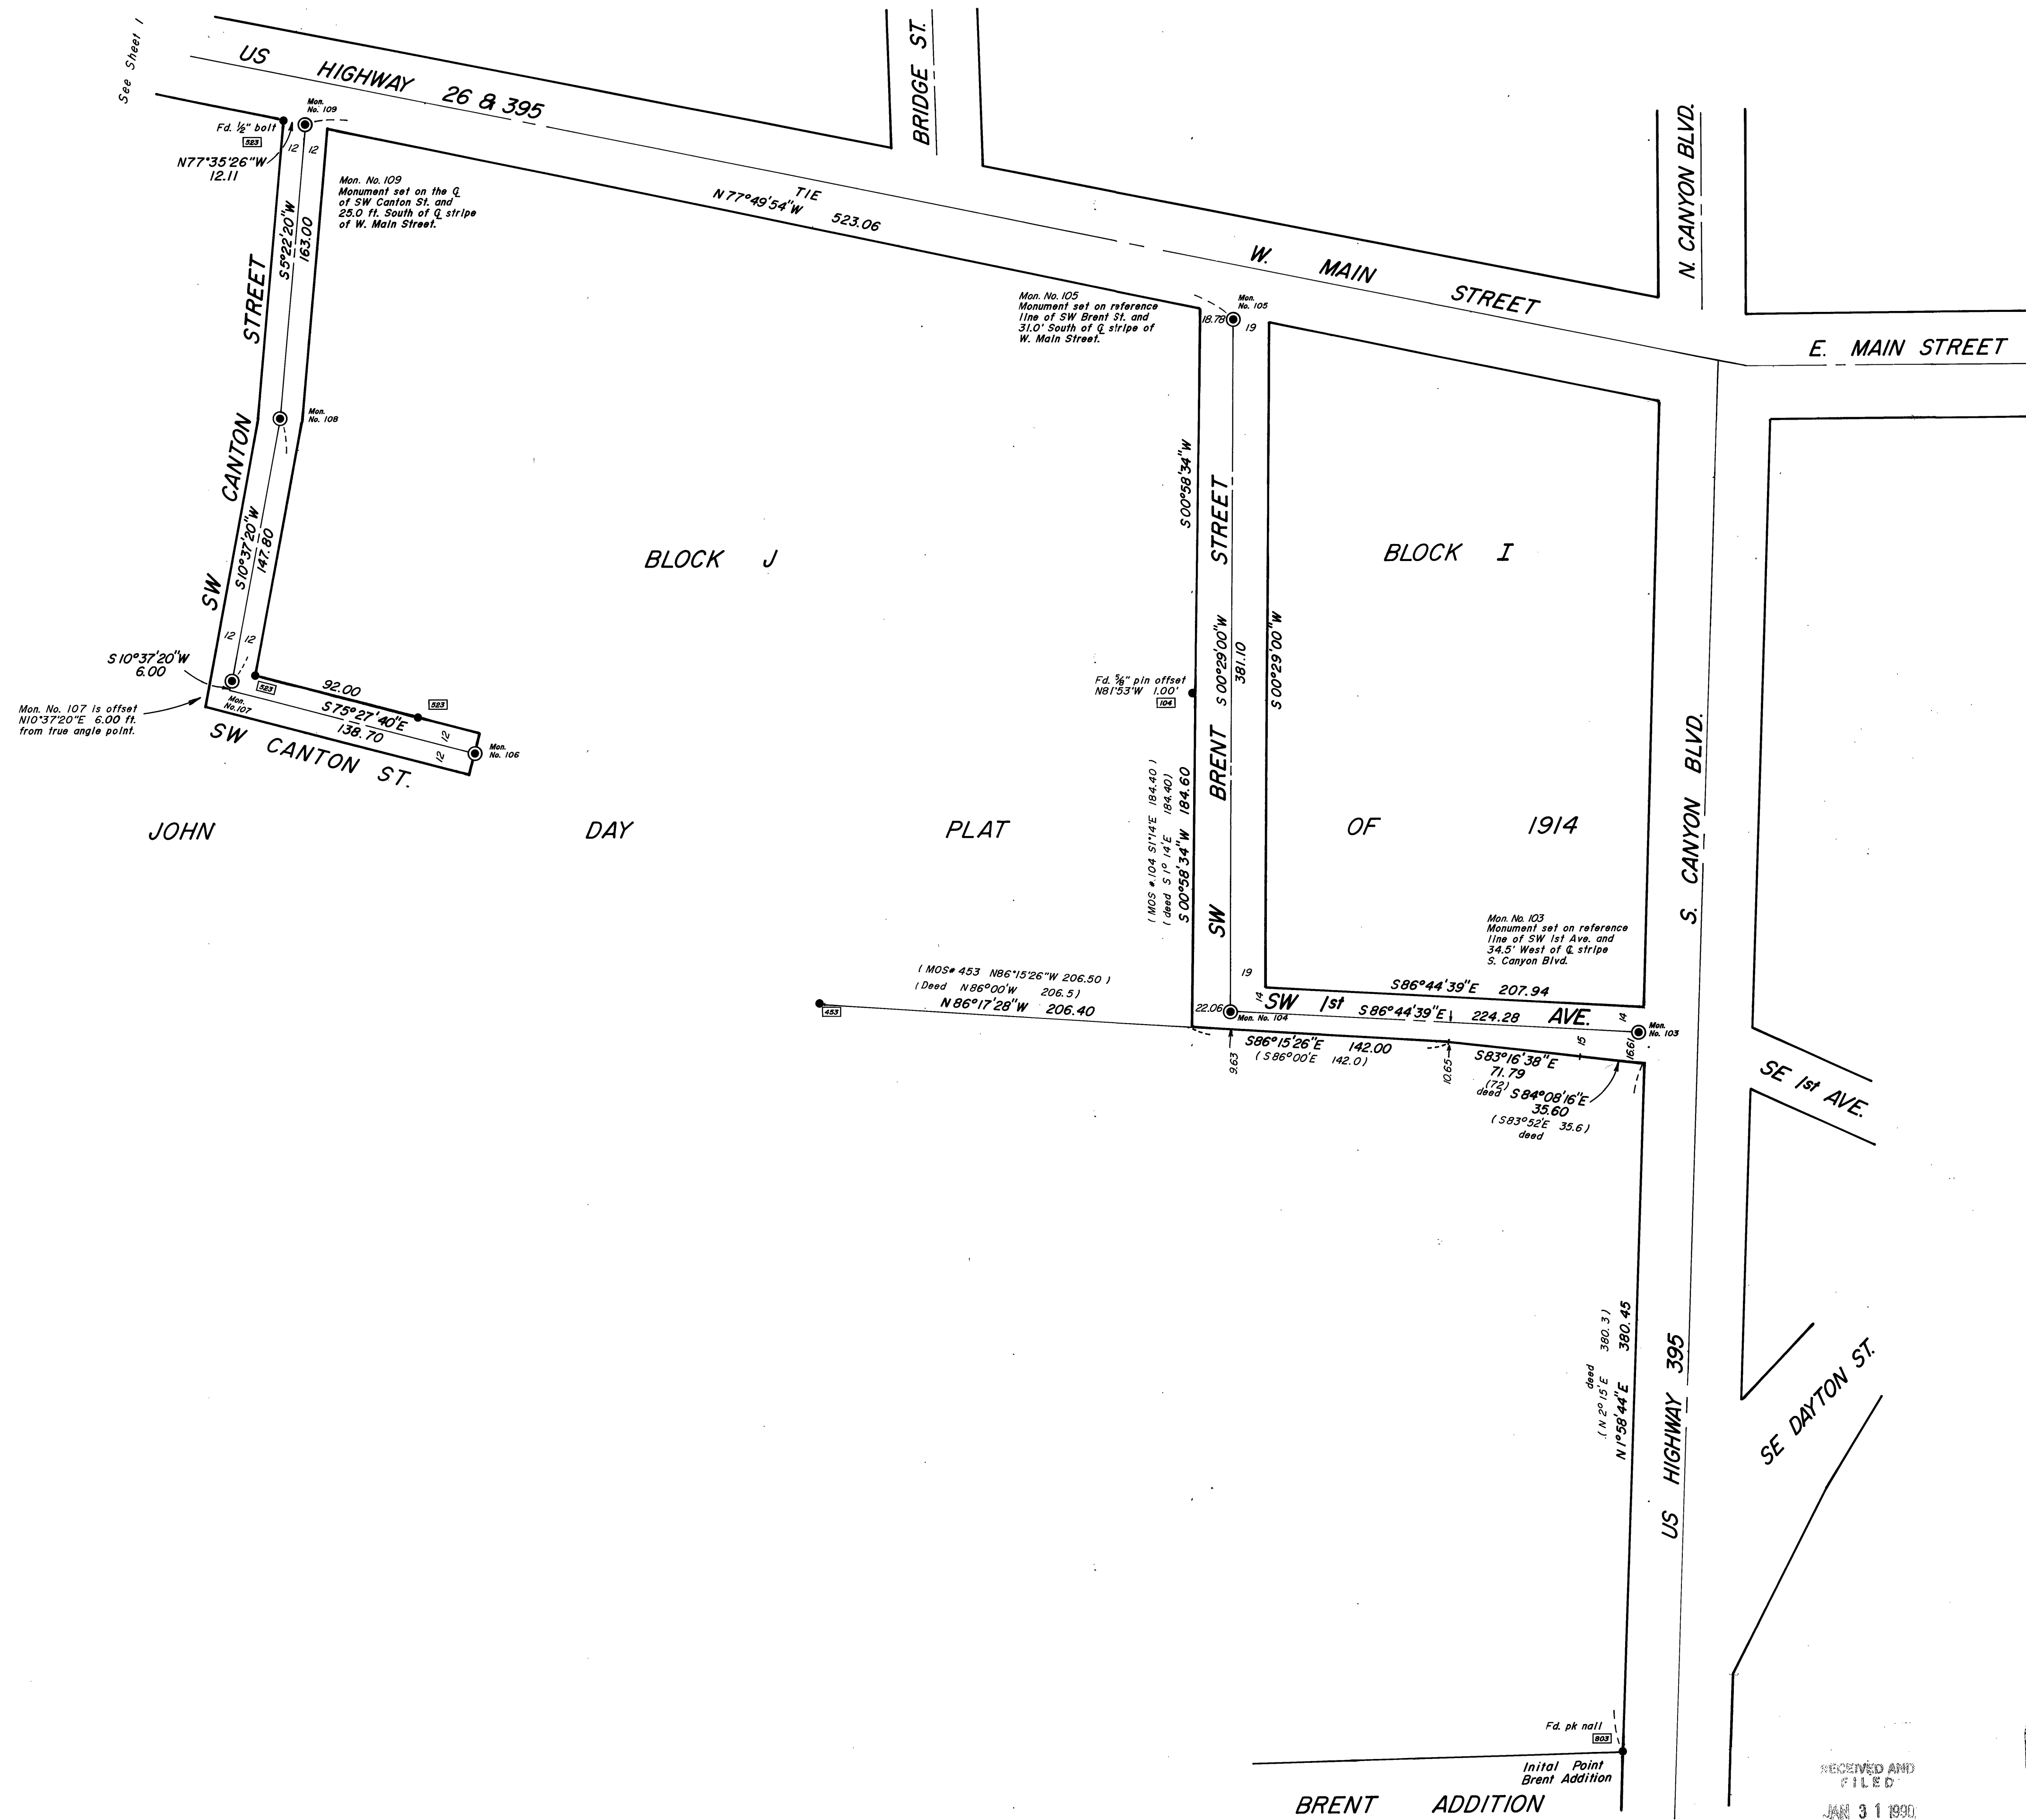

BASIS OF BEARINGS
SOLAR OBSERVATION

SHEET 2 OF 5

REGISTERED
PROFESSIONAL
LAND SURVEYOR
ROBERT D. BAGETT
598

RECEIVED AND
FILED
OFFICE OF COUNTY SURVEYOR
JOHN DAY, OREGON

BAGETT - GRIFFITH & ASSOCIATES John Day, Oregon		
MAP OF SURVEY OF SW JOHN DAY STREET MONUMENTATION PROJECT SITUATED IN THE NW1/4, NE1/4, NW1/4 OF SEC. 26; AND NE1/4 OF SEC. 27, T13S, R31E, W.M. CITY OF JOHN DAY GRANT COUNTY, OREGON		
SURVEYED FOR	CITY OF JOHN DAY	
SURVEYED BY	R.D.B. & J.L.W.	Jan. 1989
Scale: 1" = 50'	Drawn by: J.L.W.	1899 Dec. 1989

RECORD MAP OF SURVEY NO. 1129