


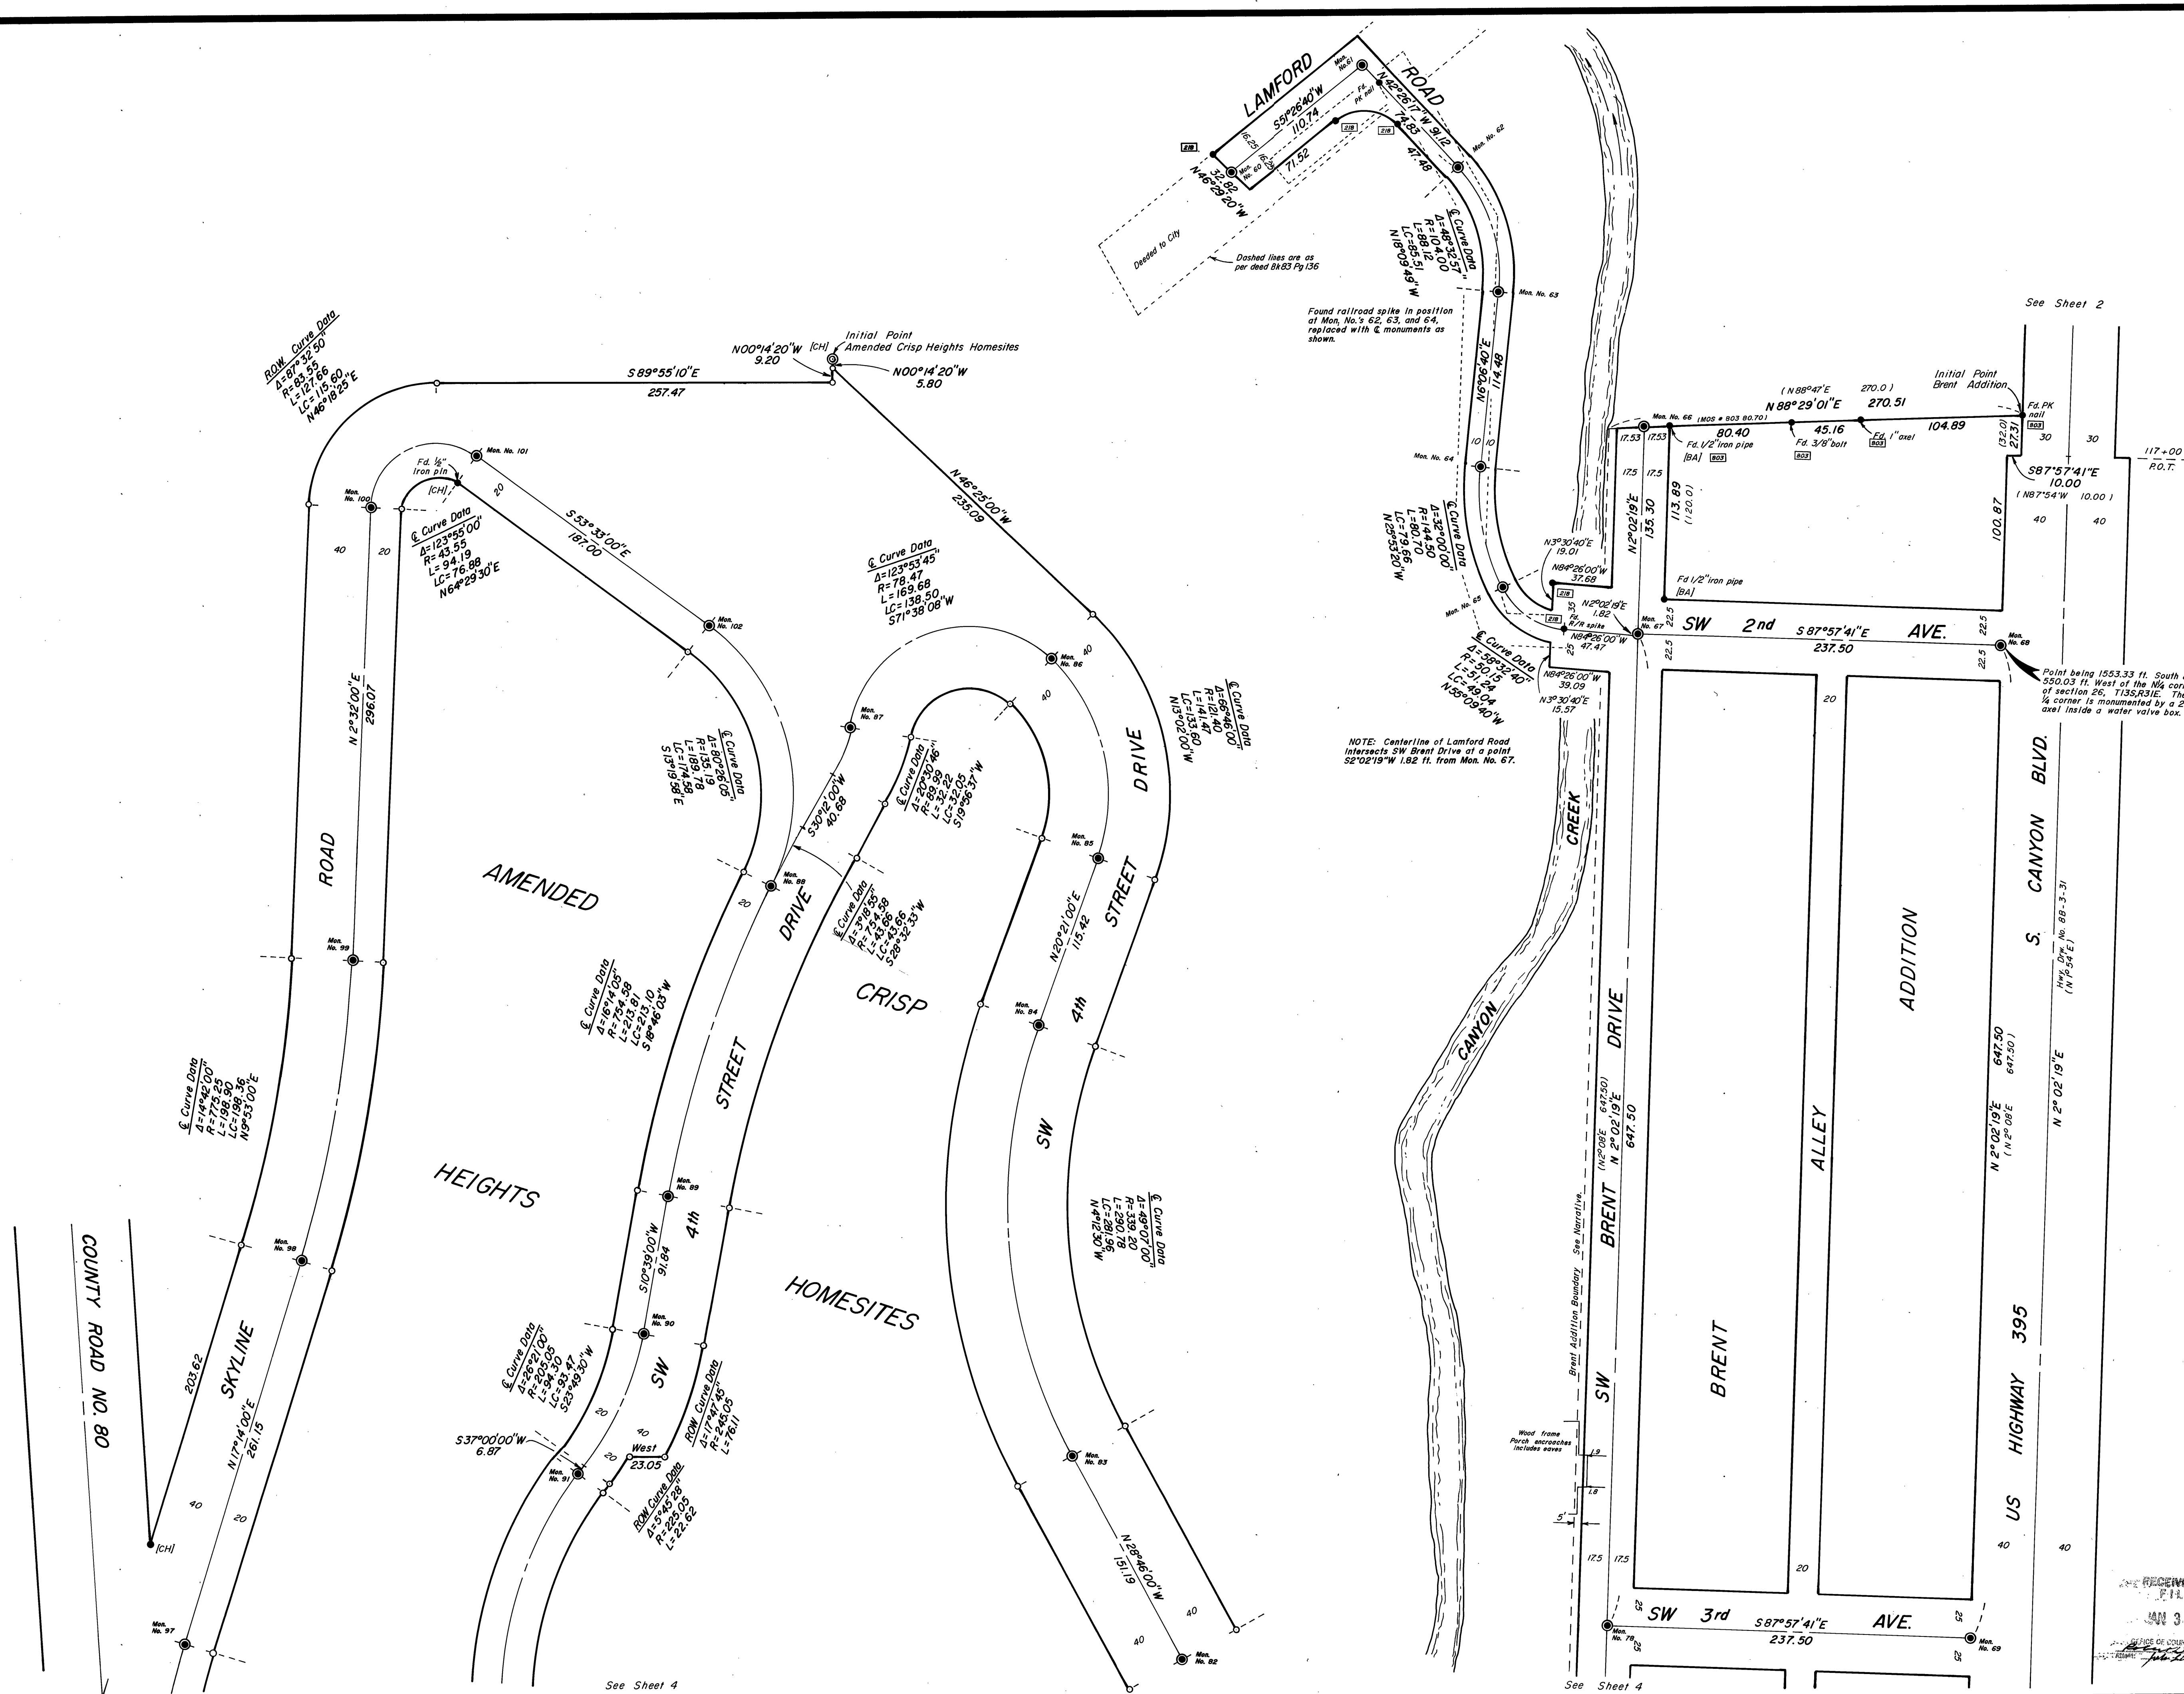

BASIS OF BEARINGS
SOLAR OBSERVATION

REGISTERED
PROFESSIONAL
LAND SURVEYOR
Robert D. Baggett
OREGON
JULY 12, 1983
ROBERT D. BAGGETT
598

SHEET 3 OF 5

BAGETT - GRIFFITH & ASSOCIATES		
John Day, Oregon		
MAP OF SURVEY		
OF SW JOHN DAY STREET MONUMENTATION PROJECT		
SITUATED IN THE NW1/4, NE1/4, NW1/4 OF SEC. 26;		
AND NE1/4, NW1/4 OF SEC. 27, T13S, R31E, W.M.		
CITY OF JOHN DAY		
GRANT COUNTY, OREGON		
SURVEYED FOR	CITY OF JOHN DAY	
SURVEYED BY	R.D.B. & J.L.W.	
Scale: 1" = 50'	Drawn by: J.L.W.	Jan. 1989

RECORD MAP OF SURVEY NO. 1129