


See Sheet 3

See Sheet 3

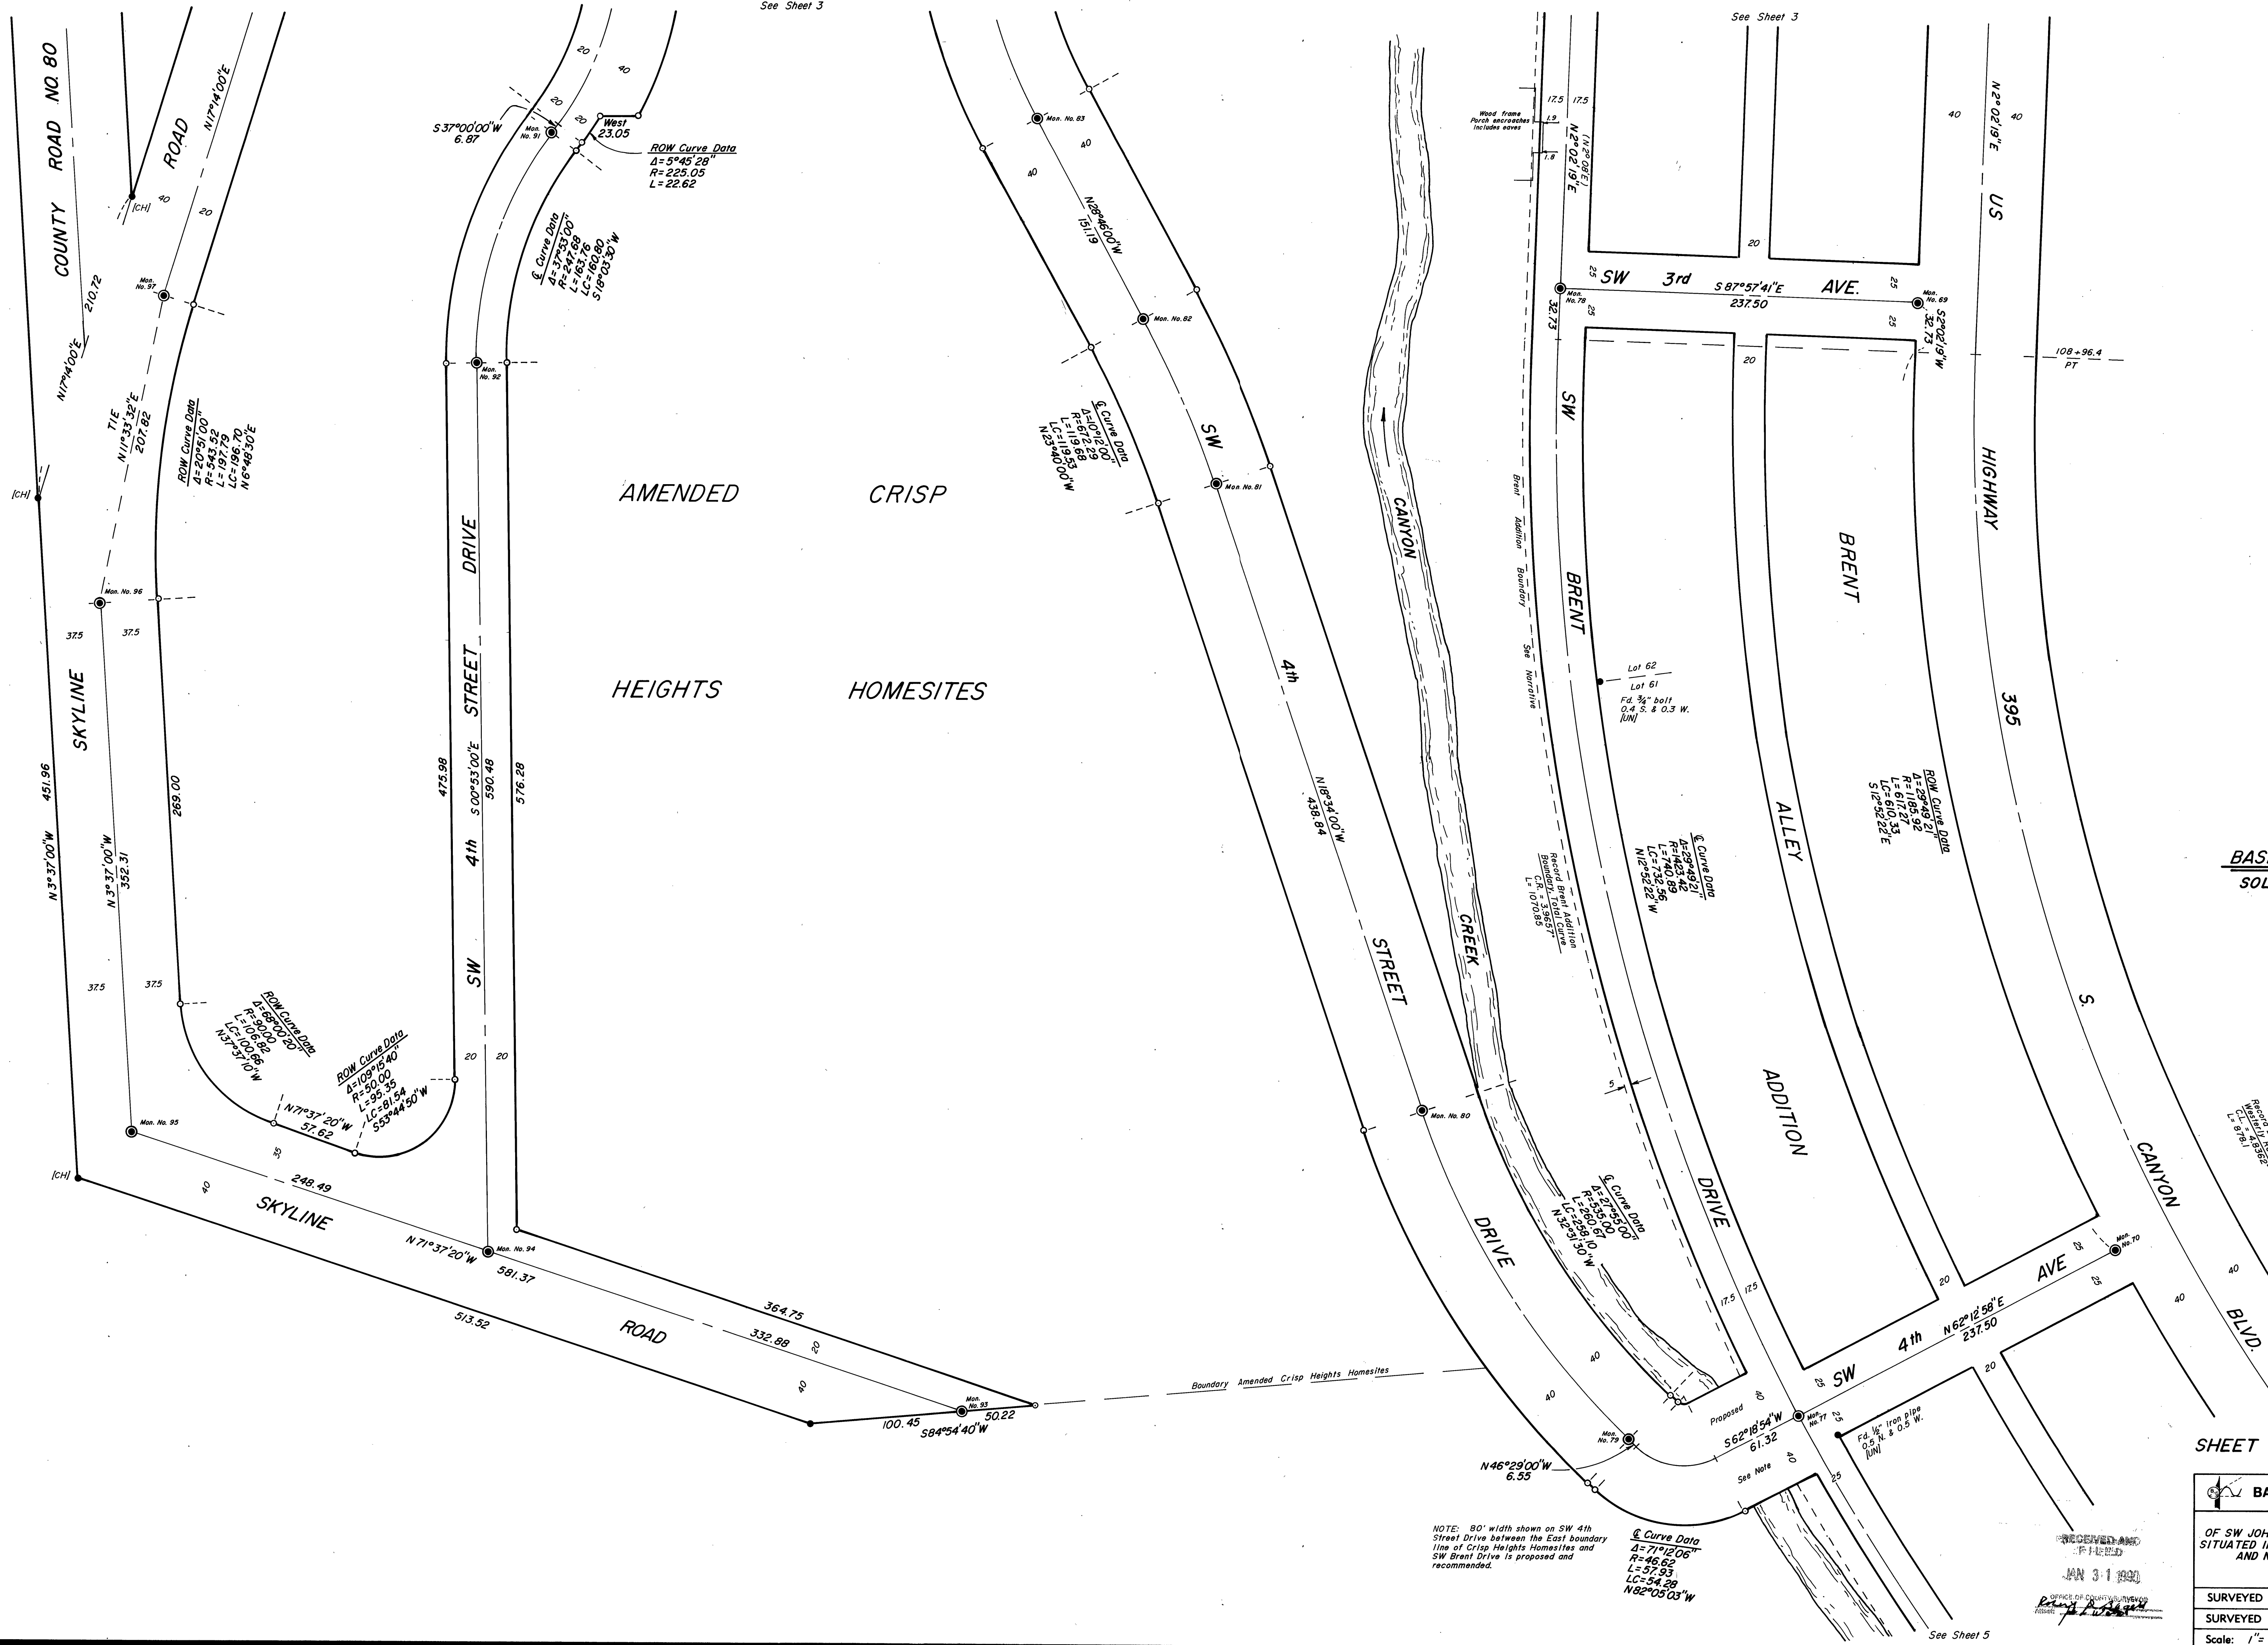

BASIS OF BEARINGS
SOLAR OBSERVATION

REGISTERED
PROFESSIONAL
LAND SURVEYOR
ROBERT D. BAGETT
JULY 12, 1943
598

SHEET 4 OF 5

BAGETT - GRIFFITH & ASSOCIATES John Day, Oregon		
MAP OF SURVEY OF SW JOHN DAY STREET MONUMENTATION PROJECT SITUATED IN THE NW 1/4 SEC. 26, N 1/2 SEC. 27, T13S, R31E, W.M. CITY OF JOHN DAY GRANT COUNTY, OREGON		
SURVEYED FOR	CITY OF JOHN DAY	
SURVEYED BY	R.D.B. & J.L.W.	Jan. 1989 thru Dec. 1989
Scale: 1" = 50'	Drawn by: J.L.W.	

RECORD MAP OF SURVEY NO. 1129