


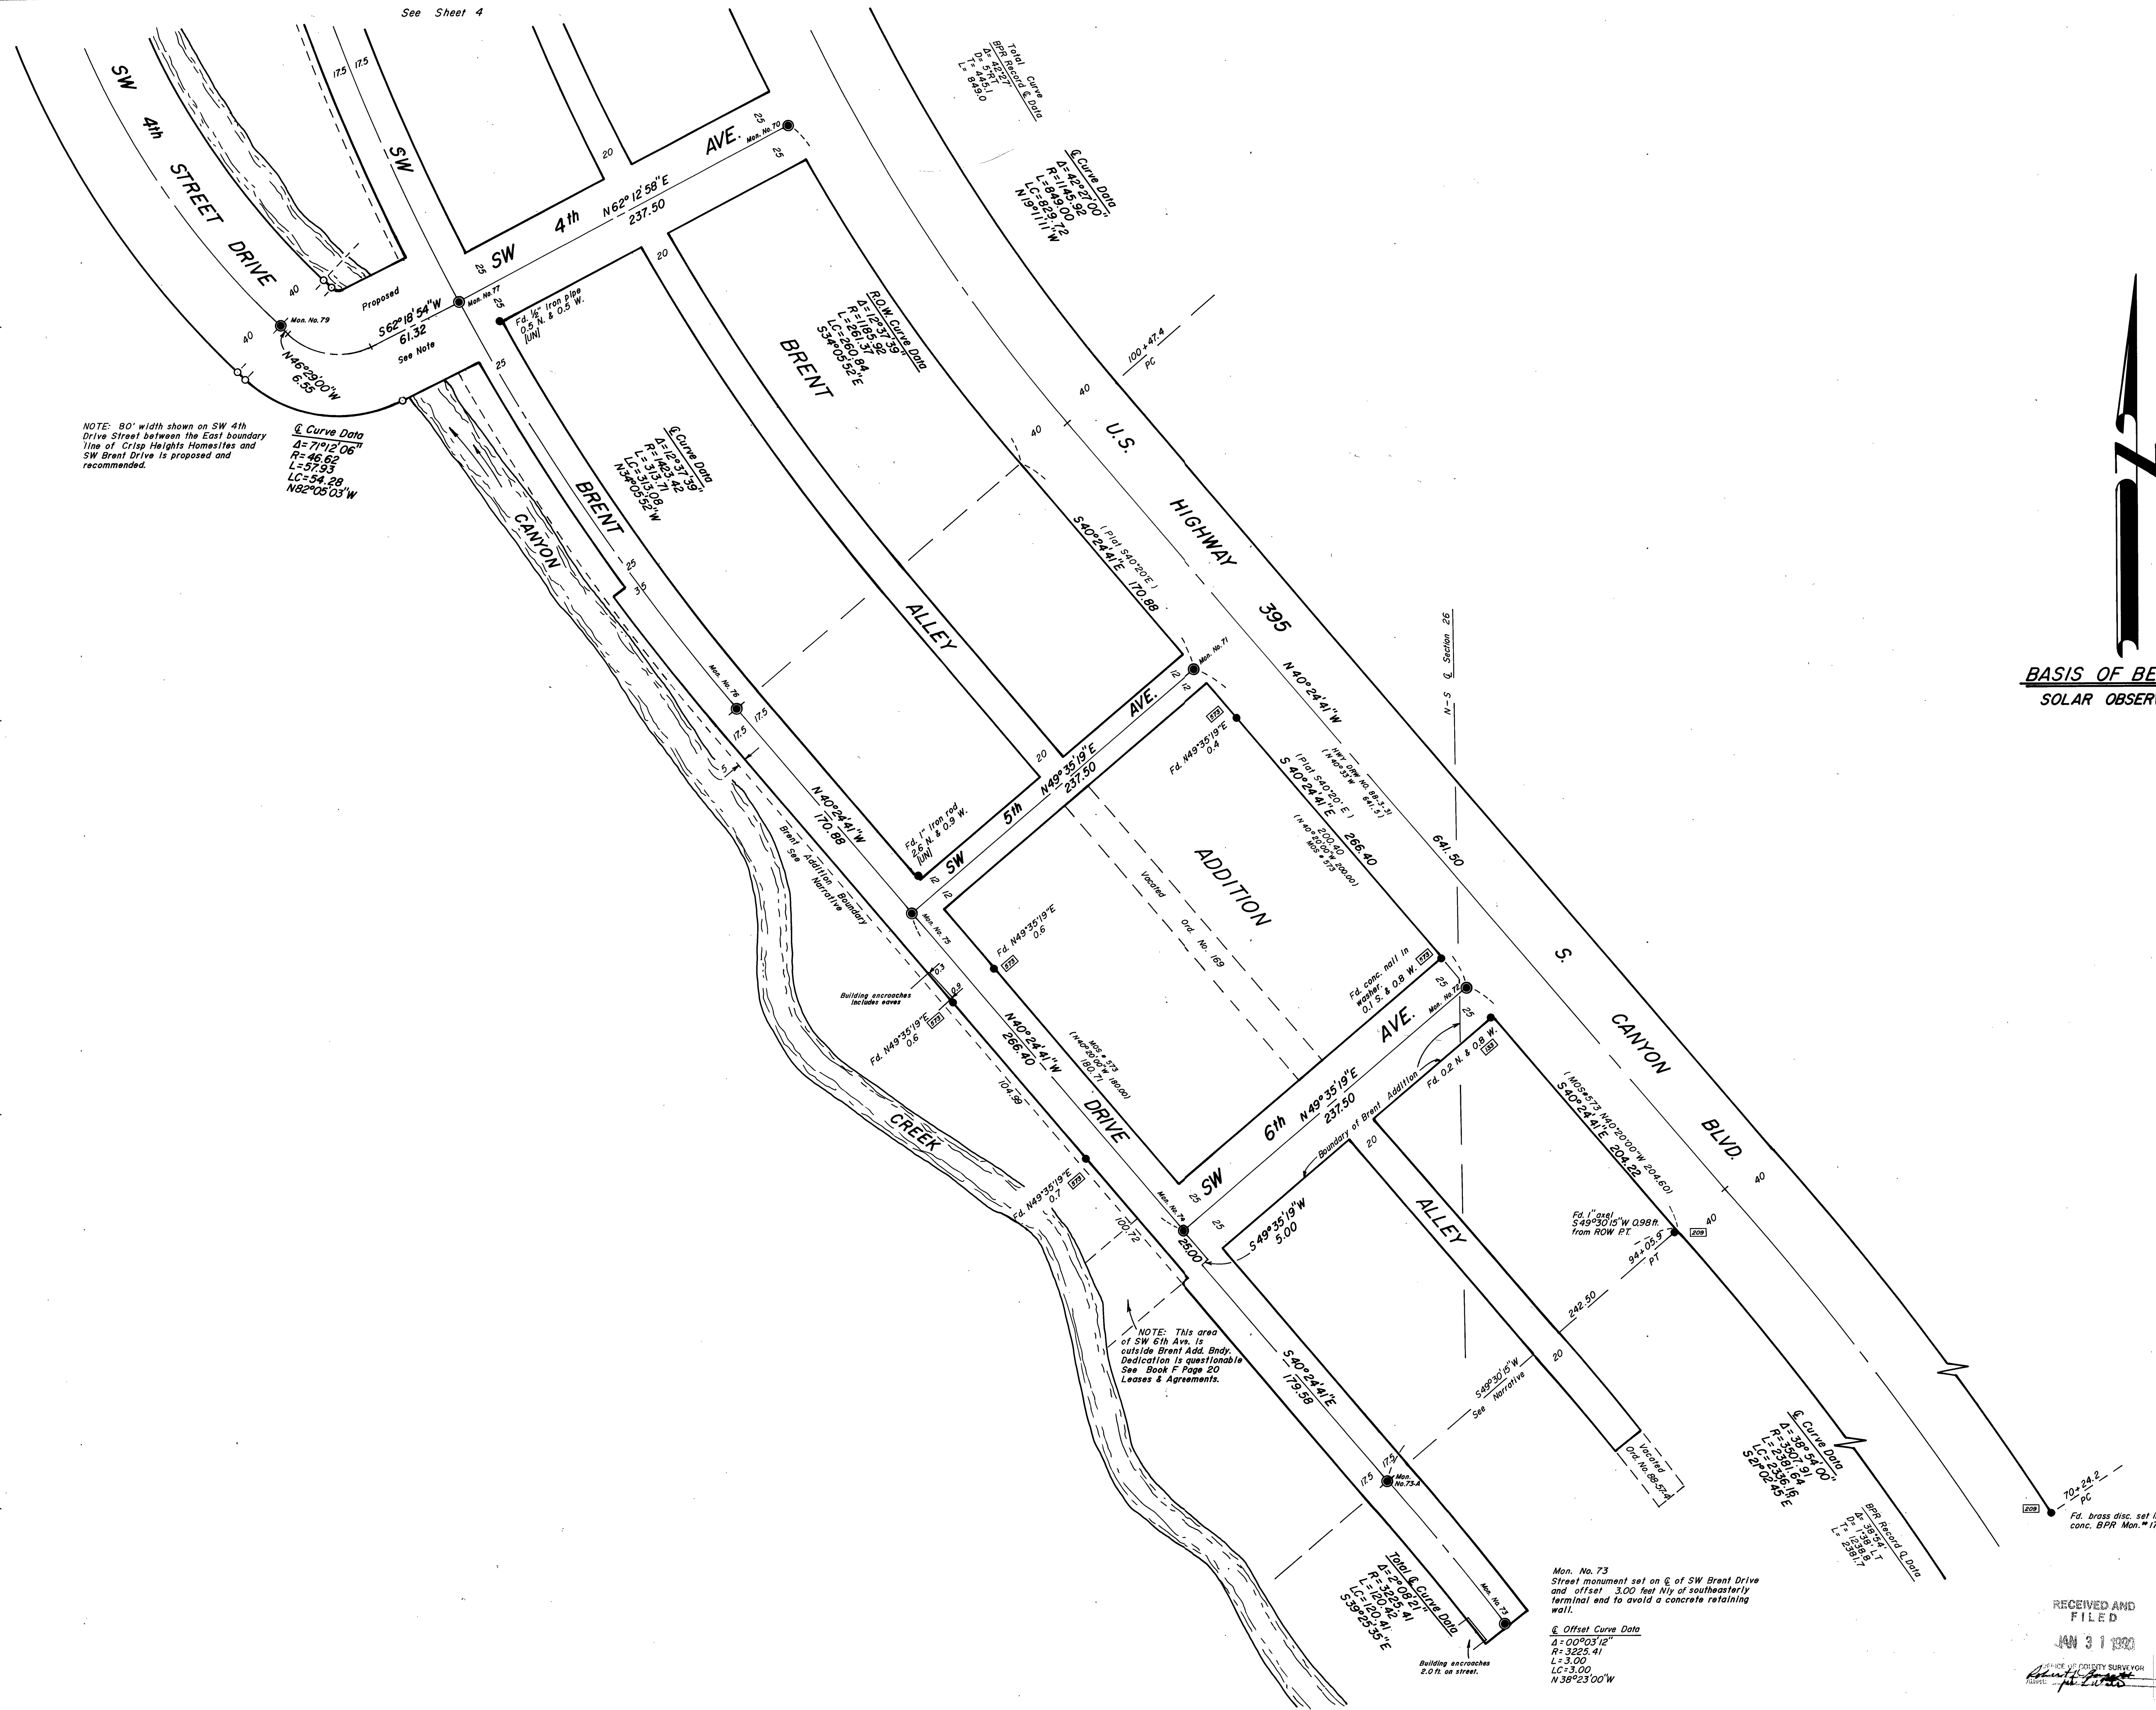

BASIS OF BEARINGS
 SOLAR OBSERVATION

REGISTERED
 PROFESSIONAL
 LAND SURVEYOR
 OREGON
 JULY 15, 1944
 ROBERT D. BAGETT
 598

SHEET 5 OF 5

BAGETT - GRIFFITH & ASSOCIATES John Day, Oregon	
MAP OF SURVEY OF SW JOHN DAY STREET MONUMENTATION PROJECT SITUATED IN THE NW1/4, NE1/4, NW1/4 OF SEC. 26; AND NE1/4, NE1/4 OF SEC. 27, T13S, R31E, W.M. CITY OF JOHN DAY	
GRANT COUNTY, OREGON	
SURVEYED FOR	CITY OF JOHN DAY
SURVEYED BY	R.D.B. & J.L.W.
Scale: 1" = 50'	Drawn by: J.L.W.
JAN 31 1989 RECEIVED AND FILED GRANT COUNTY SURVEYOR	